

**From:** VTA Board Secretary

**Sent:** Tuesday, February 16, 2021 4:06 PM

**To:** VTA Board Secretary

**Subject:** VTA Information: EBRC Third Addendum to the Final Second Supplemental EIR

**VTA Board of Directors and the Eastridge to BART Regional Connector Policy Advisory Board Members:**

The Santa Clara Valley Transportation Authority (VTA) has prepared a Final Third Addendum to the Final Second Supplemental Environmental Impact Report (Final SEIR-2) for the Eastridge to BART Regional Connector Project (EBRC). The Project will extend light rail along Capitol Expressway between the existing Alum Rock Light Rail Station and Eastridge Transit Center in the City of San José. The Final Third Addendum (8 KB) is attached to this email.

The Third Addendum evaluates the removal of an additional 60 – 70 trees along the east side of Capitol Expressway between Ocala Avenue and Quimby Road. The removal of additional trees is a result of new information that trees above a certain height under high voltage electric lines are required to be cleared for public safety reasons and to provide access to the lines for maintenance and repairs. All trees removed by the Project will be replaced at ratios determined by their size and replacement species (i.e., native versus non-native). In the Second Addendum to the Final SEIR-2 approved in February 2020, the VTA Board approved the payment of in-lieu fees to replace trees within two miles of the project corridor to the maximum extent practicable given the limited right-of-way available for tree replacement within the project limits. According to a tree inventory conducted by a certified arborist, the Project will be required to provide an additional 67 – 128 replacement trees depending on the replacement species (i.e., native versus non-native).

On February 18, 2021, the Congestion Management Program and Planning (CMPP) Committee will make a recommendation to the Board regarding the adoption of the Third Addendum and approval of the proposed change to the Project. On March 4, 2021, the VTA Board of Directors will consider adoption of the Third Addendum and approval of the proposed change to the Project. The agenda and zoom link for these meetings can be found at <http://santaclaravta.iqm2.com/Citizens/default.aspx> .

Notice of the Third Addendum has been emailed to the environmental mailing list for the EBRC project and the two affected private property owners.

If you have any questions about the Third Addendum, please feel free to contact Christina Jaworski, Senior Environmental Planner, at [Christina.Jaworski@vta.org](mailto:Christina.Jaworski@vta.org) .

Thank you.

Office of the Board Secretary  
Santa Clara Valley Transportation Authority  
3331 North First Street, Building B  
San Jose, CA 95134-1927  
Phone [408-321-5680](tel:408-321-5680)



Conserve paper. Think before you print.

---

# **Eastridge to BART Regional Connector**

## **Third Addendum to the Final Second Supplemental Environmental Impact Report**

**State Clearinghouse #2001092014**

**Prepared by:**

Santa Clara Valley Transportation Authority  
Environmental Programs and Resources Management  
3331 North First Street, Building B-2  
San José, CA 95134-1927

**Contact:**

Christina Jaworski, Senior Environmental Planner  
Phone: (408) 321-5751

**February 2021**

---

---

## Section 1 Introduction

### 1.1 Purpose of the Addendum

The California Environmental Quality Act (CEQA) recognizes that between the date projects are approved and the date they are constructed one or more of the following changes may occur: 1) the scope of the project may change, 2) the environmental setting in which the project is located may change, 3) certain environmental laws, regulations, or policies may change, and 4) previously unknown information may be identified. CEQA requires that lead agencies evaluate these changes to determine whether or not they are significant.

The mechanism for assessing the significance of these changes is found in CEQA Guidelines Sections 15162 - 15164. Under these Guidelines, a lead agency should prepare a subsequent or supplemental CEQA document if the triggering criteria set forth in CEQA Guidelines Section 15162 and 15163 are met. These criteria include a determination whether any changes to the project, or the circumstances under which the project will be undertaken, involve new significant environmental effects or a substantial increase in the severity of previously identified significant effects. In addition, a subsequent or supplemental CEQA document may be prepared if "new information" meeting certain standards under Guidelines Section 15162 is presented. If the changes do not meet these criteria, or if no "new information of substantial importance" is presented, then an Addendum per CEQA Guidelines Section 15164 is prepared to document any minor corrections to the Environmental Impact Report (EIR) or Initial Study/Mitigated Negative Declaration (MND). CEQA does not require that an Addendum be circulated for public review.

As discussed in Section 3 of this document, the implementation of the project change described in Section 2 will not result in new significant environmental effects or a substantial increase in the severity of previously identified significant effects. Therefore, the preparation of a Supplemental EIR, as defined by CEQA, is not warranted and an Addendum is the appropriate environmental document.

### 1.2 Overview of the Eastridge to BART Regional Connector Project

The Eastridge to BART Regional Connector (EBRC) Project will extend light rail along Capitol Expressway between the existing Alum Rock Light Rail Station and Eastridge Transit Center, a distance of approximately 2.4 miles. Light rail will operate primarily in the median of Capitol Expressway within exclusive and semi-exclusive rights-of-way. To provide the additional right-of-way to accommodate light rail, high-occupancy vehicle lanes will be removed between Story Road and Tully Road. The Project will include new light rail stations at Story Road (aerial) and Eastridge Transit Center (at-grade). The Project will also include traction power substations at Ocala Avenue and Eastridge Transit Center. Relocation and replacement of a number of 115-kilovolt steel lattice electrical transmission towers with Tubular Steel Poles (TSP) will be required for the Project.

---

Figure 1 shows the location of the EBRC Project.

### **1.3 Previous Environmental Studies**

The federal and state environmental process for the Capitol Expressway Light Rail (CELR) Project was initiated in September 2001 with the publishing of a Notice of Intent to prepare an Environmental Impact Statement (EIS) in the federal register and the filing of the Notice of Preparation of an EIR with the State Clearinghouse. A Draft EIS/EIR was circulated in April 2004, but only a Final EIR was completed as a result of limited opportunities for securing federal funds.

In May 2005, the VTA Board of Directors certified the Final EIR (hereafter referred to as the “2005 Final EIR”) and approved the Light Rail Alternative. As a result of preliminary engineering, the Light Rail Alternative was modified to address agency comments, improve operations, minimize right-of-way acquisition, and lower costs. To address these modifications, VTA prepared a Final Supplemental EIR (Final SEIR). The VTA Board of Directors certified the Final SEIR and approved the modifications to the Project in August 2007 (hereafter referred to as the “2007 Final SEIR”).

Due to unprecedented declines in revenues beginning in 2008, the implementation plan for the Light Rail Alternative was modified to construct the Project in phases. A Revised Addendum to the 2007 Final SEIR was approved in June 2010 that included the installation of pedestrian and bus improvements as Phase 1 and the extension of light rail along Capitol Expressway as Phase 2.

In addition to the state environmental process, VTA reinitiated the federal environmental process on September 9, 2009, with a Notice of Intent to prepare a Supplemental Draft EIS. The Supplemental Draft EIS was circulated on May 18, 2012, for 45 days with comments due on July 3, 2012. The federal environmental process under the National Environmental Policy Act (NEPA) was suspended in 2017 as a result of limited opportunities for securing federal funds.

A Subsequent Initial Study (IS)/Mitigated Negative Declaration (MND) was approved in March 2014 (hereafter referred to as the “2014 Subsequent IS/MND”) that eliminated the Ocala Station, eliminated sidewalk widening and sound wall relocation north of Ocala Avenue, and expanded the Eastridge Park-and-Ride lot.

A Second Supplemental EIR (SEIR-2) and Second Subsequent IS was approved in June 2019 (hereafter referred to as the “2019 Final SEIR-2”) to address major changes to the Project as well as incorporate changed circumstances and new information.

A Second Addendum evaluated six design changes as a result of advances in engineering and electrical designs. This Addendum was approved in February 2020.

---

## **1.4 Scope of the Third Addendum**

The Third Addendum evaluates the additional removal of 60 – 70 trees along the east side of Capitol Expressway between Ocala Avenue and Quimby Road as a result of the relocation of a number of PG&E electrical transmission towers to clear the right-of-way for the Project. This modification is described in more detail in Section 2. The Third Addendum will describe the effects of the change to the Project on the environmental setting, impacts, and mitigation measures.

---

## Section 2 Proposed Change to the Project

This section describes the proposed change to the Project since the approval of the prior environmental documents.

After the approval of the Final SEIR-2 in June 2019, VTA is proposing a minor change to the Project as a result of new information regarding the relocation of a number of PG&E electrical transmission towers along the east side of Capitol Expressway between Ocala Avenue and Quimby Road. The relocation of these electrical transmission towers is needed to clear the right-of-way for the Project. The relocation of the electrical transmission towers is scheduled to begin in Spring 2021.

Approximately 60 – 70 trees that are located within the aerial easement of the electrical transmission lines will need to be removed per PG&E’s Electric and Gas Service Requirements 2020-21 (Greenbook). Trees of certain height under high voltage electric lines are required to be cleared for public safety reasons and to provide access to the lines for maintenance and repairs. South of Ocala Avenue and north of Tully Road, there are approximately 35 trees located in the public right-of-way that will need to be removed. North of Tully Road, there are approximately 8 trees located on private property that will need to be removed. South of Tully Road, there are approximately 18 trees located on private property that will need to be removed (See Appendix A for Excerpt from Addendum to the Tree Inventory Report). The Third Addendum evaluates the potential for additional trees besides the 61 mentioned to be removed for the Project.

The additional removal of approximately 60 – 70 trees increases the total number of trees to be removed by the Project from 150 to between 210 – 220 trees (See Appendix B for Excerpt from the 2019 Tree Inventory).

As indicated in previous environmental documents, all trees removed by the Project will be replaced at ratios determined by their size and replacement species (i.e., native versus non-native). In the Second Addendum to the Final SEIR-2 approved in February 2020, the VTA Board approved the payment of in-lieu fees to replace trees within two miles of the project corridor to the maximum extent practicable given the limited right-of-way available for tree replacement within the project limits. These in-lieu fees are currently \$750 per tree per the City of San Jose’s Guidelines for Inventorying, Evaluating, and Mitigating Impacts to Landscaping Trees in the City of San Jose. According to a tree inventory conducted by a certified arborist, the Project will be required to provide an additional 67 – 128 replacement trees depending on the replacement species (i.e., native versus non-native). In terms of in-lieu fees, this amounts to \$50,250 - \$96,000 for the additional trees based on a fee of \$750 per tree. This brings the total number of trees that will be replaced by the Project to 222 – 414 depending on the replacement species.

---

## Section 3 Environmental Setting, Impacts, and Mitigation

### 3.1 Transportation

This section evaluates the potential for transportation impacts from the removal of additional trees due to relocation of PGE electric transmission lines along the east side of Capitol Expressway between Ocala Avenue and Quimby Road. The tree removal will require temporary lane closures along Capitol Expressway. As required by Mitigation Measure TRN(CON)-2a (Prepare Traffic Management Plan) from the 2005 Final EIR, PGE will prepare traffic handling plans, employ traffic flaggers, and endeavor to minimize peak hour delays to all users. Consequently, the removal of additional trees would not result in new significant environmental effects or a substantial increase in the severity of previously identified significant effects related to transportation.

### 3.2 Air Quality

This section evaluates the potential for air quality and climate change impacts. The Project is located within the San Francisco Bay Area Air Basin. The air pollutants of greatest concern in this area are ozone, particulate matter less than or equal to 2.5 microns in diameter (PM<sub>2.5</sub>), particulate matter less than or equal to 10 microns in diameter (PM<sub>10</sub>), and carbon monoxide (CO). Motor vehicles are the dominate source of these pollutants. Trees can directly and indirectly affect air quality by reducing temperatures, removing air pollution, and generating tree-related maintenance emissions. As they grow, plants and trees can also take carbon dioxide from the atmosphere and turn it into sugars through photosynthesis. As a result, plants and trees help improve air quality and limit global warming. While the Project would be removing 60 – 70 additional trees, the Project would be planting 67 – 128 replacement trees which would minimize the effect on air quality and climate change. As a result, the change to the Project would not result in new significant environmental effects or a substantial increase in the severity of previously identified significant effects related to air quality.

### 3.3 Biological Resources

This section evaluates the potential for impacts to biological resources from the removal of additional trees along the east side of Capitol Expressway between Ocala Avenue and Quimby Road. Mitigation Measure BIO-18b (Replace Trees) from the 2005 Final EIR states that:

All urban trees that are to be removed or lost shall be replaced. Trees with a diameter less than 12 inches shall be replaced at a 2:1 ratio. All trees with a diameter of 12 inches or more shall be replaced at a 3:1 ratio. If urban trees (nonnatives and ornamentals) are replaced with native trees, a reduced mitigation ratio of 1:1 for all trees smaller than 12 inches in diameter, and 2:1 for all trees with a diameter 12 inches or more, shall be



---

implemented. These trees shall be irrigated and maintained for a period of not fewer than 3 years.

As the VTA Board of Directors approved in February 2020, VTA can fulfill this mitigation measure by contributing in-lieu fees to replace the trees outside of the Project limits. Because the trees would be replaced within two miles of the project corridor to the maximum extent practicable, the removal of 60 – 70 additional trees would not result in new significant environmental effects or a substantial increase in the severity of previously identified significant effects to biological resources.

### **3.4 Community Services**

This section evaluates the potential for impacts to community facilities (schools, fire stations, police stations, hospitals, libraries, civic/community centers, parks, religious institutions, and museums) from the removal of additional trees along the east side of Capitol Expressway between Ocala Avenue and Quimby Road. Since the removal of additional trees would not result in the provision or need for new or physically altered government facilities, the change to the Project would not result in any new significant environmental effects or a substantial increase in the severity of previously identified significant effects to community services.

### **3.5 Cultural Resources**

This section evaluates the potential for impacts to cultural resources from the removal of additional trees along the east side of Capitol Expressway between Ocala Avenue and Quimby Road. There are no known archaeological resources located within the approved Project limits, which includes the footprint for the additional tree removals. Similarly, no isolated remains, cemeteries, or archaeological resources that contain human remains have been identified within the Project limits. As such, the additional tree removals would not result in impacts to known archaeological resources (including human remains). However, a desktop geoarchaeological sensitivity analysis revealed that the Project footprint is underlain by landforms that have sensitivity for containing unknown buried archaeological resources. In case of an inadvertent discovery of buried cultural resources, standard practice, which is to stop work immediately, will be followed as described in Section 3.5 of the 2019 Final SEIR-2. In addition, there will be a Native American monitor required during construction involving subsurface excavation between Cunningham Avenue and Quimby Avenue. These requirements will apply to any subsurface excavation associated with the removal of the trees. With the inclusion of these standard practices and Native American monitoring, the additional tree removals would not result in any new significant environmental effects or a substantial increase in the severity of previously identified significant effects to cultural resources.

---

### **3.6 Electromagnetic Fields**

This section evaluates the potential for health effects from electromagnetic fields (EMF) from the removal of additional trees along the east side of Capitol Expressway between Ocala Avenue and Quimby Road. EMF is associated with electromagnetic radiation from natural and human-made sources (electronics, telecommunications, and other electrically powered devices). Since the removal of additional trees will not add new sources of EMF, a new significant environmental effect or a substantial increase in the severity of previously identified significant effect to EMF will not result from the change to the Project.

### **3.7 Energy**

This section evaluates the potential to place a substantial demand on the regional energy supply, require substantial additional capacity, or significantly increase peak and base period electricity demand. The removal of additional trees along the east side of Capitol Expressway would have minimal impact on energy supply, capacity, or demand. As a result, the change to the Project will not create a new significant environmental effect or a substantial increase in the severity of previously identified significant effects to energy resources.

### **3.8 Environmental Justice**

This section evaluates the potential for disproportionately high and adverse effects on minority and low income populations. The removal of additional trees along the east side of Capitol Expressway will have a visual effect on all populations that live and travel along the Capitol Expressway corridor, regardless of their minority or low income status. While VTA will replace trees within 2 miles of the Project corridor to the maximum extent practicable, the inability to replace trees within the Project corridor will have a visual effect. Since there will be other plantings within the Project corridor as required by Mitigation Measure VQ-4 (Incorporate Landscaping), the visual effect will be lessened. As a result, this change to the Project is not anticipated to cause a disproportionately high and adverse effect on minority and low income populations.

### **3.9 Geology, Soils and Seismicity**

This section evaluates the potential to increase the hazards related to geology, soils, and seismicity. The topography of the area is relatively flat. There are no significant or unique geologic conditions (e.g., faults, landslides, steep slopes, etc.) on or adjacent to the Capitol Expressway Corridor that would require special mitigation. Although the Project is located in a seismically active region, this fact applies to the greater Bay Area and is not unique to this site. The removal of additional trees along the east side of Capitol Expressway between Ocala Avenue and Quimby Road will not involve the construction of any large-scale structures and

---

facilities. As a result, the change to the Project will not cause a new significant environmental effect or a substantial increase in the severity of previously identified significant effects to geology, soils and seismicity.

### **3.10 Hazardous Materials**

This section evaluates the potential to encounter hazardous materials during the removal of additional trees along the east side of Capitol Expressway between Ocala Avenue and Quimby Road. While the tree removal would involve the grinding of stumps and the preservation of existing irrigation systems to the extent possible, these activities would not involve any subsurface excavation.

The 2020 *Preliminary Site Investigation and Hazardous Materials Evaluation* did not identify any concerns in the vicinity of the additional tree removals.

As a result, the change to the Project is not anticipated to create a new significant environmental effect or a substantial increase in the severity of previously identified significant effects from hazardous materials.

### **3.11 Hydrology and Water Quality**

This section evaluates the potential of the changes to the Project to affect existing flooding hazards, impair water quality, and create additional sources of runoff.

As with the approved Project, the changes to the Project are currently located within the 100-year flood hazard zone of Silver Creek. However, it is anticipated that the flood insurance maps will be updated with the completion of the Lower Silver Creek Flood Protection Project in December 2019, and that 3,800 parcels will no longer be required by law to purchase flood insurance.

Since the additional trees that will be removed along the east side of Capitol Expressway between Ocala Avenue and Quimby Road are contained within planters in the sidewalk, the risk of increased erosion and sedimentation to surface waters from tree removal is low. In addition, Mitigation Measure HYD-11 (Comply with All Applicable Regulations and Subsequent Permit Programs Related to Water Quality Control) identified in previous environmental documents would still apply to the change to the Project. With the inclusion of this mitigation measure, the change to the Project is not anticipated to create a new significant environmental effect or a substantial increase in the severity of previously identified significant effects related to hydrology and water quality.

---

### **3.12 Land Use**

This section evaluates the potential of the change to the Project to be incompatible with existing adjacent land uses or be inconsistent with applicable plans, programs and policies. According to Section 13.28.310 of the City of San Jose Municipal Code, interference with high tension electrical lines is one of the criteria under which the removal of street trees is allowed. As a result, the removal of additional trees along the east side of Capitol Expressway between Ocala Avenue and Quimby Road is not anticipated to create a new significant effect or a substantial increase in the severity of previously identified significant effects related to land use.

### **3.13 Noise and Vibration**

This section evaluates the potential of the change to the Project to result in noise or vibration impacts that would exceed criteria used by VTA and the Federal Transit Administration (FTA). Except for temporary construction noise, the removal of additional trees along the east side of Capitol Expressway between Ocala Avenue and Quimby Road is not anticipated to create a new significant environmental effect or a substantial increase in the severity of previously identified significant effects related to noise and vibration.

### **3.14 Safety and Security**

This section evaluates potential safety and security impacts associated with the change to the Project. The removal of additional trees along the east side of Capitol Expressway between Ocala Avenue and Quimby Road is not anticipated to create a new significant environmental effect or a substantial increase in the severity of previously identified significant effects related to safety and security.

### **3.15 Socioeconomics**

This section evaluates the potential for the change to the Project to negatively affect the population, household, and community characteristics of an area through physical divisions, disruption of efforts to economically revitalize the area, growth inducement, displacement of businesses and housing, and increased demand for housing. While the removal of an additional 60 – 70 trees along the east side of Capitol Expressway between Ocala Avenue and Quimby Avenue will have a visual effect on this section of the Capitol Expressway Corridor, it is not anticipated to create a new significant environmental effect or a substantial increase in the severity of previously identified significant effects related to socioeconomics.

---

### 3.16 Utilities

This section evaluates the potential for the change to the Project to affect utilities. The removal of additional trees along the east side of Capitol Expressway between Ocala Avenue and Quimby Road will have a beneficial effect on utilities by minimizing risks to public safety and ensuring access to the electric transmission lines for maintenance and repairs. This change to the Project will not cause a disruption in utility service for a period of 24 hours or more. As a result, the change to the Project will not create a new significant environmental effect or a substantial increase in severity of previously identified significant effects related to utilities.

### 3.17 Visual Quality

This section evaluates the potential to degrade the existing visual character and quality of the Project corridor, negatively affect scenic vistas, and introduce new sources of light and glare. The removal of additional trees along the east side of Capitol Expressway between Ocala Avenue and Quimby Road will have a negative effect on the visual environment since these trees are not able to be replaced in the project limits due to the presence of electrical transmission lines and the lack of available right-of-way. This negative effect will be lessened by the planting of other types of vegetation and landscaping as part of the Project as required by Mitigation Measure VQ-4 (Incorporate Landscaping). Any vegetation that is planted underneath the electrical transmission lines will need to be on the list of *Recommended Plants for Electric Transmission Towers* and meet VTA's Sustainable Landscaping Policy if on VTA property. As a result, the change to the Project is not anticipated to create a new significant environmental effect or a substantial increase in severity of previously identified significant effects related to visual quality.

### 3.18 Construction Impacts

This section evaluates the potential construction impacts associated with the change to the Project. With the inclusion of the following applicable mitigation measures related to construction activities from previous approved environmental documents, the change to the Project is not anticipated to result in a new significant environmental effect or a substantial increase in severity of previously identified significant effects related to construction.

Traffic: Mitigation Measures TRN (CON)-2a (Prepare Traffic Management Plan), TRN (CON)-2b (Inform Public of Traffic Detours), and TRN (CON)-2c (Inform Public of Transit Service Changes)

Air Quality: Mitigation Measures AQ (CON)-1 (BAAQMD's BMPs to reduce particulate matter emissions from construction activities) and AQ (CON)-2 (BAAQMD's BMPs to reduce GHG emissions from construction equipment) and AQ (CON)-3 use Tier 3 or Tier 4 equipment where possible.

---

Energy: Mitigation Measure E (CON)-1 (Adopt Energy Conservation Measures)

Hydrology and Water Quality: Mitigation Measure HYD (CON)-1 (Implement Water Quality Control Measures)

Safety and Security: Mitigation Measure SS (CON)-1 (Implement Construction BMPs to Protect Workers and the Public)

### **3.19 Cumulative Impacts**

This section evaluates the incremental effect of the change to the Project on the environment when considered in conjunction with closely related past, present, and reasonably foreseeable future projects. While the removal of additional trees along Capitol Expressway between Ocala Avenue and Quimby Road will result in a cumulative loss of 210 to 220 trees, these trees will be replaced within two miles of the Project corridor to the maximum extent practicable. As a result, it is not anticipated that the change to the Project will result in a new significant cumulative effect or a substantial increase in the severity of previously identified significant cumulative effects.

### **3.20 Growth-Inducing Impacts**

This section evaluates the potential of the design changes to directly or indirectly induce economic, population or housing growth in the surrounding environment. Given the relatively small scope and scale of the change to the Project, it is not anticipated to result in a new significant environmental effect or a substantial increase in the severity of previously identified significant effects as relates to growth inducement.

---

## Section 5 Conclusion

Based upon the evaluation of the change to the Project, it has been determined that there will be no new significant environmental effects nor substantial increases in the severity of any previously identified significant effects. Therefore, an Addendum is the appropriate environmental document.

---


## Section 6 References

- Columbia University. November 27, 2018. *Can Removing Carbon From the Atmosphere Save Us From Climate Catastrophe?* <https://blogs.ei.columbia.edu/2018/11/27/carbon-dioxide-removal-climate-change/>
- GeoCon Consultants, Inc. 2019. *Preliminary Site Investigation and Hazardous Materials Report*. March (Updated January 2020).
- Megan Richards. 2021. *Addendum to Tree Inventory for the Eastridge to BART Regional Connector*. January 29.
- Pacific Gas & Electric Company. *Recommended Plants for Electric Transmission Towers*.
- San Jose. 2013. *Tree Policy Manual & Recommended Best Practices*. <https://www.sanjoseca.gov/home/showdocument?id=2520>.
- Santa Clara Valley Transportation Authority. 2005. *Environmental Impact Report for the Capitol Expressway Corridor*. State Clearinghouse #2001092014. Final. April. (J&S 01-277.) San Jose, CA.
- Santa Clara Valley Transportation Authority. 2007. *Supplemental Environmental Impact Report for the Capitol Expressway Light Rail*. State Clearinghouse #2001092014. Final. April. (J&S 01-277.) San Jose, CA.
- Santa Clara Valley Transportation Authority. 2010. *Revised Addendum to the Supplemental Environmental Impact Report*. State Clearinghouse #2001092014. June.
- Santa Clara Valley Transportation Authority. 2014. *Subsequent Initial Study/Mitigated Negative Declaration*. State Clearinghouse #2001092014. February.
- Santa Clara Valley Transportation Authority. 2018. *Sustainable Landscaping Policy*.
- Santa Clara Valley Transportation Authority. 2019. *Final Second Supplemental Environmental Impact Report*.
- Santa Clara Valley Transportation Authority. 2020. *Second Addendum to the Final Second Supplemental Environmental Impact Report*. State Clearinghouse #2001092014. Final. January.
- Shawn Sanfilippo. 2019. *Tree Inventory for the Eastridge to BART Regional Connector*. November
- USDA Forest Service. 2002. THE EFFECTS OF URBAN TREES ON AIR QUALITY. [https://www.nrs.fs.fed.us/units/urban/local-resources/downloads/Tree\\_Air\\_Qual.pdf](https://www.nrs.fs.fed.us/units/urban/local-resources/downloads/Tree_Air_Qual.pdf)



# Figures

**Figure 1 Eastridge to BART Regional Connector Project**

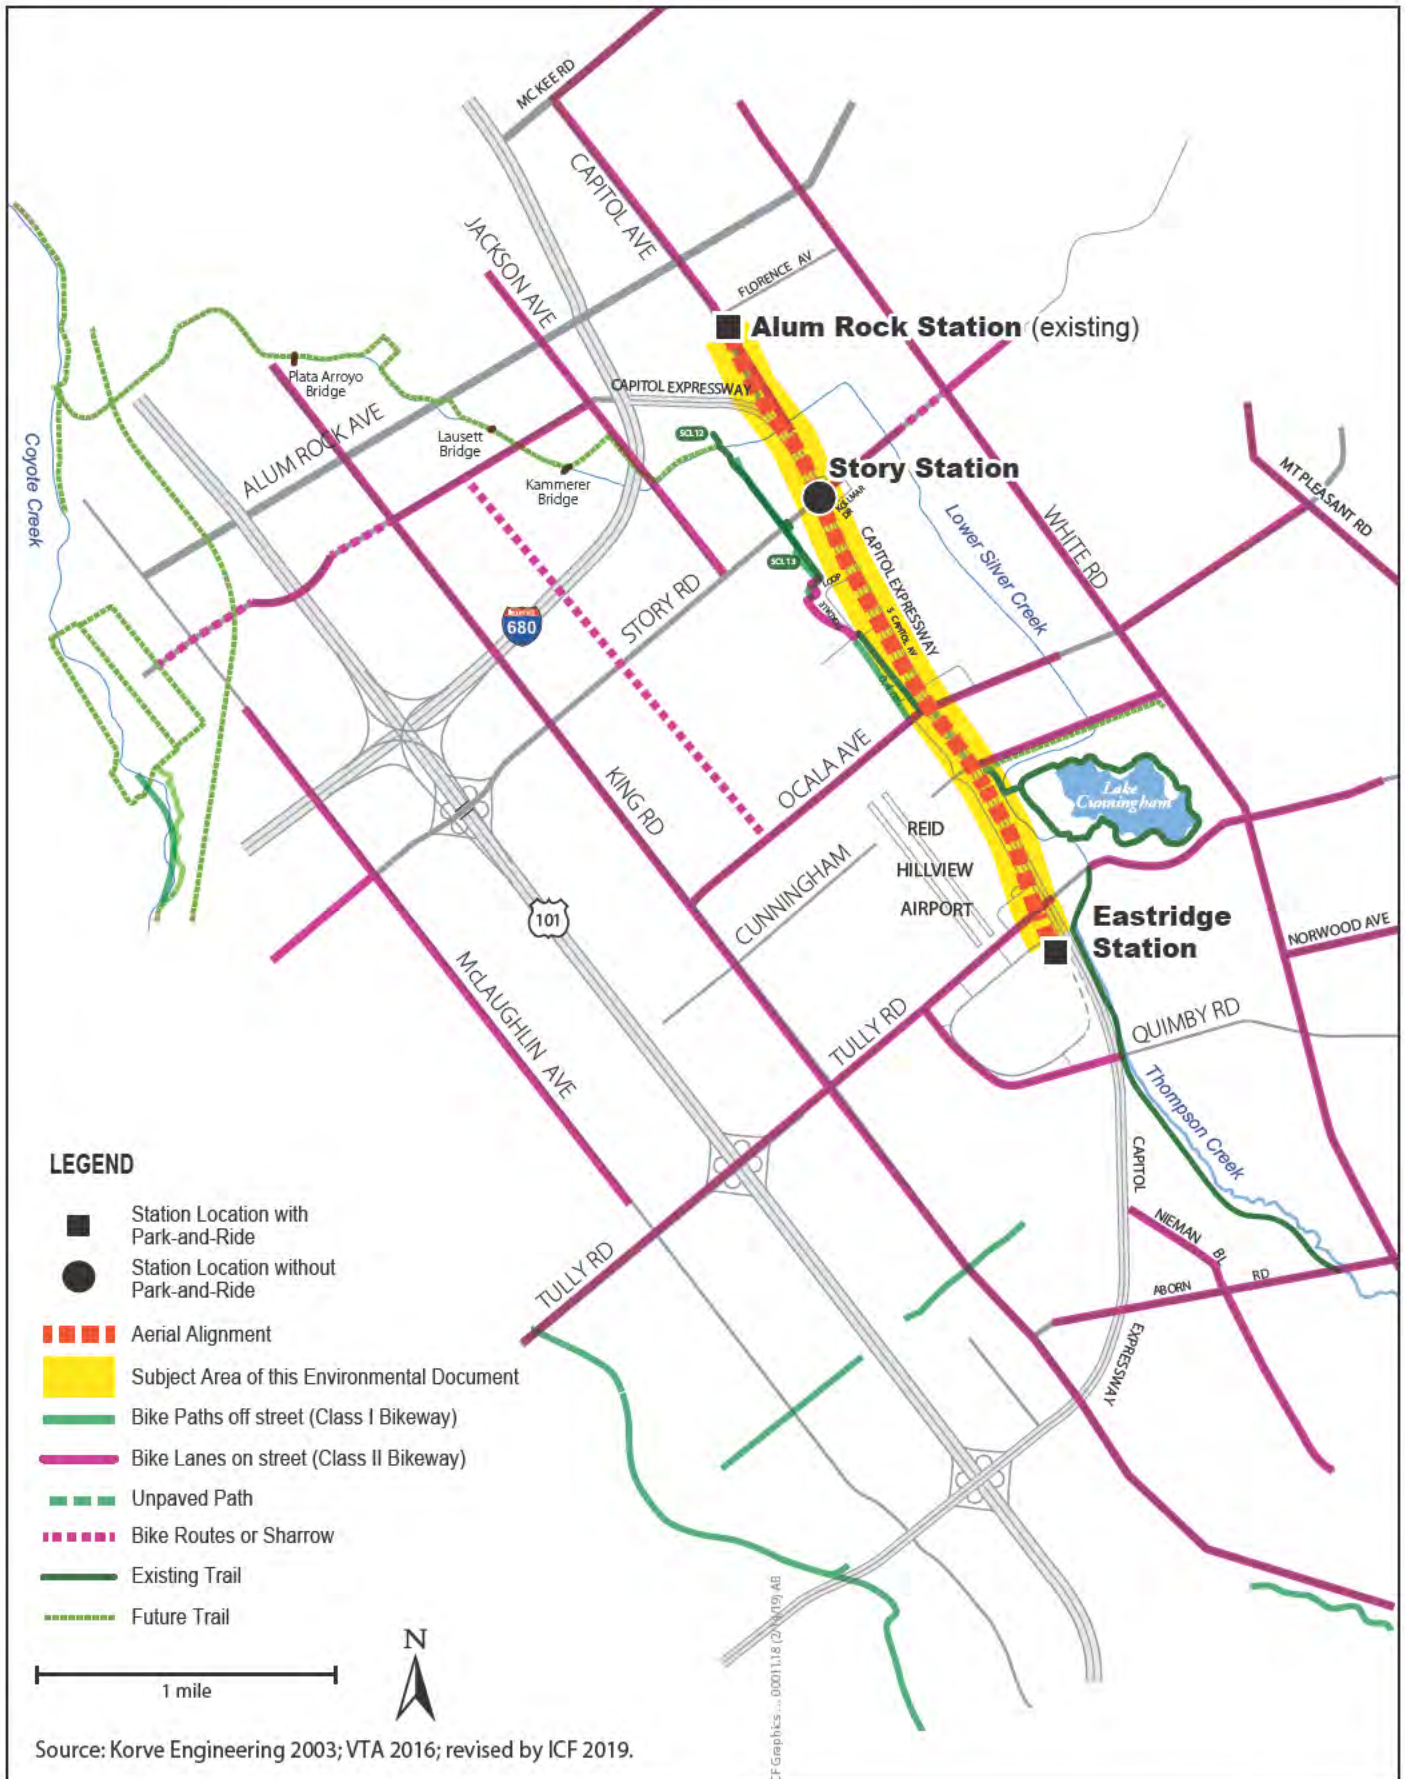

**Figure 1**  
**Eastridge to BART Regional Connector Project**

# Appendices

**Appendix A**      **Excerpt from Addendum to Tree Inventory (January 29, 2021)**

**Appendix B**      **Excerpt from Tree Inventory (November 4, 2019)**

**Appendix C**      **Summary of Significant Environment Impacts and Mitigation Measures**


**Appendix D**      **Description of the Light Rail Alternative**

# Appendix A

**Excerpt from Addendum to Tree Inventory (January 29, 2021)**

58 TREE NUMBER, SEE SPREADSHEET  
 X TREE TO BE REMOVED  
 O EMPTY TREE WELL  
 TREES TO BE REMOVED SHOWN ON THIS SHEET: 14  
 TREES TO BE REMOVED (TOTAL): 61

TREE SHOWN IN SURVEY,  
 DOES NOT EXIST. SEE  
 SPREADSHEET.

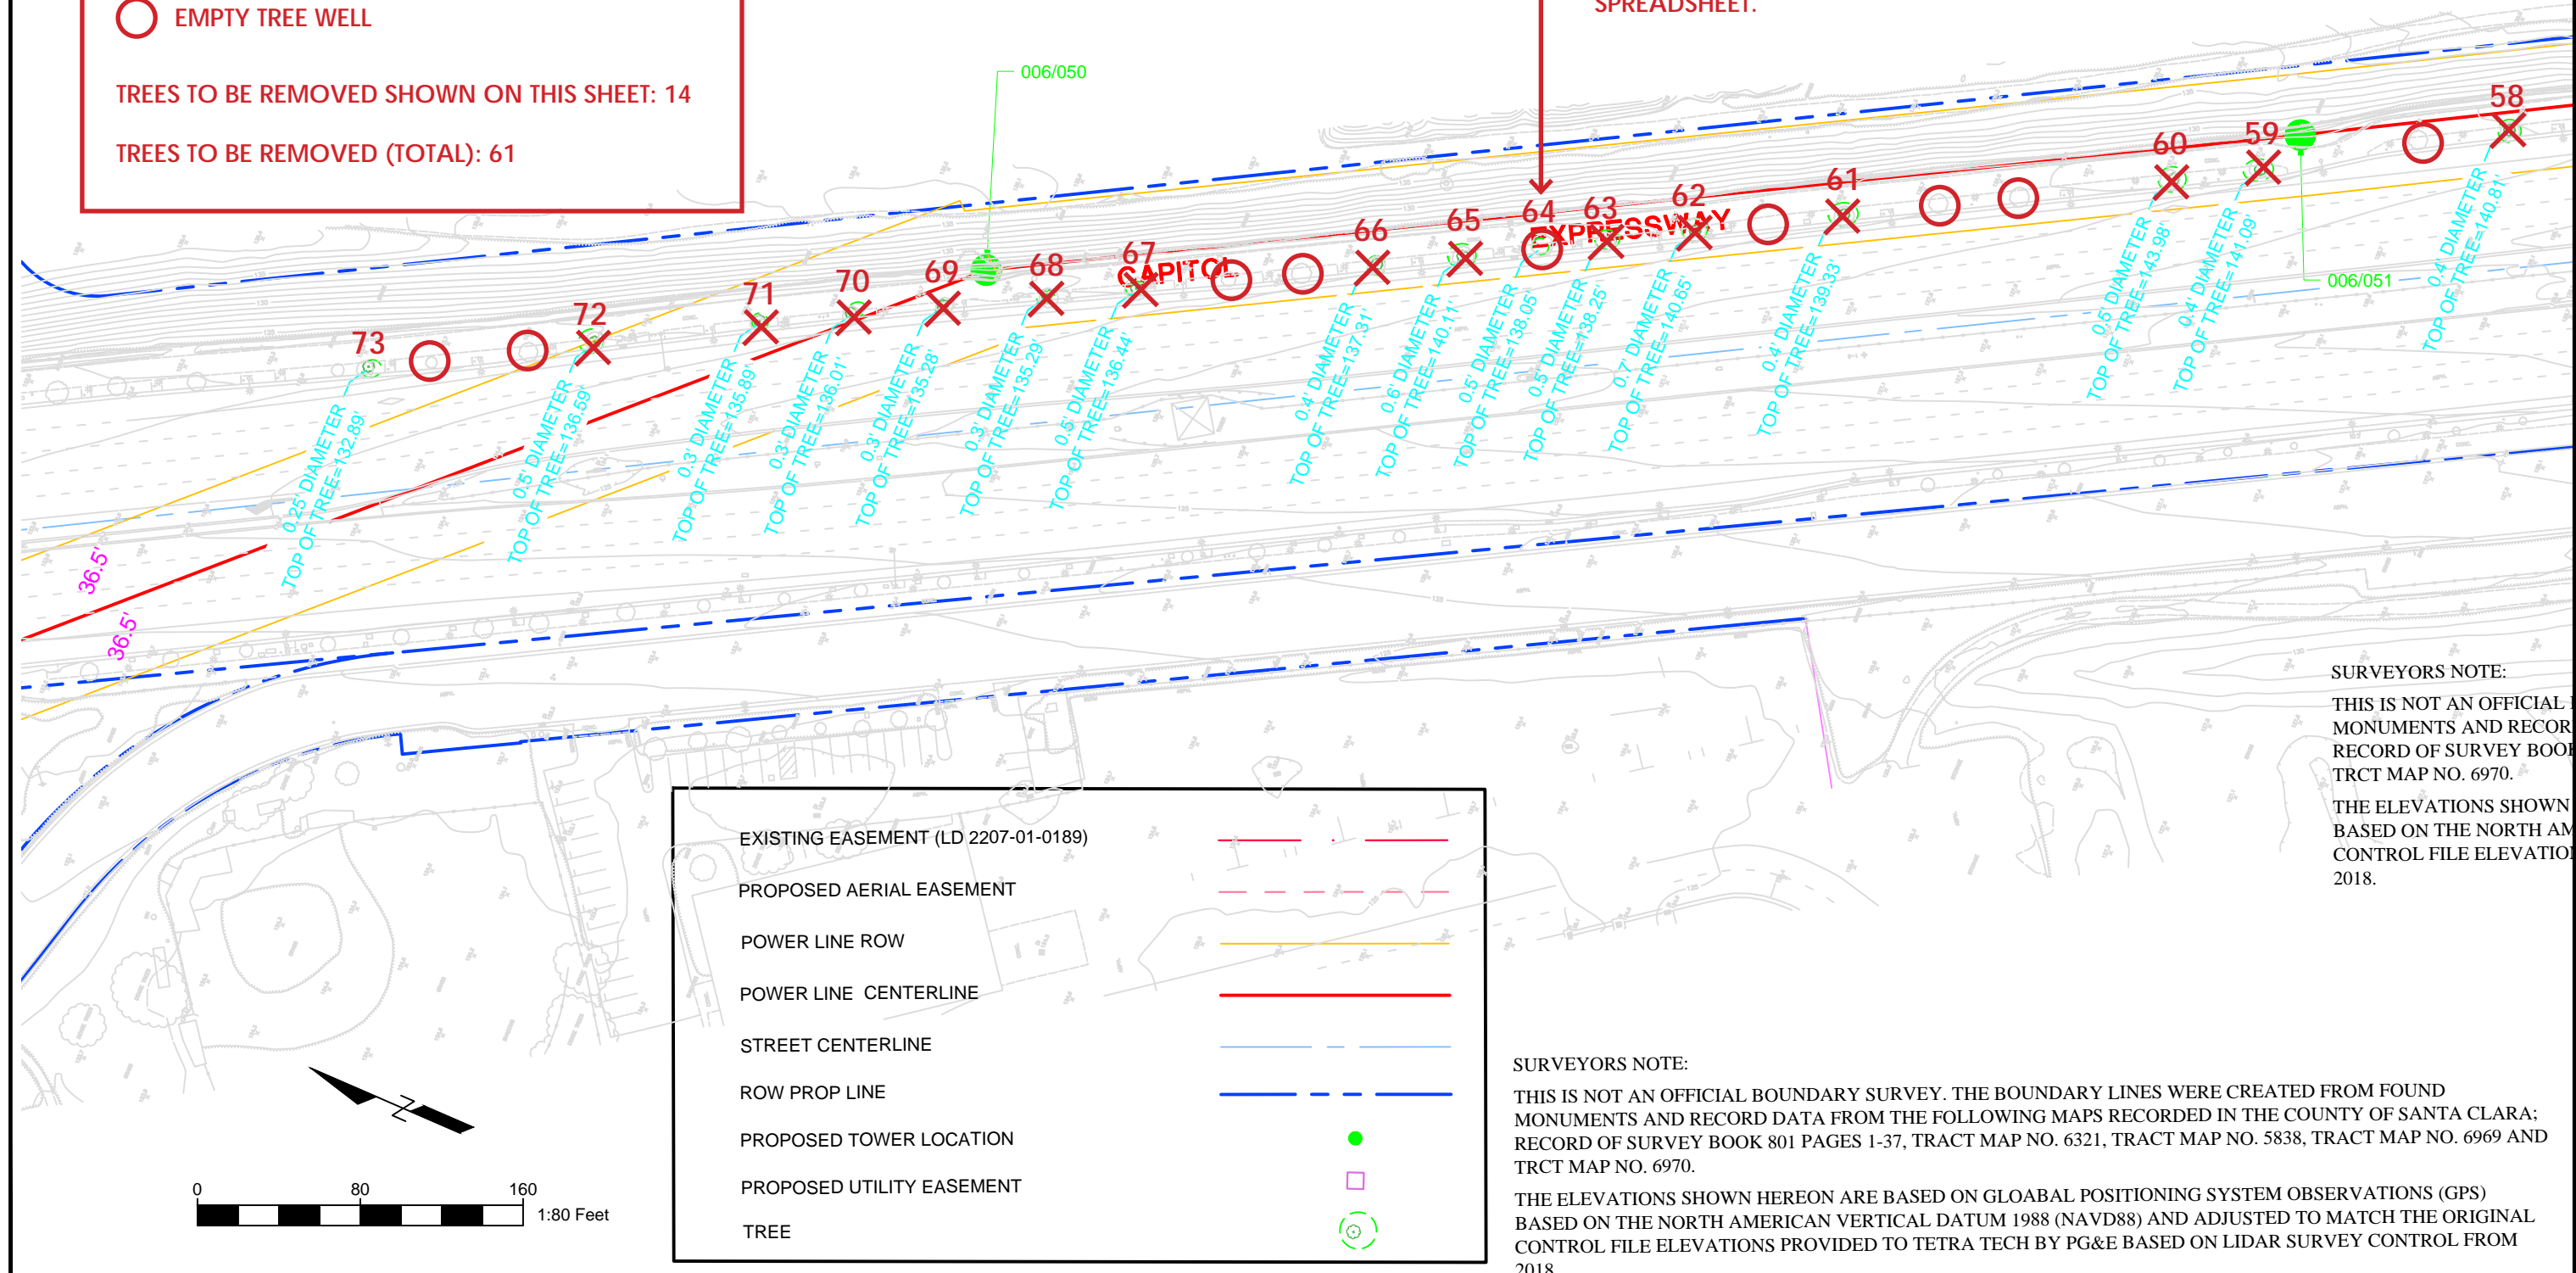

|                                     |  |
|-------------------------------------|--|
| EXISTING EASEMENT (LD 2207-01-0189) |  |
| PROPOSED AERIAL EASEMENT            |  |
| POWER LINE ROW                      |  |
| POWER LINE CENTERLINE               |  |
| STREET CENTERLINE                   |  |
| ROW PROP LINE                       |  |
| PROPOSED TOWER LOCATION             |  |
| PROPOSED UTILITY EASEMENT           |  |
| TREE                                |  |

SURVEYORS NOTE:  
 THIS IS NOT AN OFFICIAL BOUNDARY SURVEY. THE BOUNDARY LINES WERE CREATED FROM FOUND MONUMENTS AND RECORD DATA FROM THE FOLLOWING MAPS RECORDED IN THE COUNTY OF SANTA CLARA: RECORD OF SURVEY BOOK 801 PAGES 1-37, TRACT MAP NO. 6321, TRACT MAP NO. 5838, TRACT MAP NO. 6969 AND TRCT MAP NO. 6970.  
 THE ELEVATIONS SHOWN HEREON ARE BASED ON GLOABAL POSITIONING SYSTEM OBSERVATIONS (GPS) BASED ON THE NORTH AMERICAN VERTICAL DATUM 1988 (NAVD88) AND ADJUSTED TO MATCH THE ORIGINAL CONTROL FILE ELEVATIONS PROVIDED TO TETRA TECH BY PG&E BASED ON LIDAR SURVEY CONTROL FROM 2018.

SURVEYORS NOTE:  
 THIS IS NOT AN OFFICIAL BOUNDARY SURVEY. THE BOUNDARY LINES WERE CREATED FROM FOUND MONUMENTS AND RECORD DATA FROM THE FOLLOWING MAPS RECORDED IN THE COUNTY OF SANTA CLARA: RECORD OF SURVEY BOOK 801 PAGES 1-37, TRACT MAP NO. 6321, TRACT MAP NO. 5838, TRACT MAP NO. 6969 AND TRCT MAP NO. 6970.  
 THE ELEVATIONS SHOWN HEREON ARE BASED ON GLOABAL POSITIONING SYSTEM OBSERVATIONS (GPS) BASED ON THE NORTH AMERICAN VERTICAL DATUM 1988 (NAVD88) AND ADJUSTED TO MATCH THE ORIGINAL CONTROL FILE ELEVATIONS PROVIDED TO TETRA TECH BY PG&E BASED ON LIDAR SURVEY CONTROL FROM 2018.

|   |                           |                                  |
|---|---------------------------|----------------------------------|
| <b>TETRA TECH</b><br><a href="http://www.tetrattech.com">www.tetrattech.com</a> | MCKEE-PIERCY 115KV SURVEY |                                  |
|   | TREE EXHIBIT              | DATE: 12/09/2020<br>SHEET 1 OF 3 |


Copyright: Tetra Tech

Bar Measures 1 inch

58  
 X  
 O

ADDITIONAL TREES TO BE REMOVED SHOWN ON THIS SHEET: 29  
 (NOT SHOWN ON PREVIOUS PAGE)

TREES TO BE REMOVED (TOTAL): 61

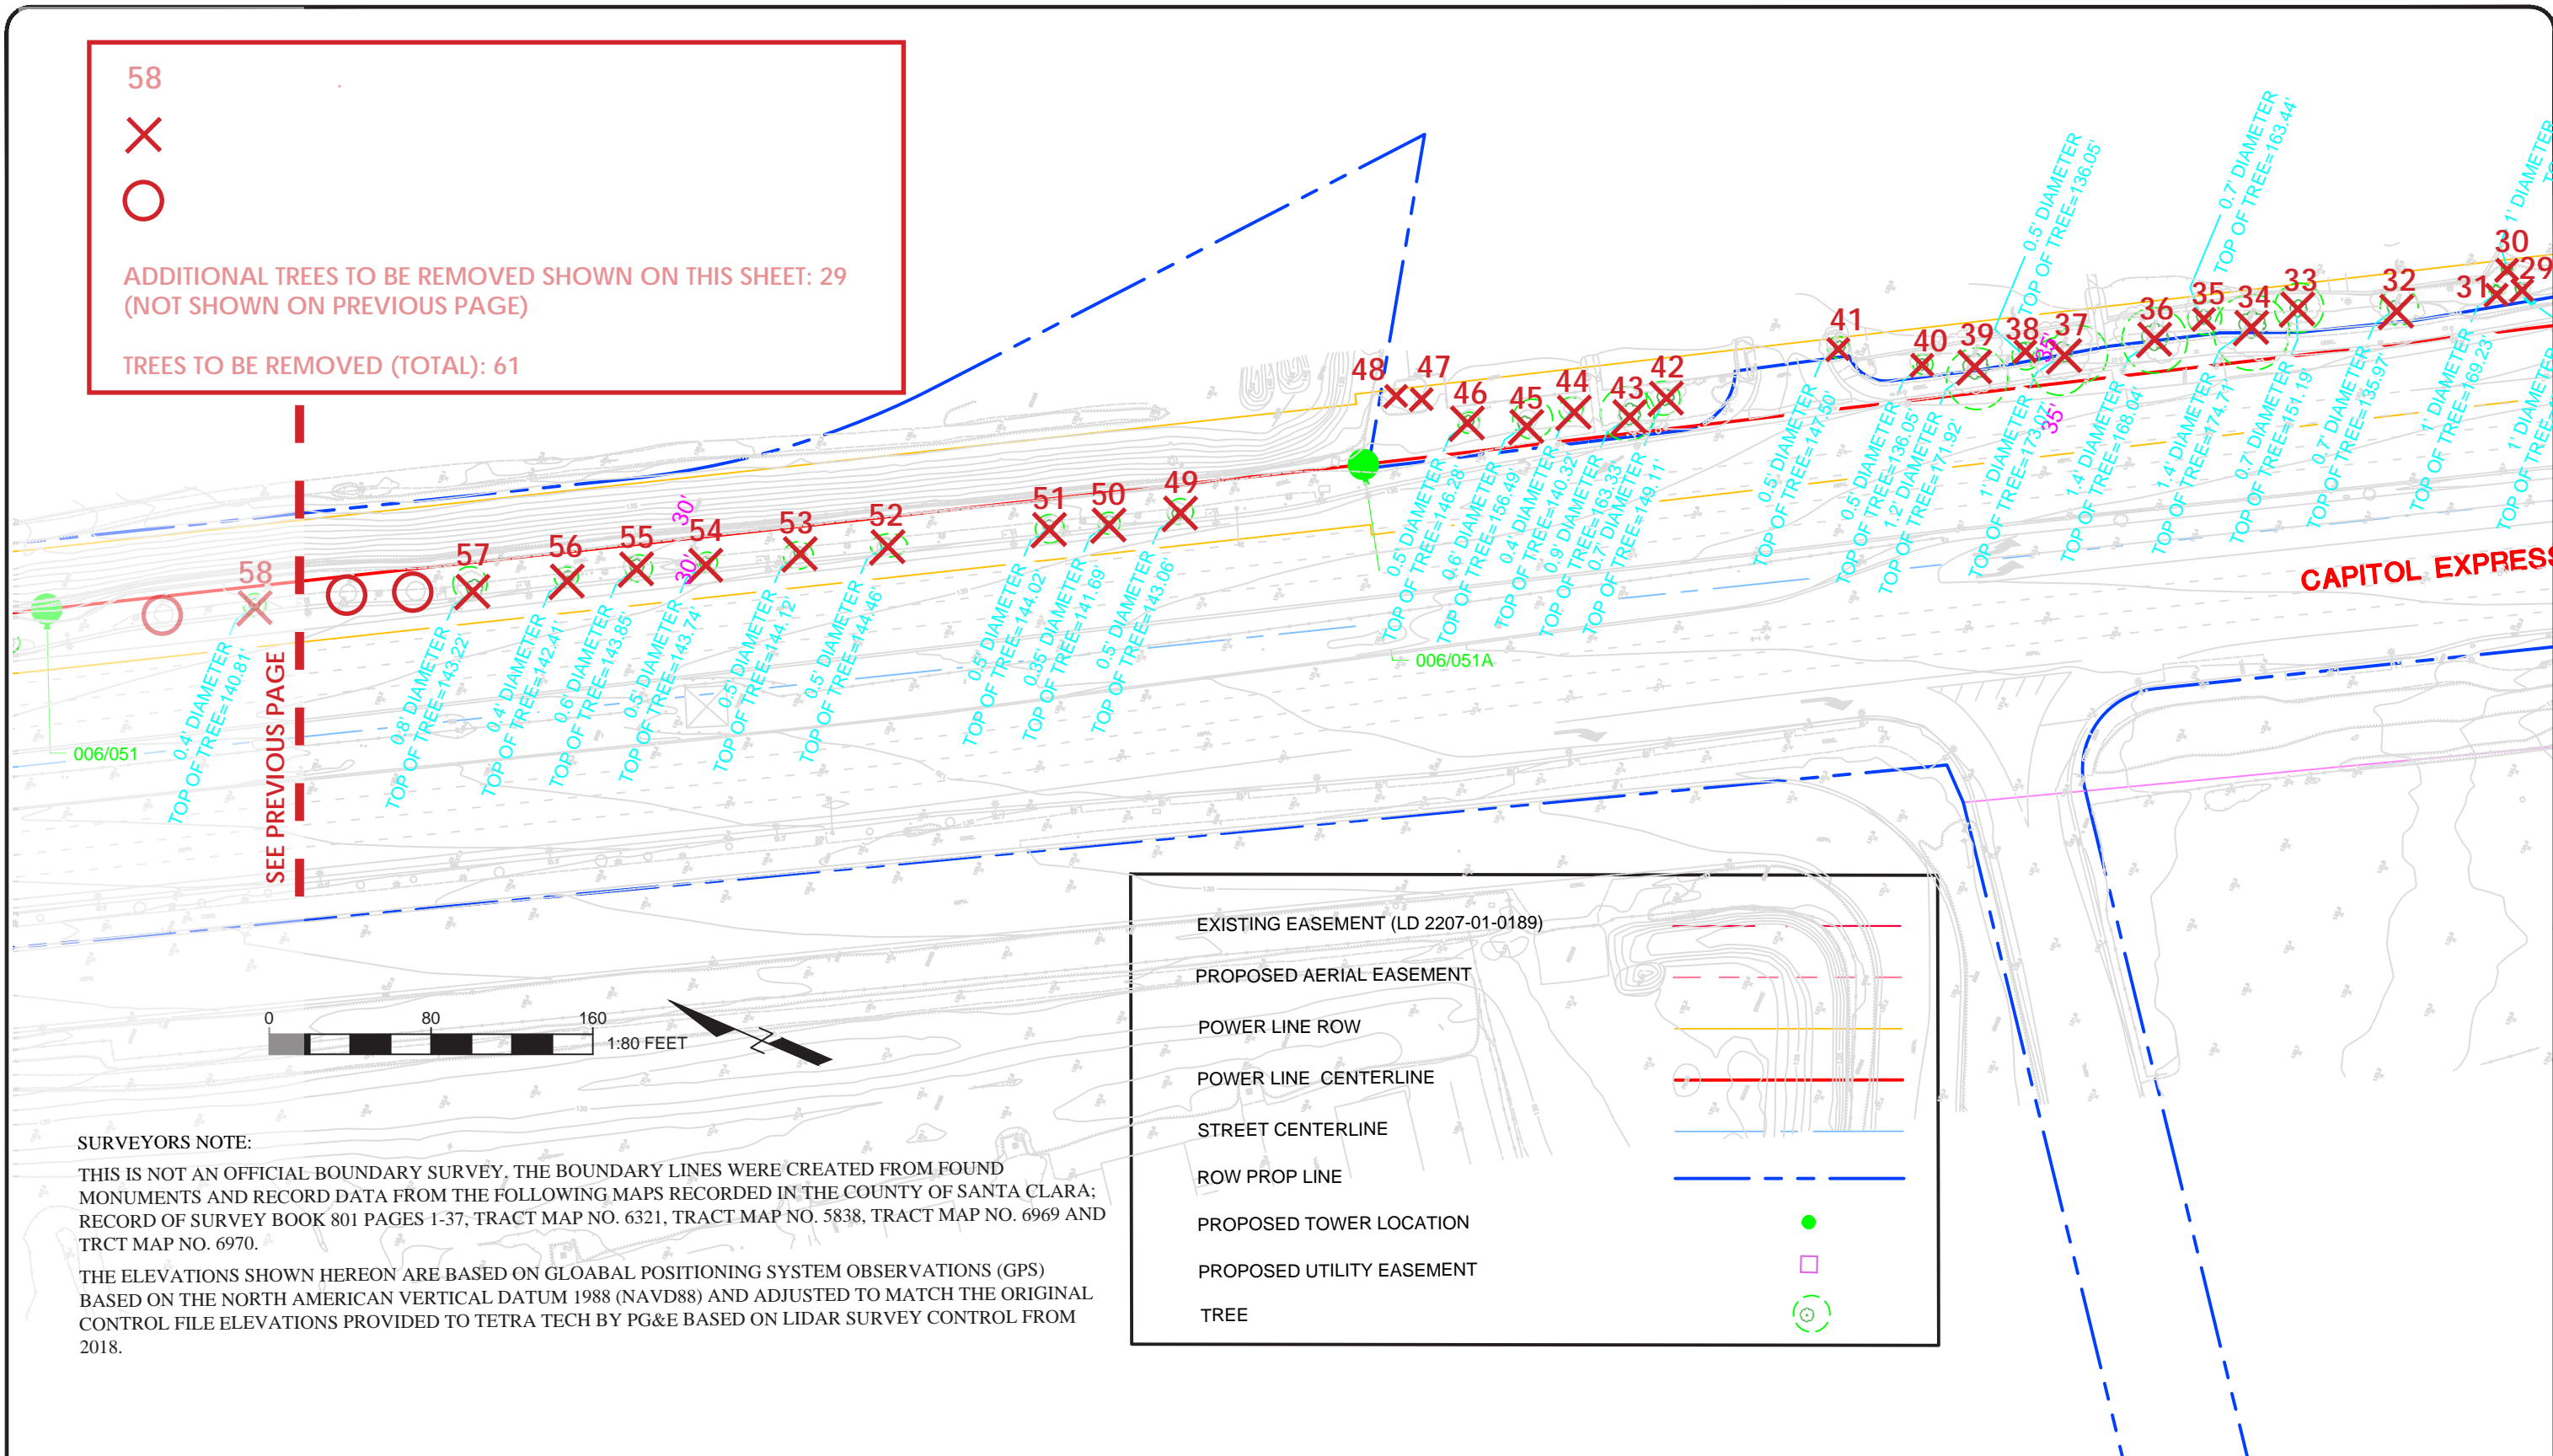

SEE PREVIOUS PAGE




**SURVEYORS NOTE:**  
 THIS IS NOT AN OFFICIAL BOUNDARY SURVEY, THE BOUNDARY LINES WERE CREATED FROM FOUND MONUMENTS AND RECORD DATA FROM THE FOLLOWING MAPS RECORDED IN THE COUNTY OF SANTA CLARA; RECORD OF SURVEY BOOK 801 PAGES 1-37, TRACT MAP NO. 6321, TRACT MAP NO. 5838, TRACT MAP NO. 6969 AND TRCT MAP NO. 6970.  
 THE ELEVATIONS SHOWN HEREON ARE BASED ON GLOABAL POSITIONING SYSTEM OBSERVATIONS (GPS) BASED ON THE NORTH AMERICAN VERTICAL DATUM 1988 (NAVD88) AND ADJUSTED TO MATCH THE ORIGINAL CONTROL FILE ELEVATIONS PROVIDED TO TETRA TECH BY PG&E BASED ON LIDAR SURVEY CONTROL FROM 2018.

|                                     |  |
|-------------------------------------|--|
| EXISTING EASEMENT (LD 2207-01-0189) |  |
| PROPOSED AERIAL EASEMENT            |  |
| POWER LINE ROW                      |  |
| POWER LINE CENTERLINE               |  |
| STREET CENTERLINE                   |  |
| ROW PROP LINE                       |  |
| PROPOSED TOWER LOCATION             |  |
| PROPOSED UTILITY EASEMENT           |  |
| TREE                                |  |

|                                      |   |                  |
|--------------------------------------|---|------------------|
| <br>TETRA TECH<br>www.tetrattech.com | MCKEE-PIERCY 115KV SURVEY<br><br>TREE EXHIBIT | DATE: 12/09/2020 |
|                                      |   | SHEET 2 OF 3     |

Bar Measures 1 inch

Copyright: Tetra Tech

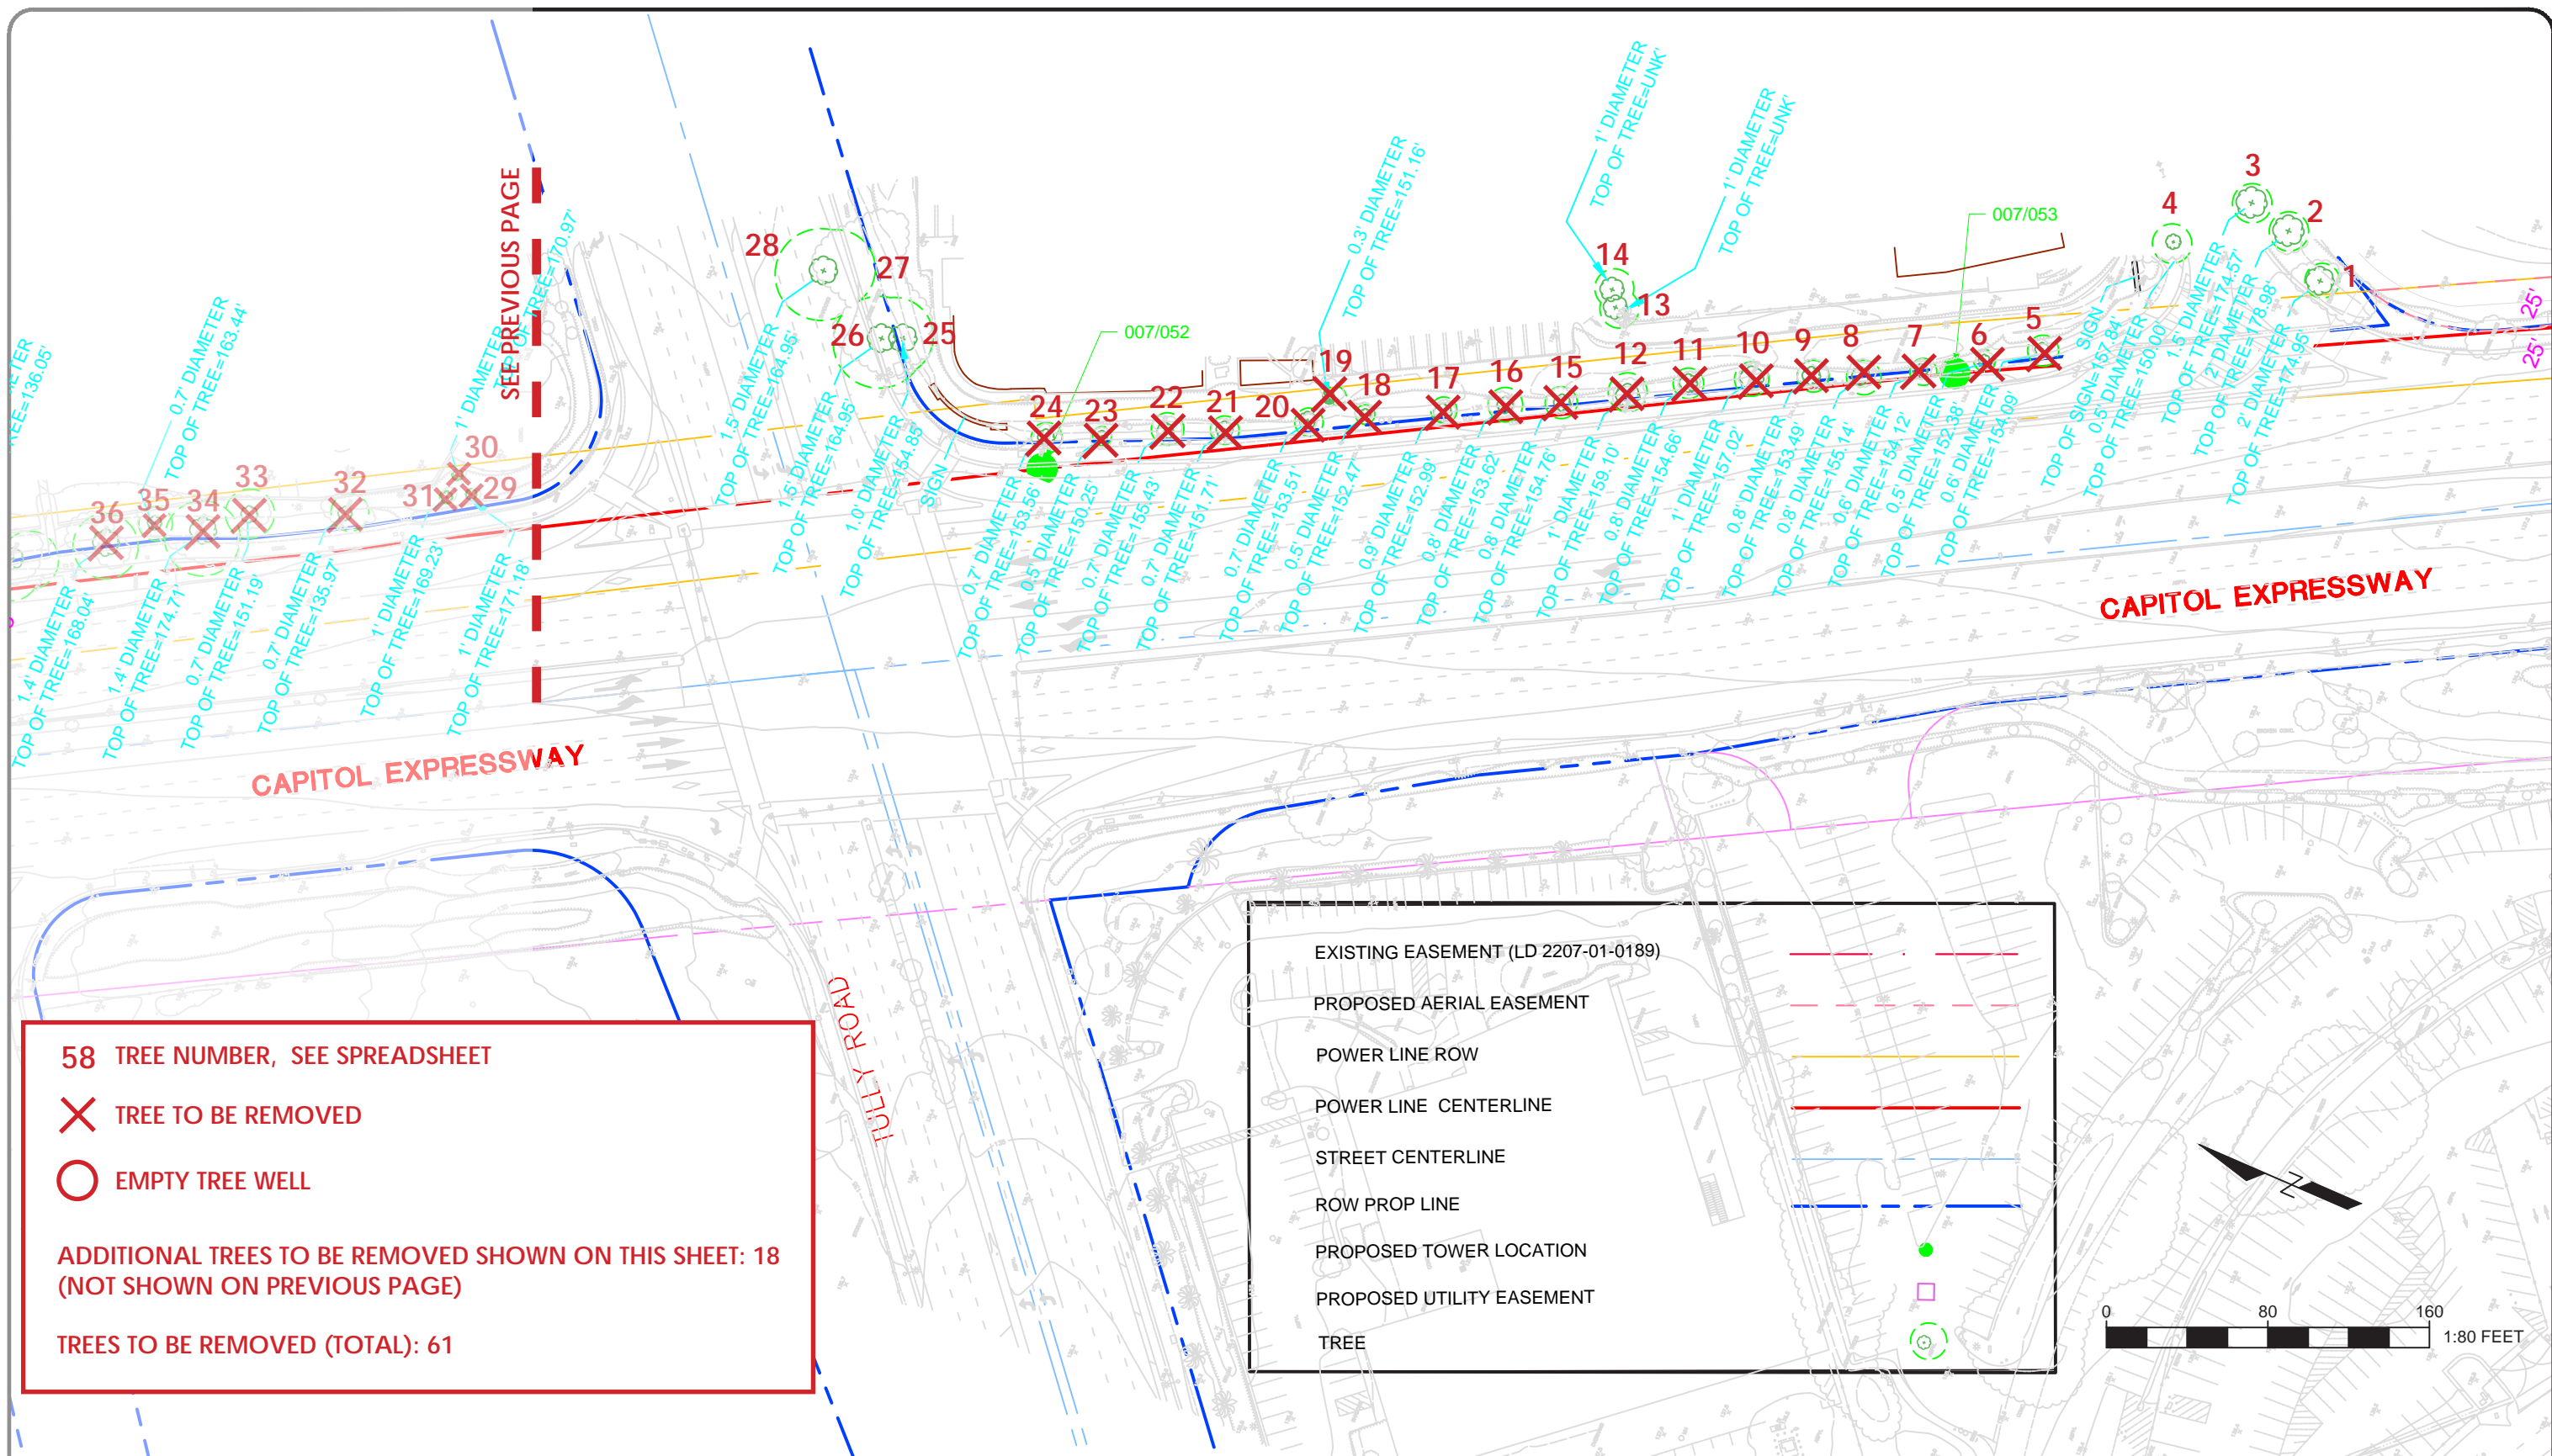

**58** TREE NUMBER, SEE SPREADSHEET

**X** TREE TO BE REMOVED

**O** EMPTY TREE WELL

**ADDITIONAL TREES TO BE REMOVED SHOWN ON THIS SHEET: 18 (NOT SHOWN ON PREVIOUS PAGE)**

**TREES TO BE REMOVED (TOTAL): 61**

|                                     |  |
|-------------------------------------|--|
| EXISTING EASEMENT (LD 2207-01-0189) |  |
| PROPOSED AERIAL EASEMENT            |  |
| POWER LINE ROW                      |  |
| POWER LINE CENTERLINE               |  |
| STREET CENTERLINE                   |  |
| ROW PROP LINE                       |  |
| PROPOSED TOWER LOCATION             |  |
| PROPOSED UTILITY EASEMENT           |  |
| TREE                                |  |

Copyright: Tetra Tech

Bar Measures 1 inch

**EBRC TREE INVENTORY ADDENDUM SPREADSHEET**

**Summary**

|   | Mitigation Per Removal (Native replacement)* | Mitigation Per Removal (Non-Native Replacement)* | Trees to be removed | Mitigation Required (native replacements) | Mitigation Required (non-native replacements) |
|---|--|--|---------------------|---|---|
| Circumference at Breast Height (CBH) <38" (12" diameter equivalent) | 1  | 2  | 55                  | 55  | 110   |
| Circumference at Breast Height (CBH) ≥38" (12" diameter equivalent) | 2  | 3  | 6                   | 12  | 18  |
|   |  | Total  | 61                  | 67  | 128   |

\* Requirements per 2005 EIR

| Tree # | Botanical Name              | Common Name       | CBH (Circumference at Breast Height, inches) | Condition | Native? | Mitigation Required (Native) | Mitigation Required (Non-Native) | Comments  | Noted in field, Not on Tree Exhibit | Remove (per PG&E Demo Plan) |
|--------|-----------------------------|-------------------|--|-----------|---------|------------------------------|----------------------------------|---|-------------------------------------|-----------------------------|
| 1      | <i>Sequoia sempervirens</i> | Coast Redwood     | 49   | Good      | Y       | 2                            | 3                                |   |                                     |                             |
| 2      | <i>Sequoia sempervirens</i> | Coast Redwood     | 54   | Good      | Y       | 2                            | 3                                | Slight top dieback                              |                                     |                             |
| 3      | <i>Sequoia sempervirens</i> | Coast Redwood     | 43   | Good      | Y       | 2                            | 3                                |   |                                     |                             |
| 4      | <i>Prunus cerasifera</i>    | Purple Leaf Plum  | 33   | Good      | N       | 1                            | 2                                | Low Branching                                   |                                     |                             |
| 5      | <i>Magnolia grandiflora</i> | Southern Magnolia | 20   | Good      | N       | 1                            | 2                                |   |                                     | X                           |
| 6      | <i>Magnolia grandiflora</i> | Southern Magnolia | 20   | Good      | N       | 1                            | 2                                |   |                                     | X                           |
| 7      | <i>Magnolia grandiflora</i> | Southern Magnolia | 25   | Good      | N       | 1                            | 2                                |   |                                     | X                           |
| 8      | <i>Magnolia grandiflora</i> | Southern Magnolia | 27   | Good      | N       | 1                            | 2                                |   |                                     | X                           |
| 9      | <i>Magnolia grandiflora</i> | Southern Magnolia | 20   | Good      | N       | 1                            | 2                                | Girdling root                                   |                                     | X                           |
| 10     | <i>Magnolia grandiflora</i> | Southern Magnolia | 29   | Good      | N       | 1                            | 2                                |   |                                     | X                           |
| 11     | <i>Magnolia grandiflora</i> | Southern Magnolia | 21   | Good      | N       | 1                            | 2                                |   |                                     | X                           |
| 12     | <i>Magnolia grandiflora</i> | Southern Magnolia | 37   | Good      | N       | 1                            | 2                                |   |                                     | X                           |
| 13     | <i>Washingtonia robusta</i> | Fan Palm          | 40   | Good      | N       | 2                            | 3                                | In N Out Palms                                  |                                     |                             |
| 14     | <i>Washingtonia robusta</i> | Fan Palm          | 38   | Good      | N       | 2                            | 3                                | In N Out Palms                                  |                                     |                             |
| 15     | <i>Magnolia grandiflora</i> | Southern Magnolia | 30   | Good      | N       | 1                            | 2                                |   |                                     | X                           |
| 16     | <i>Magnolia grandiflora</i> | Southern Magnolia | 29   | Good      | N       | 1                            | 2                                | Form damaged, over-pruned                       |                                     | X                           |
| 17     | <i>Magnolia grandiflora</i> | Southern Magnolia | 26   | Good      | N       | 1                            | 2                                |   |                                     | X                           |
| 18     | <i>Magnolia grandiflora</i> | Southern Magnolia | 18   | Good      | N       | 1                            | 2                                |   |                                     | X                           |
| 19     | <i>Prunus cerasifera</i>    | Purple Leaf Plum  | 33   | Poor      | N       | 1                            | 2                                | Low Branching, significant dieback, over-pruned |                                     | X                           |
| 20     | <i>Magnolia grandiflora</i> | Southern Magnolia | 25   | Good      | N       | 1                            | 2                                | Over-pruned                                     |                                     | X                           |
| 21     | <i>Magnolia grandiflora</i> | Southern Magnolia | 24   | Good      | N       | 1                            | 2                                |   |                                     | X                           |
| 22     | <i>Magnolia grandiflora</i> | Southern Magnolia | 26   | Good      | N       | 1                            | 2                                |   |                                     | X                           |



**EBRC TREE INVENTORY ADDENDUM SPREADSHEET**

| <b>Tree #</b> | <b>Botanical Name</b>            | <b>Common Name</b> | <b>CBH<br/>(Circumference at<br/>Breast Height,<br/>inches)</b> | <b>Condition</b> | <b>Native?</b> | <b>Mitigation<br/>Required<br/>(Native)</b> | <b>Mitigation<br/>Required<br/>(Non-Native)</b> | <b>Comments</b>               | <b>Noted in<br/>field, Not on<br/>Tree Exhibit</b> | <b>Remove (per<br/>PG&amp;E Demo<br/>Plan)</b> |
|---------------|----------------------------------|--------------------|---|------------------|----------------|---|---|-------------------------------|--|--|
| 50            | <i>X Chitalpa tashkentensis</i>  | Chitalpa           | 9   | Fair             | N              | 1   | 2   |                               |  | X  |
| 51            | <i>X Chitalpa tashkentensis</i>  | Chitalpa           | 14  | Good             | N              | 1   | 2   |                               |  | X  |
| 52            | <i>X Chitalpa tashkentensis</i>  | Chitalpa           | 17  | Good             | N              | 1   | 2   |                               |  | X  |
| 53            | <i>X Chitalpa tashkentensis</i>  | Chitalpa           | 15  | Good             | N              | 1   | 2   |                               |  | X  |
| 54            | <i>X Chitalpa tashkentensis</i>  | Chitalpa           | 12  | Good             | N              | 1   | 2   |                               |  | X  |
| 55            | <i>Chilopsis linearis</i>        | Desert Willow      | 17  | Fair             | N              | 1   | 2   |                               |  | X  |
| 56            | <i>X Chitalpa tashkentensis</i>  | Chitalpa           | 13  | Good             | N              | 1   | 2   |                               |  | X  |
| 57            | <i>Chilopsis linearis</i>        | Desert Willow      | 26  | Good             | N              | 1   | 2   | Vigorous, Low<br>branching    |  | X  |
| 58            | <i>X Chitalpa tashkentensis</i>  | Chitalpa           | 13  | Fair             | N              | 1   | 2   | Basal sprouts                 |  | X  |
| 59            | <i>X Chitalpa tashkentensis</i>  | Chitalpa           | 14  | Good             | N              | 1   | 2   |                               |  | X  |
| 60            | <i>X Chitalpa tashkentensis</i>  | Chitalpa           | 15  | Fair             | N              | 1   | 2   | Basal sprouts                 |  | X  |
| 61            | <i>X Chitalpa tashkentensis</i>  | Chitalpa           | 13  | Good             | N              | 1   | 2   |                               |  | X  |
| 62            | <i>Chilopsis linearis</i>        | Desert Willow      | 18  | Good             | N              | 1   | 2   | Low branching                 |  | X  |
| 63            | <i>Chilopsis linearis</i>        | Desert Willow      | 17  | Fair             | N              | 1   | 2   | Low branching, trunk<br>wound |  | X  |
| 64            | <i>No tree root sprouts only</i> |                    |   |                  |                | 0   | 0   |                               |  |  |
| 65            | <i>Chilopsis linearis</i>        | Desert Willow      | 19  | Good             | N              | 1   | 2   |                               |  | X  |
| 66            | <i>X Chitalpa tashkentensis</i>  | Chitalpa           | 9   | Good             | N              | 1   | 2   |                               |  | X  |
| 67            | <i>Chilopsis linearis</i>        | Desert Willow      | 11  | Good             | N              | 1   | 2   | Low branching                 |  | X  |
| 68            | <i>X Chitalpa tashkentensis</i>  | Chitalpa           | 7   | Fair             | N              | 1   | 2   | Low vigor                     |  | X  |
| 69            | <i>X Chitalpa tashkentensis</i>  | Chitalpa           | 7   | Poor             | N              | 1   | 2   | Low vigor                     |  | X  |
| 70            | <i>Chilopsis linearis</i>        | Desert Willow      | 8   | Poor             | N              | 1   | 2   | Root crown/stem<br>failure    |  | X  |
| 71            | <i>Chilopsis linearis</i>        | Desert Willow      | 7   | Fair             | N              | 1   | 2   | Low vigor                     |  | X  |
| 72            | <i>Chilopsis linearis</i>        | Desert Willow      | 12  | Good             | N              | 1   | 2   | Low branching                 |  | X  |
| 73            | <i>X Chitalpa tashkentensis</i>  | Chitalpa           | 7   | Fair             | N              | 1   | 2   | Low vigor, basal<br>sprouts   |  |  |

# Appendix B

**Excerpt from Tree Inventory (November 4, 2019)**


**DEMOLITION PLAN NOTES:**

(FOR CR DRAWINGS ONLY)

1. THESE PLANS ARE ACCURATE FOR DEMOLITION WORK ONLY.
2. FOR LEGEND AND ABBREVIATIONS, SEE GN DRAWINGS.
3. UNLESS OTHERWISE NOTED, ALL STATION OFFSETS BASED ON C "SB TRACK" LAYOUT LINE.
4. EXISTING POLE FOUNDATION SHALL BE REMOVED TO A DEPTH OF AT LEAST 5 FEET BELOW FINISHED GRADE OR UPON THE DIRECTION FROM VTA.
5. SAWCUT EXISTING PAVEMENT AND/OR PAVEMENT EDGE TO A NEAT LINE, PROTECT VERTICAL EDGE.
6. REMOVE SIDEWALK AND GUTTER TO NEAREST SCOREMARK JOINT.
7. THE LINES AND THICKNESS SHOWN FOR THE REMOVAL OF WALL, PAVEMENT, CURB AND GUTTER, SIDEWALK AND ALL OTHER CIVIL CONSTRUCTION WORK ARE FOR INFORMATION ONLY. IT SHALL BE THE CONTRACTOR'S RESPONSIBILITY TO DETERMINE THE EXTENT OF WORK BASED ON THE SPACE REQUIRED TO PERFORM THE CONSTRUCTION WORK AND/OR THE CONTRACTOR'S MEANS AND METHODS AND REQUIREMENTS FOR SHORING, EXCAVATION AND TEMPORARY SUPPORT.
8. FOR STREET LIGHTING REMOVALS NOT SHOWN, SEE EL DRAWINGS.
9. FOR UTILITY REMOVALS AND RELOCATIONS NOT SHOWN, SEE UP DRAWINGS.
10. FOR STORM DRAIN REMOVALS NOT SHOWN, SEE DP DRAWINGS.
11. FOR TRACKS AND TRACK PANEL REMOVALS, SEE TD DRAWINGS
12. FOR TRAFFIC SIGNAL REMOVALS NOT SHOWN, SEE ET DRAWINGS
13. FOR SIGN REMOVALS NOT SHOWN, SEE CY DRAWINGS.
14. FOR OCS POLE REMOVALS, SEE TD DRAWINGS.
15. FOR BIORETENTION AREAS, SEE DC DRAWINGS.
16. FOR LIMITS OF WORK, SEE CP DRAWINGS.

**TREES TO BE REMOVED SHOWN ON THIS SHEET: 2**


**TREES TO BE REMOVED (TOTAL): 133**

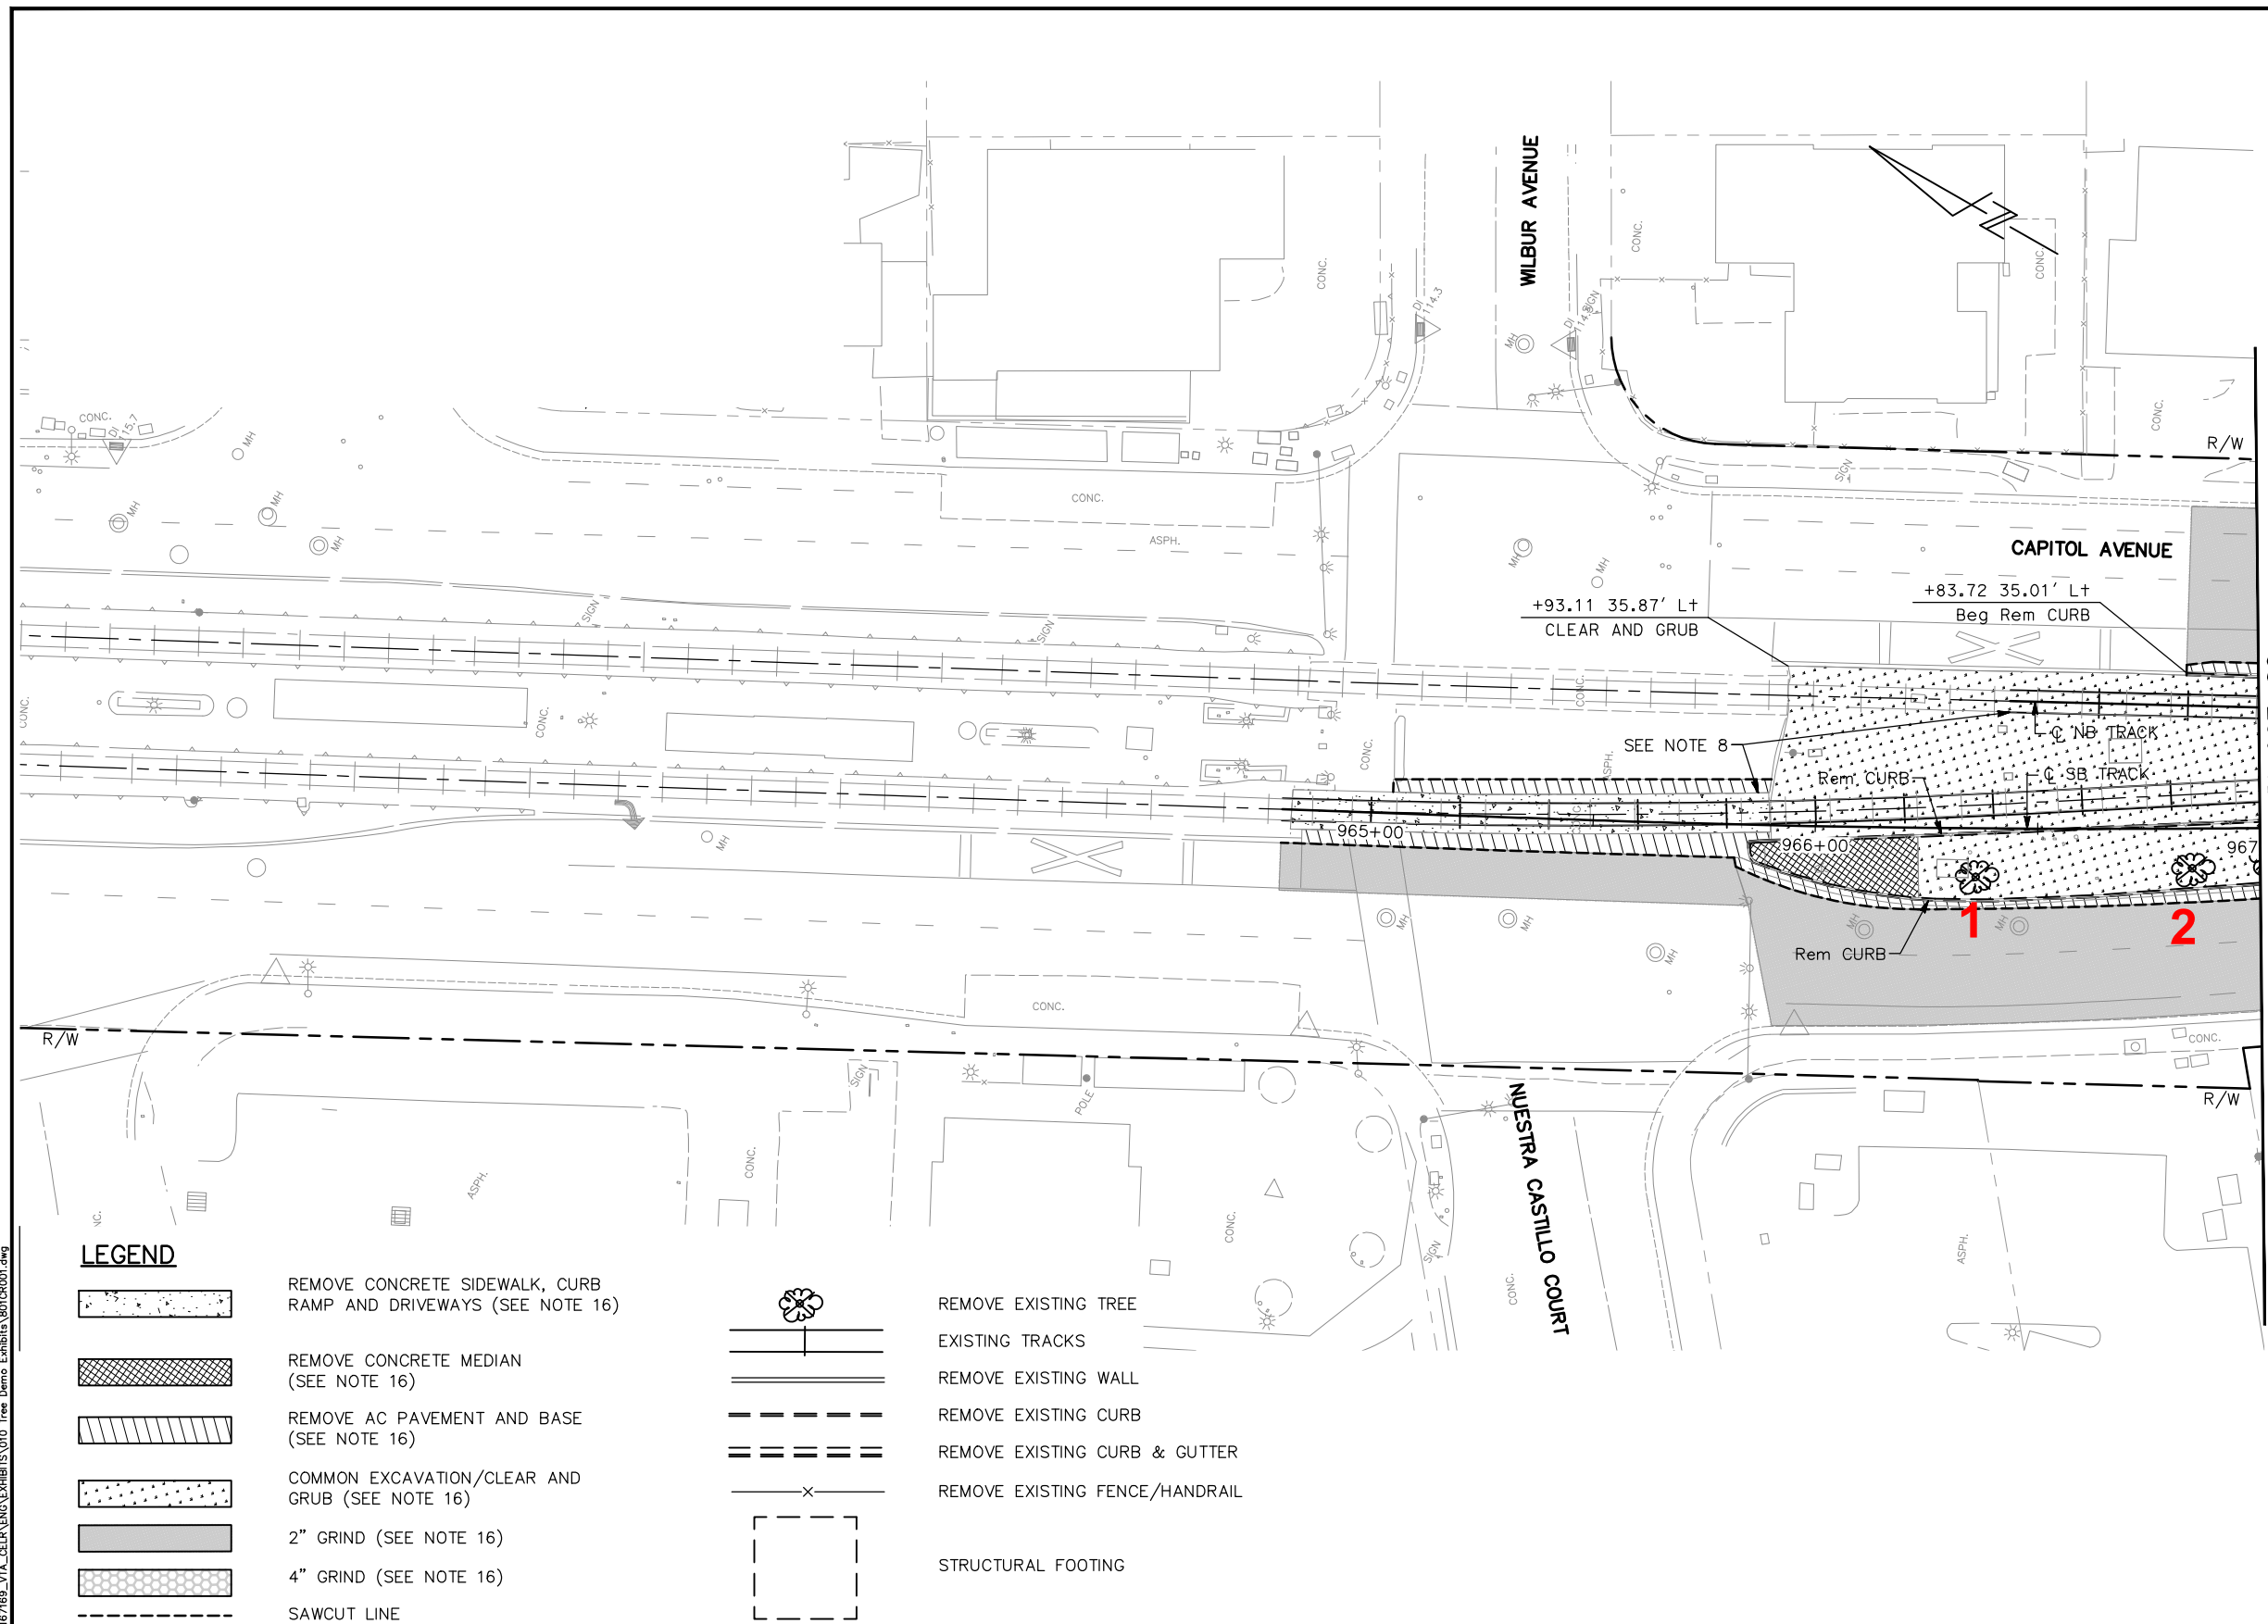

**LEGEND**


- REMOVE CONCRETE SIDEWALK, CURB RAMP AND DRIVEWAYS (SEE NOTE 16)
- REMOVE CONCRETE MEDIAN (SEE NOTE 16)
- REMOVE AC PAVEMENT AND BASE (SEE NOTE 16)
- COMMON EXCAVATION/CLEAR AND GRUB (SEE NOTE 16)
- 2" GRIND (SEE NOTE 16)
- 4" GRIND (SEE NOTE 16)
- SAWCUT LINE
- REMOVE EXISTING TREE
- EXISTING TRACKS
- REMOVE EXISTING WALL
- REMOVE EXISTING CURB
- REMOVE EXISTING CURB & GUTTER
- REMOVE EXISTING FENCE/HANDRAIL
- STRUCTURAL FOOTING

ALL DIMENSIONS ARE IN FEET UNLESS OTHERWISE SHOWN

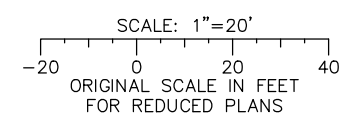

HEIN Oct 17, 2019 - 11:07am K:\2018\67169\_VTA\_CELV\ENG\EXHIBITS\010 Tree Demo Exhibits\_801CR001.dwg

|     |       |                   |
|-----|-------|-------------------|
| NO. | DATE  | REVISIONS         |
| B   | 03/19 | 65% SUBMITTAL SET |
| A   | 06/18 | 35% SUBMITTAL SET |

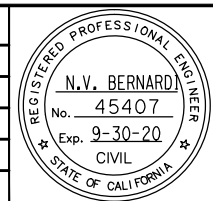

**BKF 100+ YEARS**  
ENGINEERS / SURVEYORS / PLANNERS

DESIGNED: C. Chi  
CHECKED: M. Cosentino  
DRAWN: A. Hernandez  
CADD FILE NAME: 801CR001.dwg



**BKF 100+ YEARS**  
ENGINEERS / SURVEYORS / PLANNERS

CADD FILE DATE: 03/01/19  
SCALE: 1" = 20'  
SUBMITTAL DATE: 03/11/19  
BOARD APPROVAL DATE:

**EASTRIDGE TO BART REGIONAL CONNECTOR  
CAPITOL EXPRESSWAY LIGHT RAIL PROJECT**

CIVIL  
DEMOLITION PLAN  
STA 964+80 TO STA 967+00


PCA NO: 000 CONTRACT NO: C801 FILE LOCATION: PROJECTWISE

SHEET OF: CR001  
REVISION: B

**NOTE:**

FOR DEMOLITION PLAN NOTES AND LEGEND, SEE DRAWING CR001.


**TREES TO BE REMOVED SHOWN ON THIS SHEET: 19**

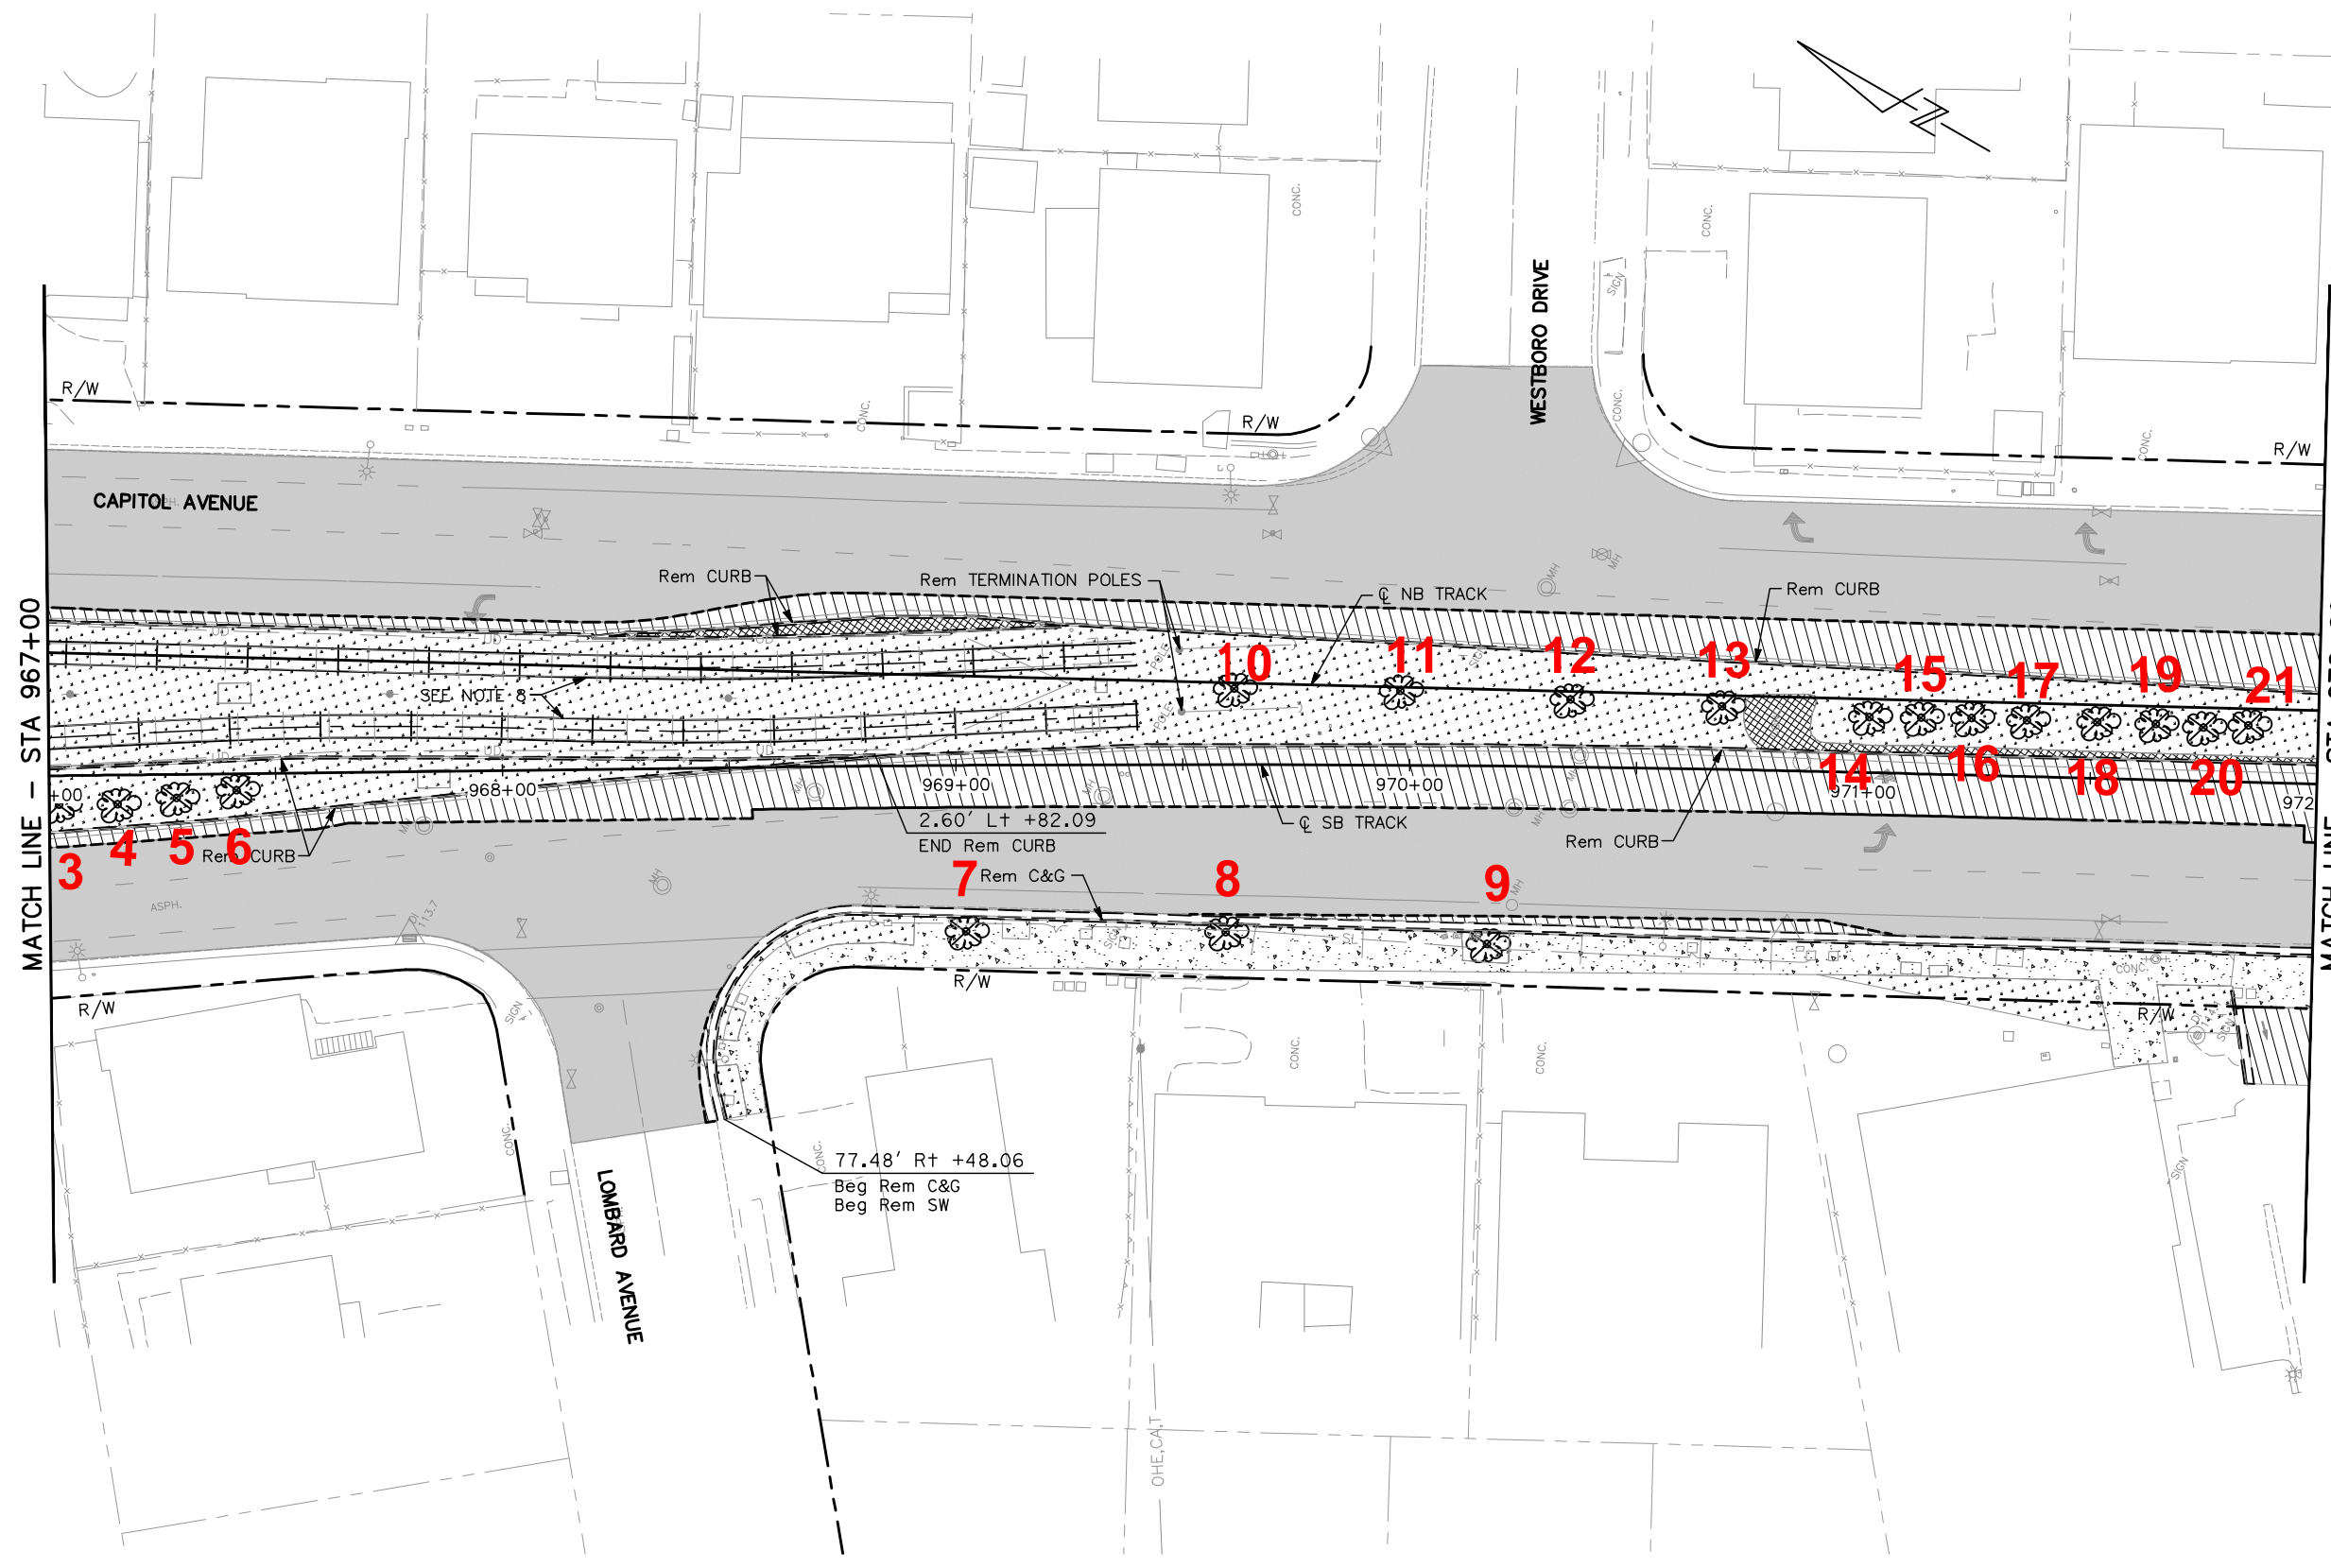

MATCH LINE - STA 967+00


MATCH LINE - STA 972+00

ALL DIMENSIONS ARE IN FEET UNLESS OTHERWISE SHOWN

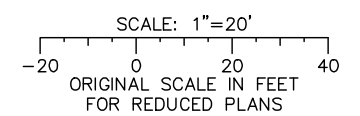

HEIN Oct 17, 2019 - 8:53am K:\2016\167169\_VTA\_CELVENC\EXHIBITS\010\_Tree\_Demo\_Exhibits\01CR002.dwg

| NO. | DATE  | REVISIONS         |
|-----|-------|-------------------|
| B   | 03/19 | 65% SUBMITTAL SET |
| A   | 06/18 | 35% SUBMITTAL SET |

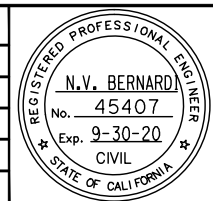

SUBMITTED

**BKF 100+**  
YEARS  
ENGINEERS / SURVEYORS / PLANNERS

DESIGNED: C. Chi  
CHECKED: M. Cosentino  
DRAWN: A. Hernandez  
CADD FILE NAME: 801CR002.dwg

Santa Clara Valley  
Transportation  
Authority

APPROVED

**BKF 100+**  
YEARS  
ENGINEERS / SURVEYORS / PLANNERS

CADD FILE DATE: 03/01/19  
SUBMITTAL DATE: 03/11/19  
SCALE: 1" = 20'  
BOARD APPROVAL DATE:

EASTRIDGE TO BART REGIONAL CONNECTOR  
CAPITOL EXPRESSWAY LIGHT RAIL PROJECT  
CIVIL  
DEMOLITION PLAN  
STA 967+00 TO STA 972+00



PCA NO.: 000  
CONTRACT NO.: C801  
FILE LOCATION: PROJECTWISE

SHEET OF: CR002  
REVISION: B

**NOTE:**

FOR DEMOLITION PLAN NOTES AND LEGEND, SEE DRAWING CR001.


**TREES TO BE REMOVED SHOWN ON THIS SHEET: 7**

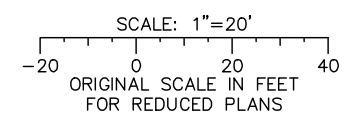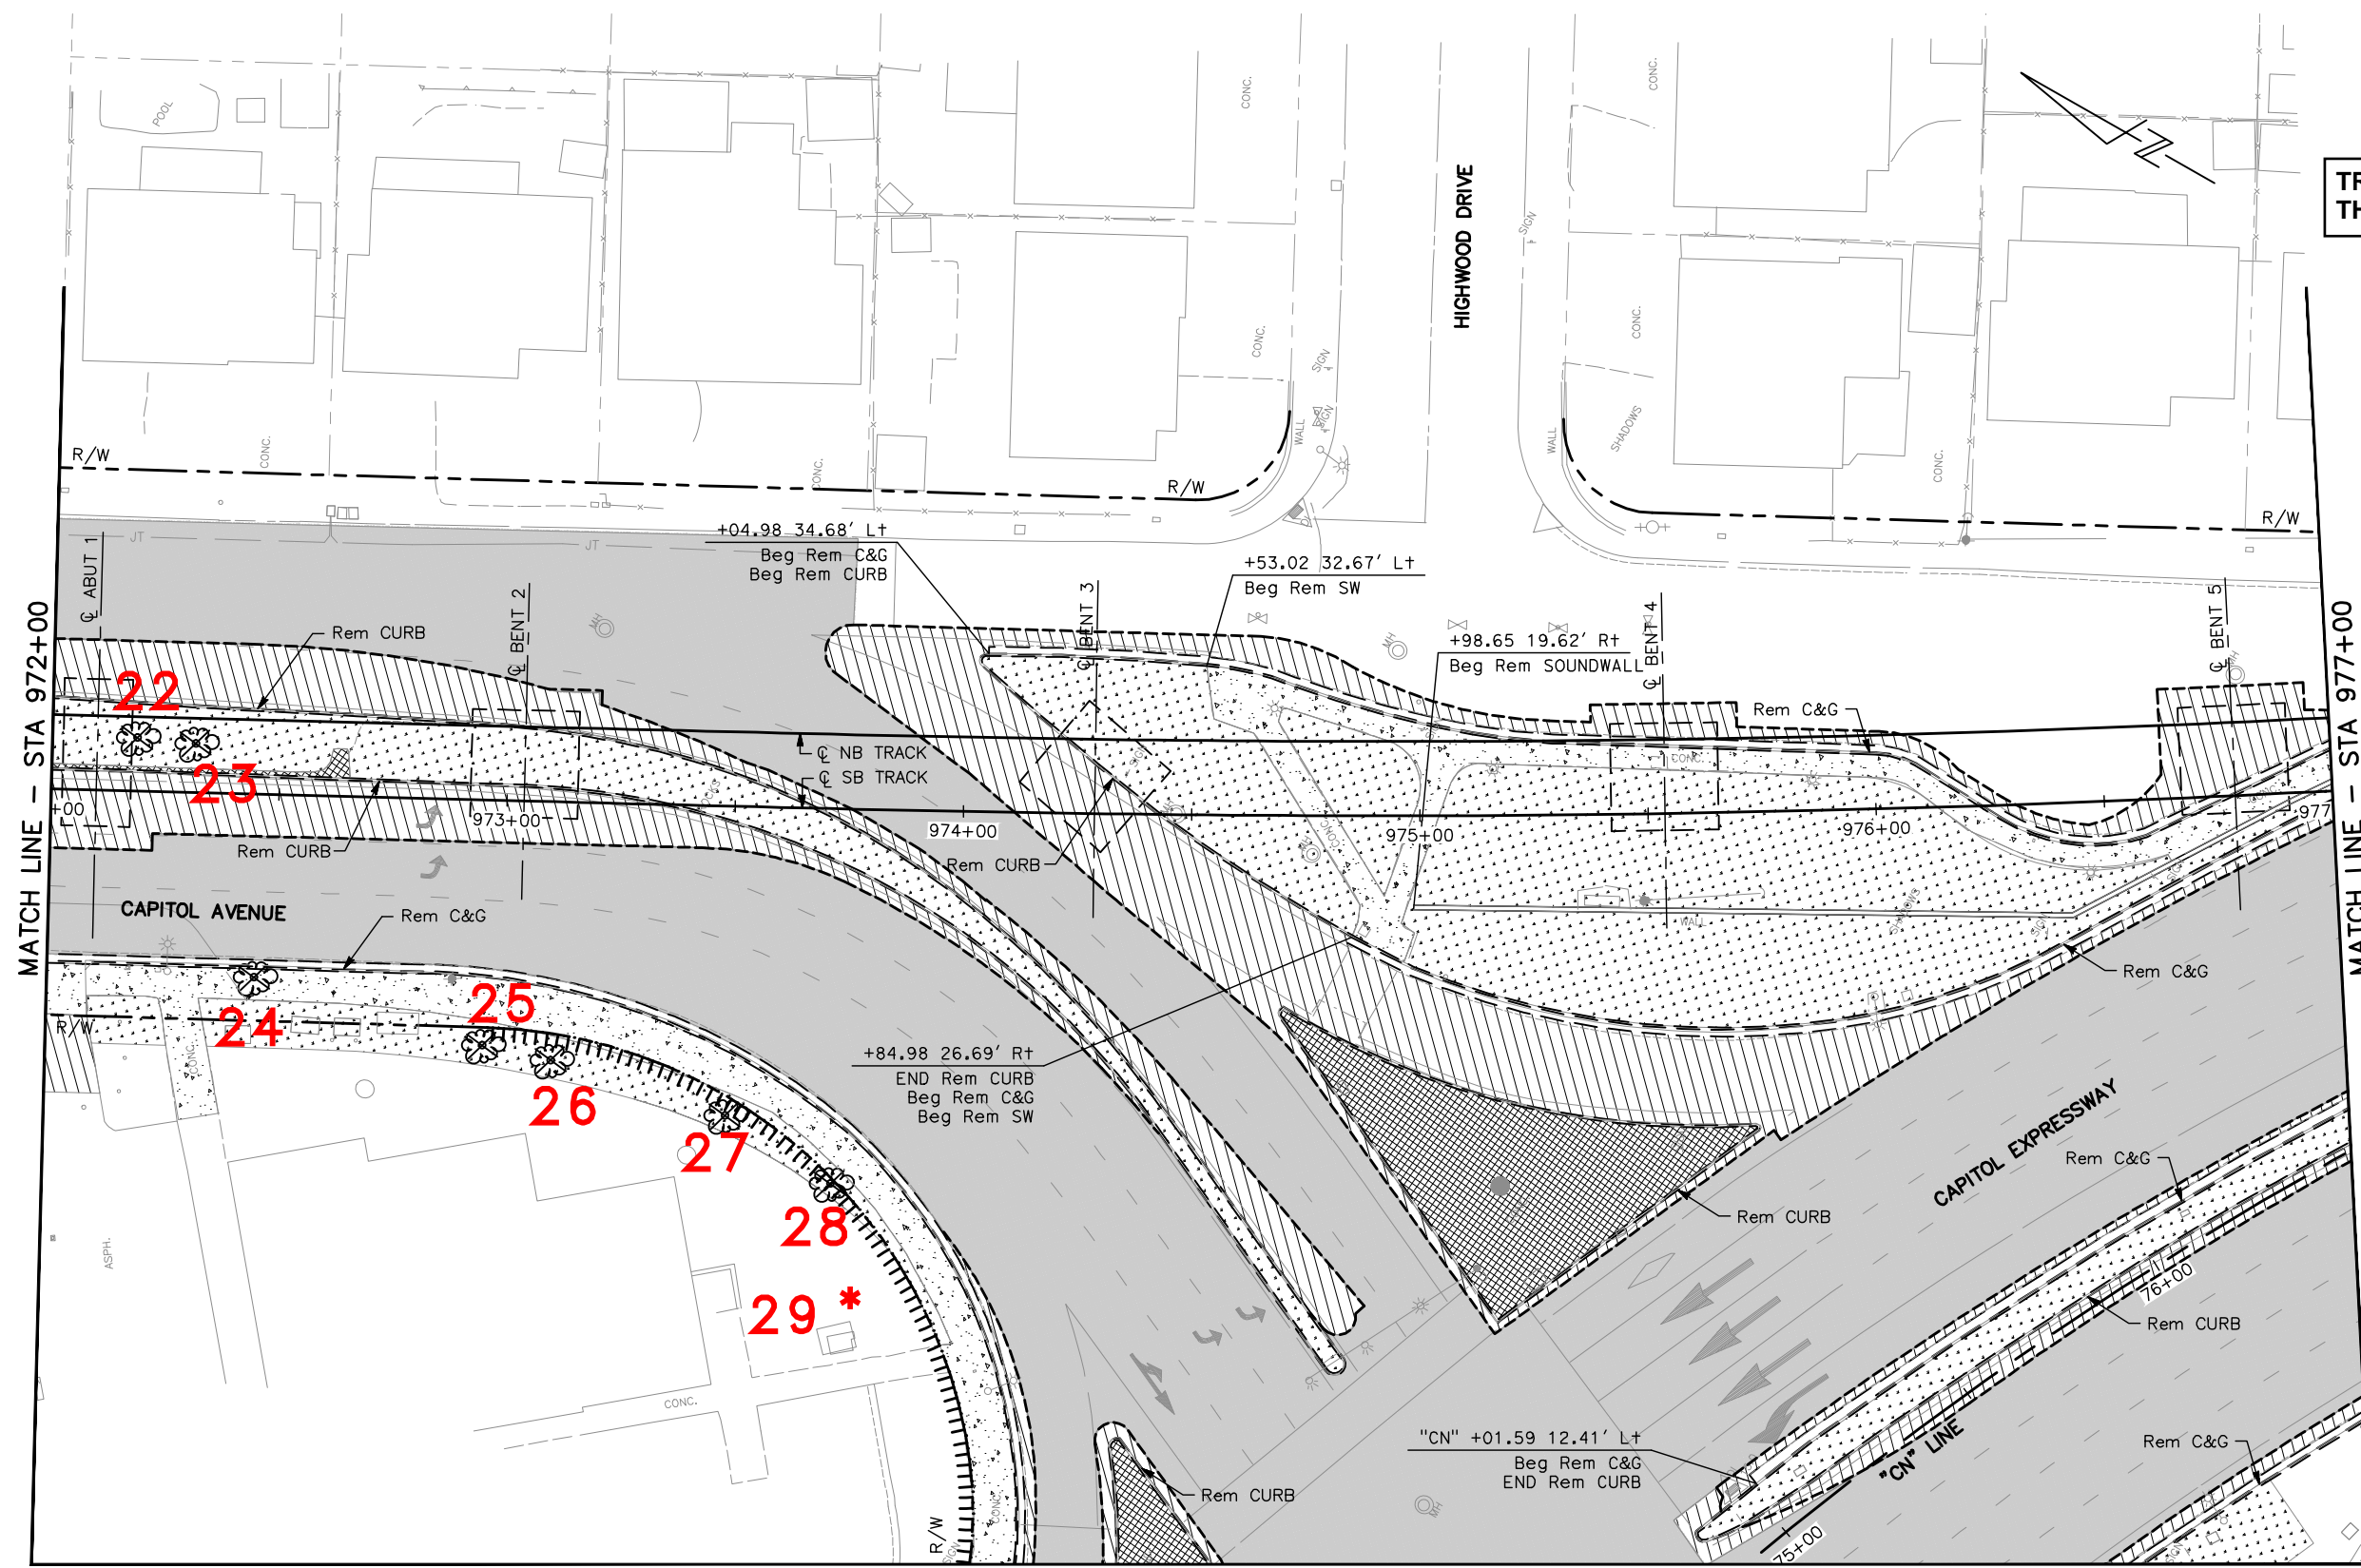

ALL DIMENSIONS ARE IN FEET UNLESS OTHERWISE SHOWN

HEIN Oct 17, 2019 - 8:53am K:\2016\167169\_VTA\_CELVENC\EXHIBITS\010\_Tree Demol Exhibits\601CR003.dwg

| NO. | DATE  | REVISIONS         |
|-----|-------|-------------------|
| B   | 03/19 | 65% SUBMITTAL SET |
| A   | 06/18 | 35% SUBMITTAL SET |

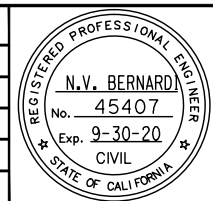

**BKF 100+ YEARS**  
ENGINEERS / SURVEYORS / PLANNERS

DESIGNED: C. Chi  
CHECKED: M. Cosentino  
DRAWN: A. Hernandez  
CADD FILE NAME: 801CR003.dwg



**BKF 100+ YEARS**  
ENGINEERS / SURVEYORS / PLANNERS

APPROVED: [Signature]  
CADD FILE DATE: 03/01/19  
SUBMITTAL DATE: 03/11/19  
SCALE: 1" = 20'  
BOARD APPROVAL DATE:


|   |                   |                           |   |
|---|-------------------|---------------------------|---|
| EASTRIDGE TO BART REGIONAL CONNECTOR<br>CAPITOL EXPRESSWAY LIGHT RAIL PROJECT<br>CIVIL<br>DEMOLITION PLAN<br>STA 972+00 TO STA 977+00 |                   |                           | SHEET OF<br>DRAWING NO. CR003<br>REVISION B |
| PCA NO. 000   | CONTRACT NO. C801 | FILE LOCATION PROJECTWISE |   |

MATCH LINE - SEE SHEET CR003


**NOTE:**

FOR DEMOLITION PLAN NOTES AND LEGEND, SEE DRAWING CR001.

**TREES TO BE REMOVED SHOWN ON THIS SHEET: 2**

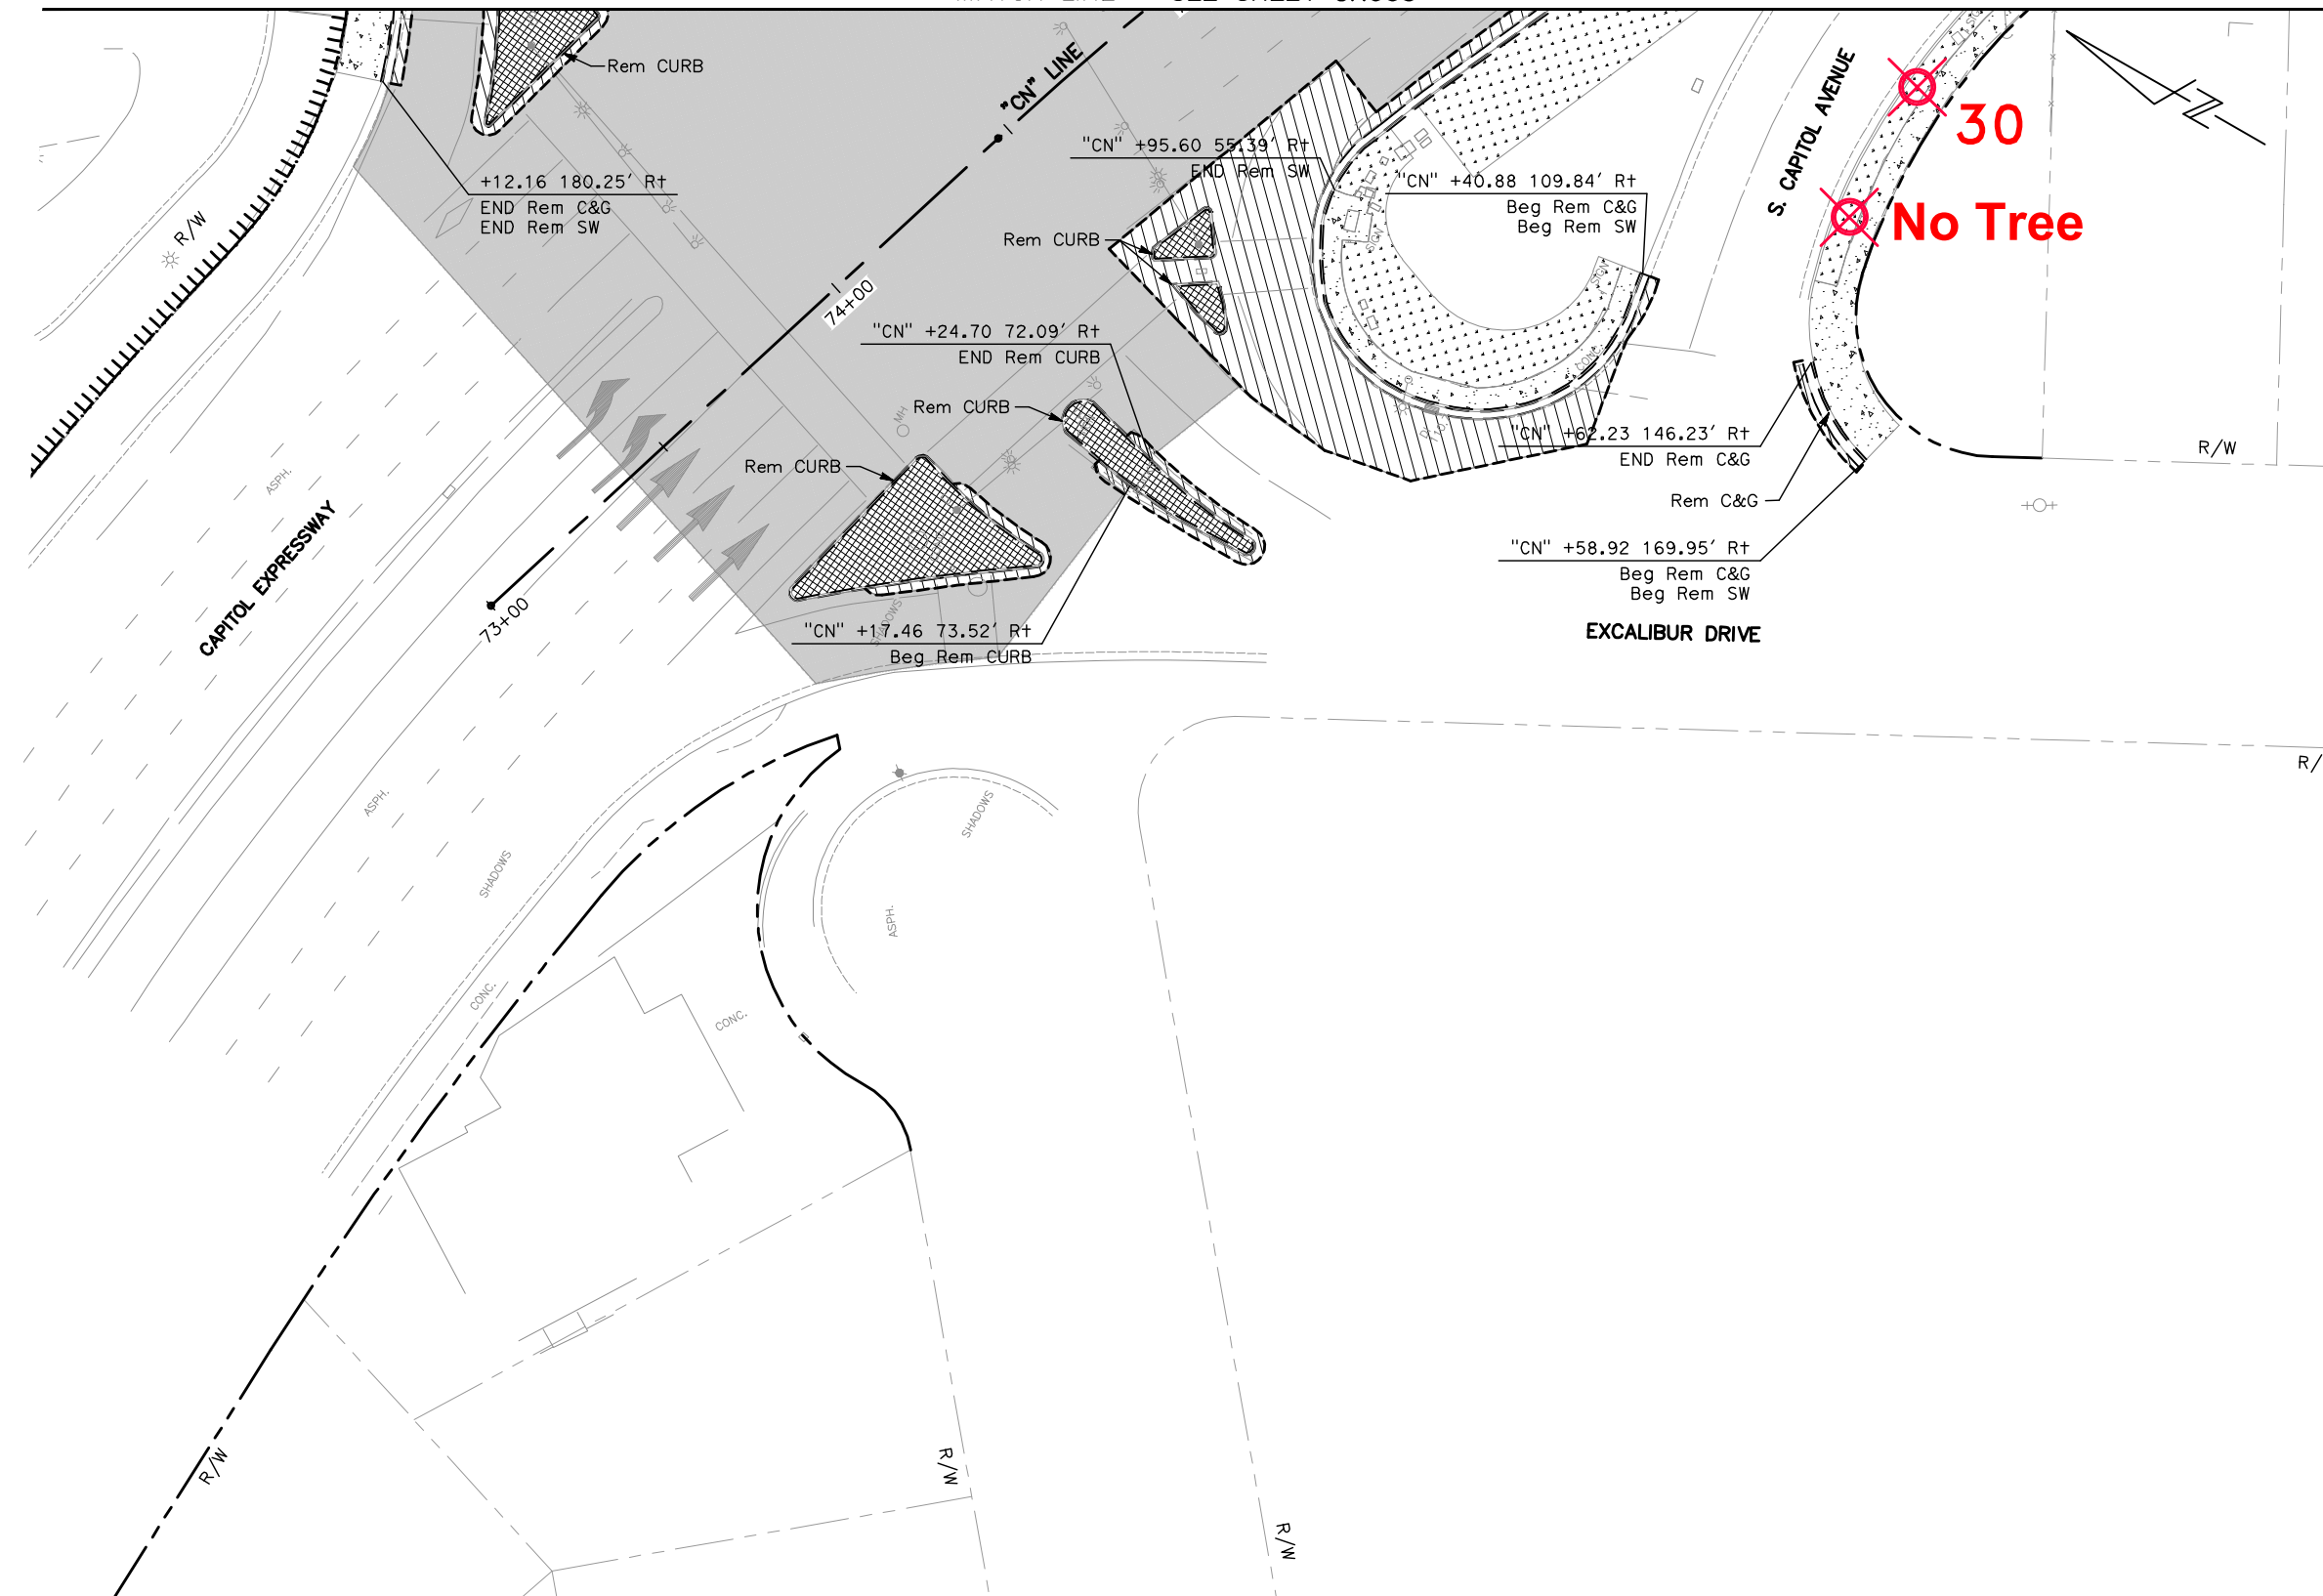


30  
No Tree

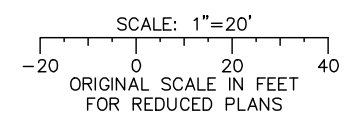

ALL DIMENSIONS ARE IN FEET UNLESS OTHERWISE SHOWN

HERN Oct 17, 2019 - 8:54am K:\2016\167169\_VTA\_GELVING\EXHIBITS\010\_Tree\_Demo\_Exhibits\601CR103.dwg

| NO. | DATE  | REVISIONS         |
|-----|-------|-------------------|
| B   | 03/19 | 65% SUBMITTAL SET |
| A   | 06/18 | 35% SUBMITTAL SET |

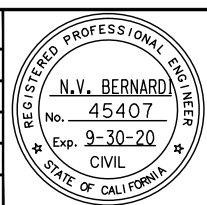

**BKF 100+ YEARS**  
ENGINEERS / SURVEYORS / PLANNERS

DESIGNED: C. Chi  
CHECKED: M. Cosentino  
DRAWN: A. Hernandez  
CADD FILE NAME: 801CR103.dwg



**BKF 100+ YEARS**  
ENGINEERS / SURVEYORS / PLANNERS


CADD FILE DATE: 03/01/19  
SCALE: 1" = 20'  
SUBMITTAL DATE: 03/11/19  
BOARD APPROVAL DATE:

|  |                      |                              |  |
|--|----------------------|------------------------------|--|
| EASTRIDGE TO BART REGIONAL CONNECTOR<br>CAPITOL EXPRESSWAY LIGHT RAIL PROJECT<br>CIVIL<br>DEMOLITION PLAN<br>EXCALIBUR DRIVE |                      |                              | SHEET<br>OF<br>DRAWING NO.<br>CR103<br>REVISION<br>B |
| PCA NO.<br>000   | CONTRACT NO.<br>C801 | FILE LOCATION<br>PROJECTWISE |  |


**NOTE:**

FOR DEMOLITION PLAN NOTES AND LEGEND, SEE DRAWING CR001.

**TREES TO BE REMOVED SHOWN ON THIS SHEET: 13**

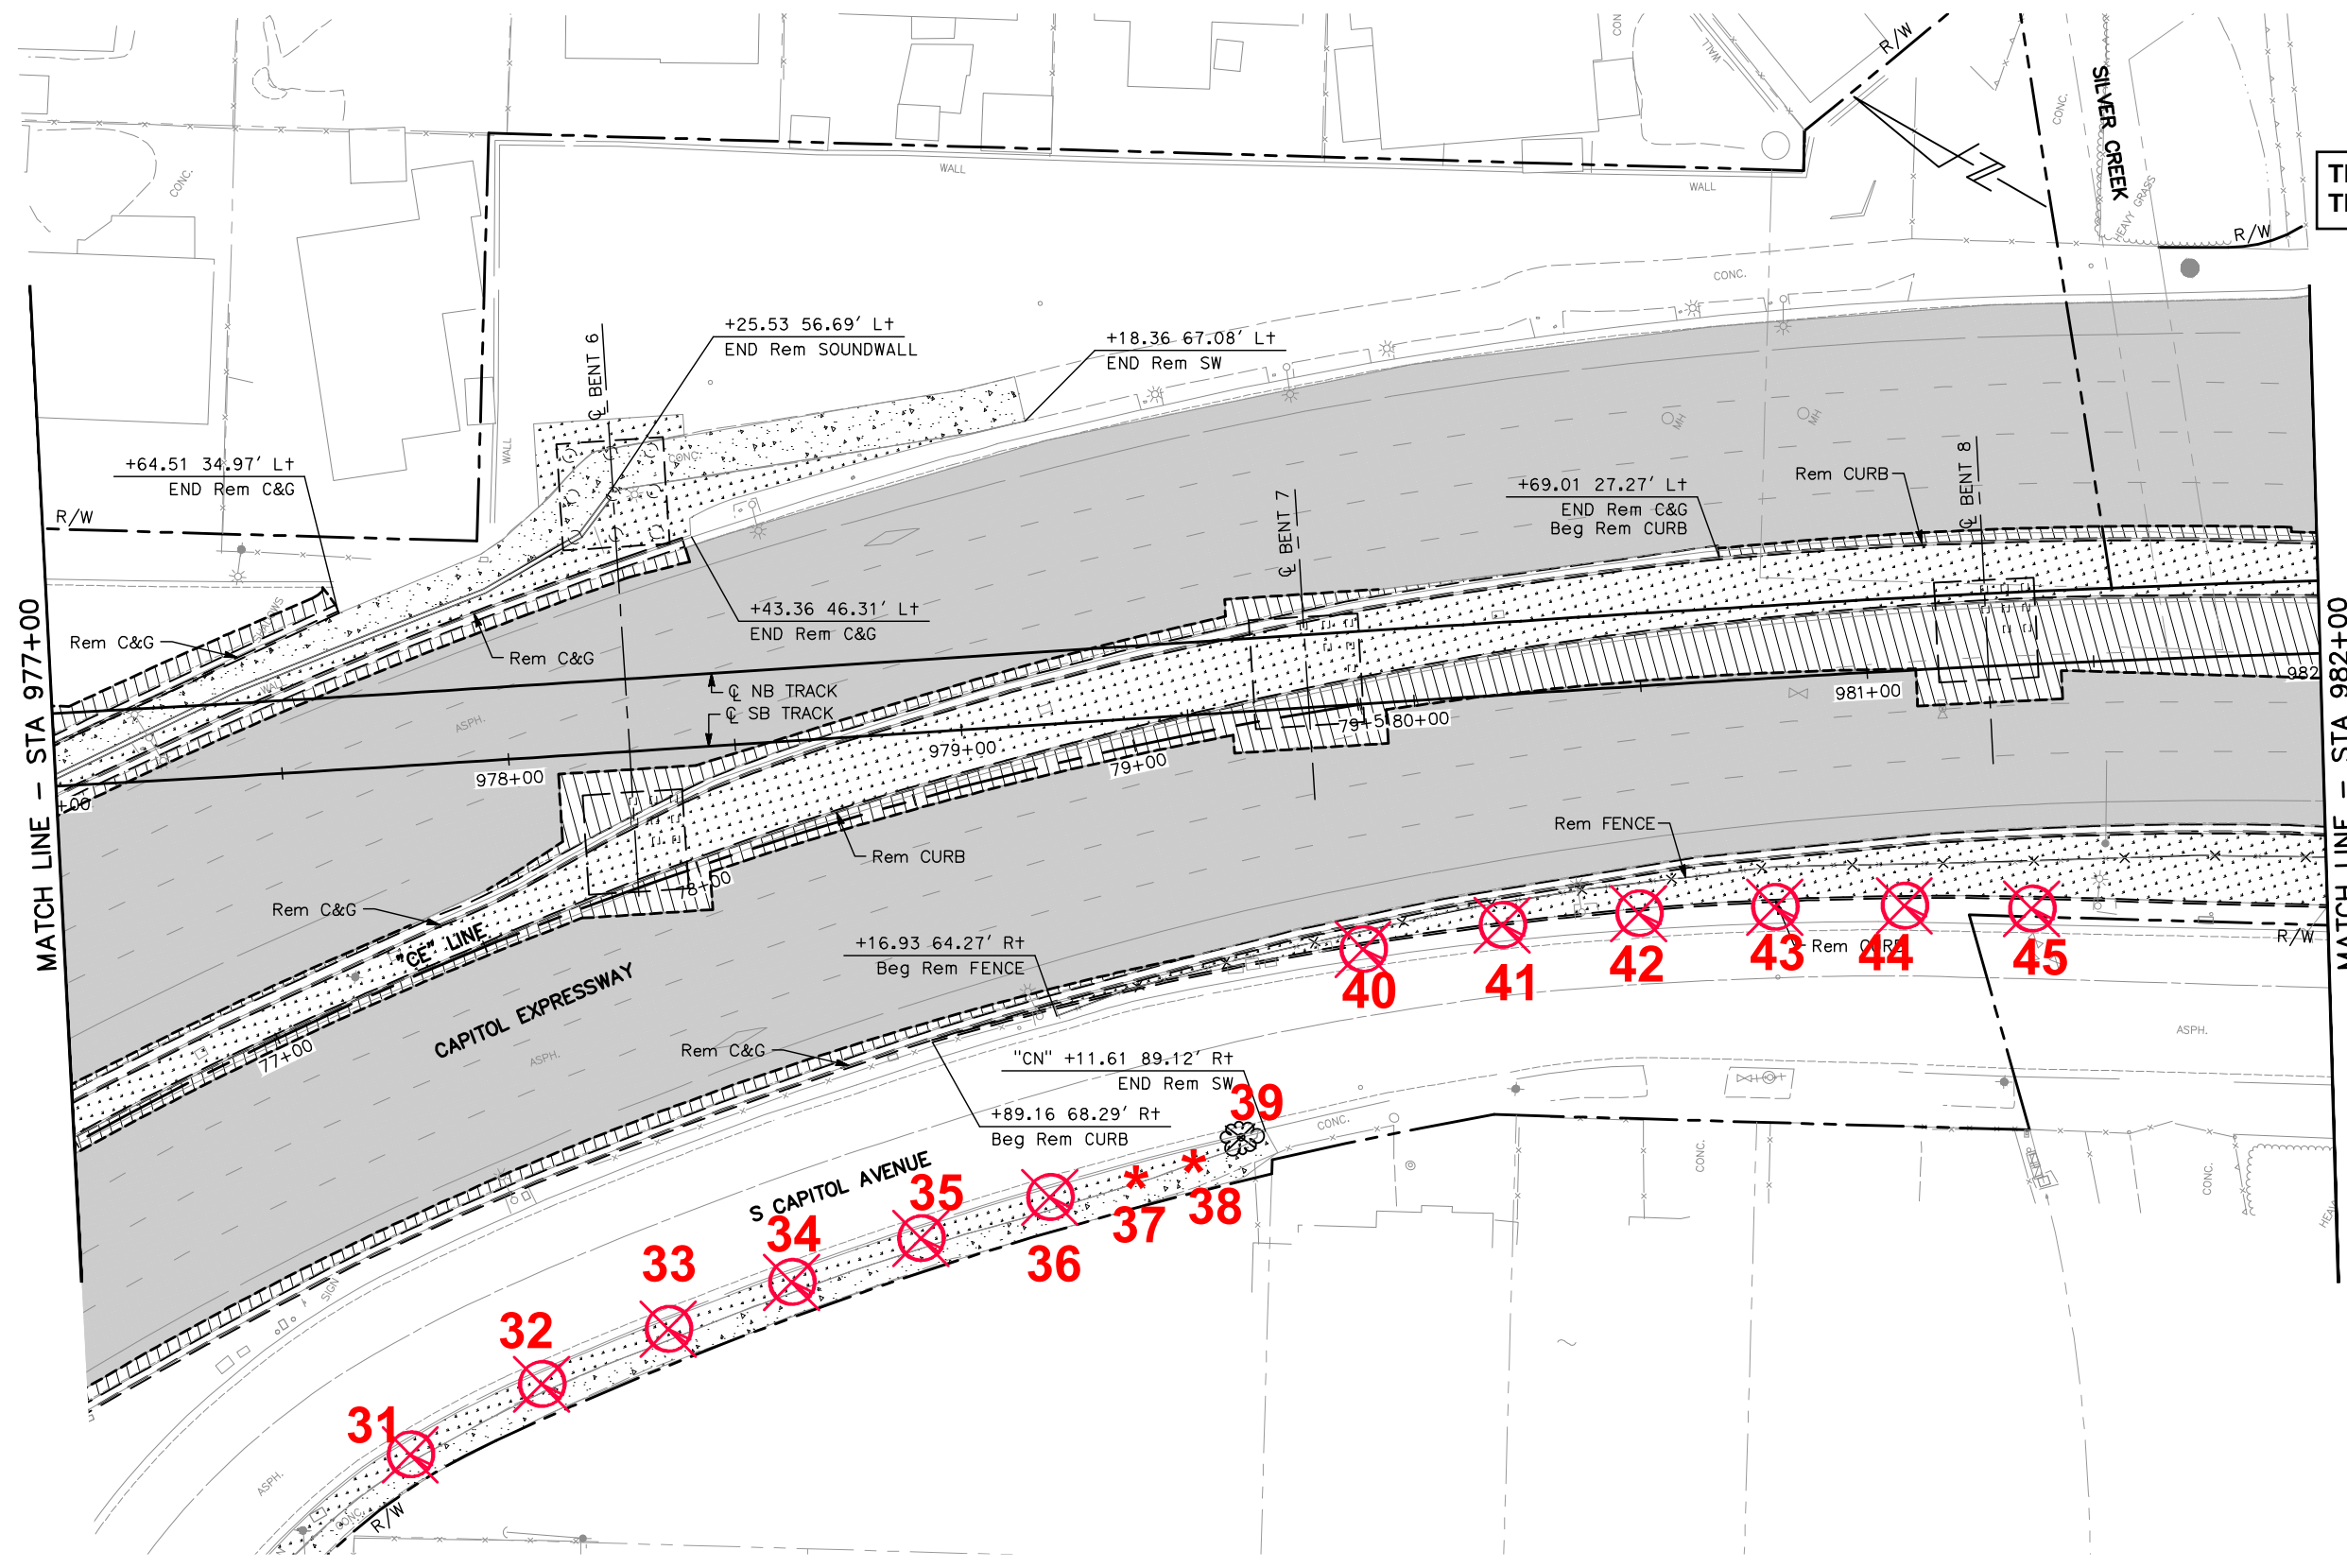


ALL DIMENSIONS ARE IN FEET UNLESS OTHERWISE SHOWN

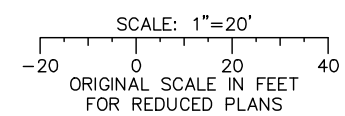

HERN Oct 17, 2019 - 8:55am K:\2016\167169\_VTA\_GELVENC\EXHIBITS\010\_Tree\_Demo\_Exhibits\601CR004.dwg

| NO. | DATE  | REVISIONS         |
|-----|-------|-------------------|
| B   | 03/19 | 65% SUBMITTAL SET |
| A   | 06/18 | 35% SUBMITTAL SET |

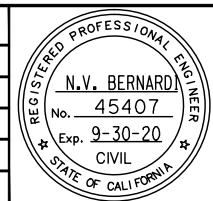

**BKF 100+ YEARS**  
ENGINEERS / SURVEYORS / PLANNERS

DESIGNED: C. Chi  
CHECKED: M. Cosentino  
DRAWN: A. Hernandez  
CADD FILE NAME: 801CR004.dwg



**BKF 100+ YEARS**  
ENGINEERS / SURVEYORS / PLANNERS



CADD FILE DATE: 03/01/19  
SCALE: 1" = 20'  
SUBMITTAL DATE: 03/11/19  
BOARD APPROVAL DATE:

|   |                   |                           |   |
|---|-------------------|---------------------------|---|
| EASTRIDGE TO BART REGIONAL CONNECTOR<br>CAPITOL EXPRESSWAY LIGHT RAIL PROJECT<br>CIVIL<br>DEMOLITION PLAN<br>STA 977+00 TO STA 982+00 |                   |                           | SHEET OF<br>DRAWING NO. CR004<br>REVISION B |
| PCA NO. 000   | CONTRACT NO. C801 | FILE LOCATION PROJECTWISE |   |

**NOTE:**

FOR DEMOLITION PLAN NOTES AND LEGEND, SEE DRAWING CR001.


**TREES TO BE REMOVED SHOWN ON THIS SHEET: 12**

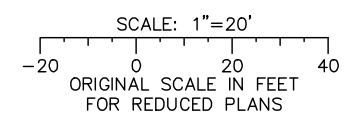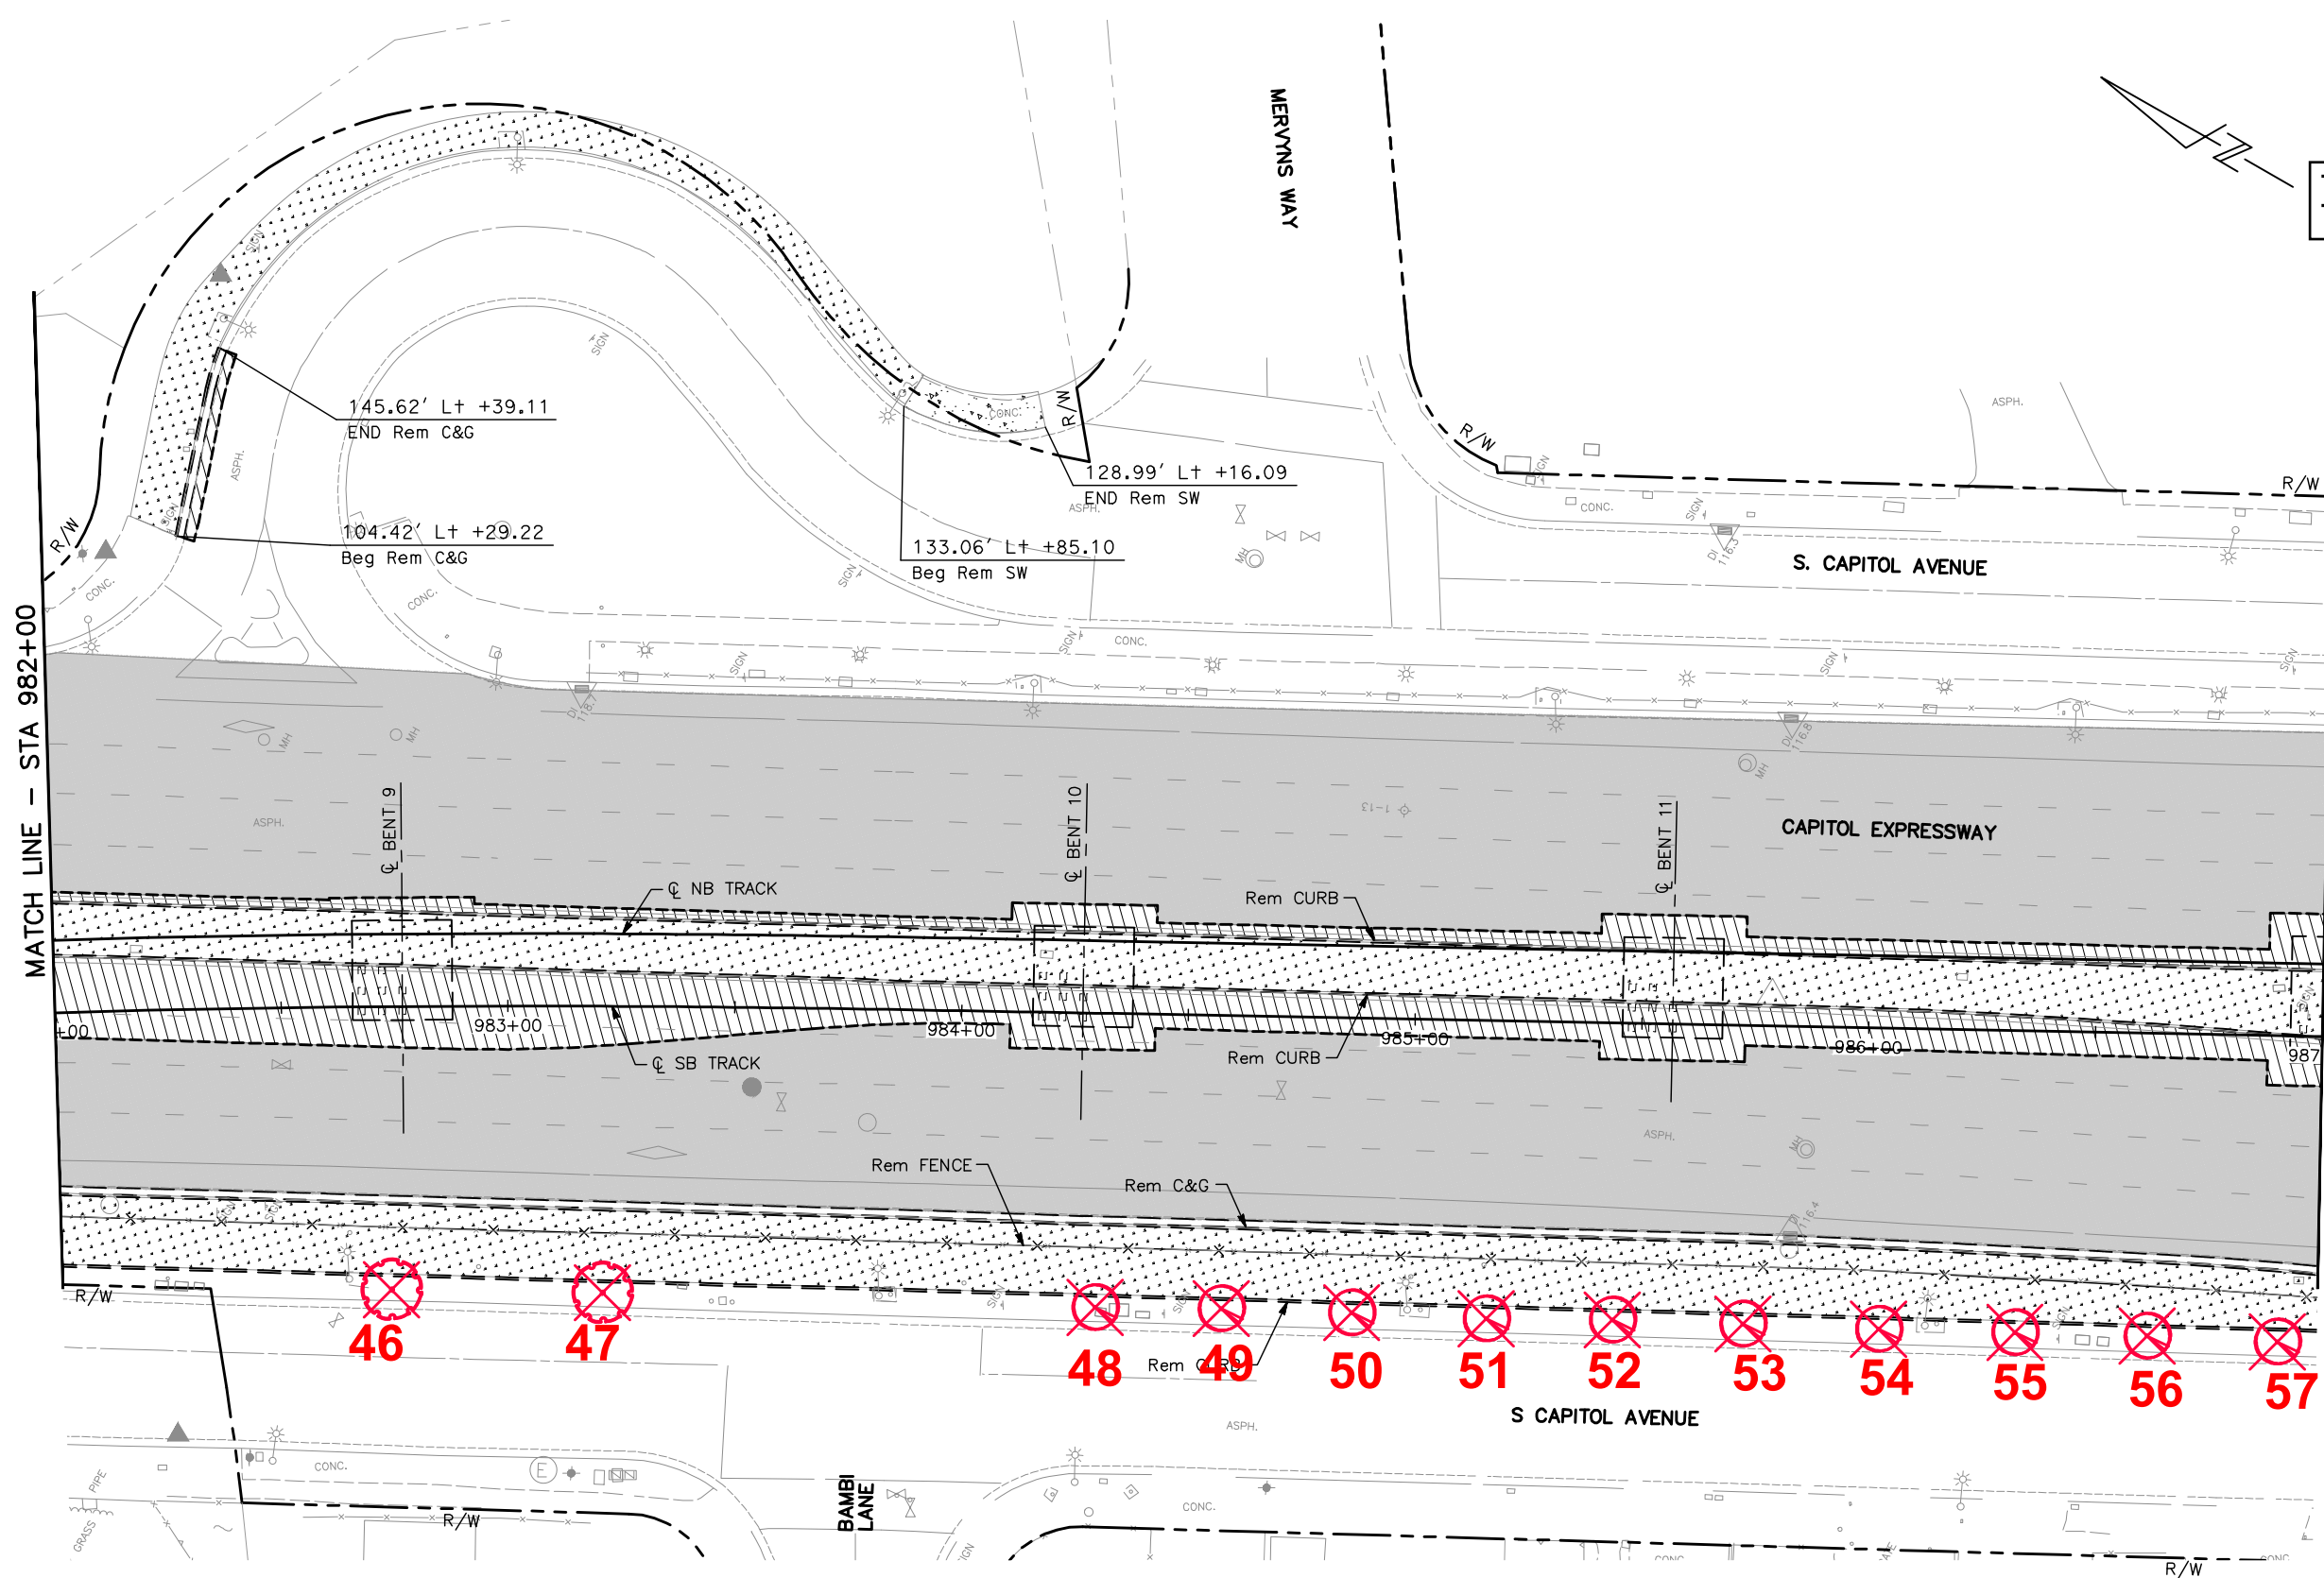

ALL DIMENSIONS ARE IN FEET UNLESS OTHERWISE SHOWN

HEIN Oct 17, 2019 - 8:55am K:\2016\167169\_VTA\_GELVENC\EXHIBITS\010\_Tree Demolition Exhibits\010CR005.dwg

| NO. | DATE  | REVISIONS         |
|-----|-------|-------------------|
| B   | 03/19 | 65% SUBMITTAL SET |
| A   | 06/18 | 35% SUBMITTAL SET |

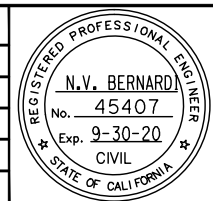

**BKF 100+ YEARS**  
**ENGINEERS / SURVEYORS / PLANNERS**

DESIGNED: C. Chi  
 CHECKED: M. Cosentino  
 DRAWN: A. Hernandez  
 CADD FILE NAME: 801CR005.dwg



**BKF 100+ YEARS**  
**ENGINEERS / SURVEYORS / PLANNERS**


CADD FILE DATE: 03/01/19  
 SUBMITTAL DATE: 03/11/19  
 SCALE: 1" = 20'  
 BOARD APPROVAL DATE:

|   |                      |                              |  |
|---|----------------------|------------------------------|--|
| EASTRIDGE TO BART REGIONAL CONNECTOR<br>CAPITOL EXPRESSWAY LIGHT RAIL PROJECT<br>CIVIL<br>DEMOLITION PLAN<br>STA 982+00 TO STA 987+00 |                      |                              | SHEET<br>OF<br>DRAWING NO.<br>CR005<br>REVISION<br>B |
| PCA NO.<br>000  | CONTRACT NO.<br>C801 | FILE LOCATION<br>PROJECTWISE |  |



**NOTE:**  
FOR DEMOLITION PLAN NOTES AND LEGEND, SEE DRAWING CR001.


**TREES TO BE REMOVED SHOWN ON THIS SHEET: 5**

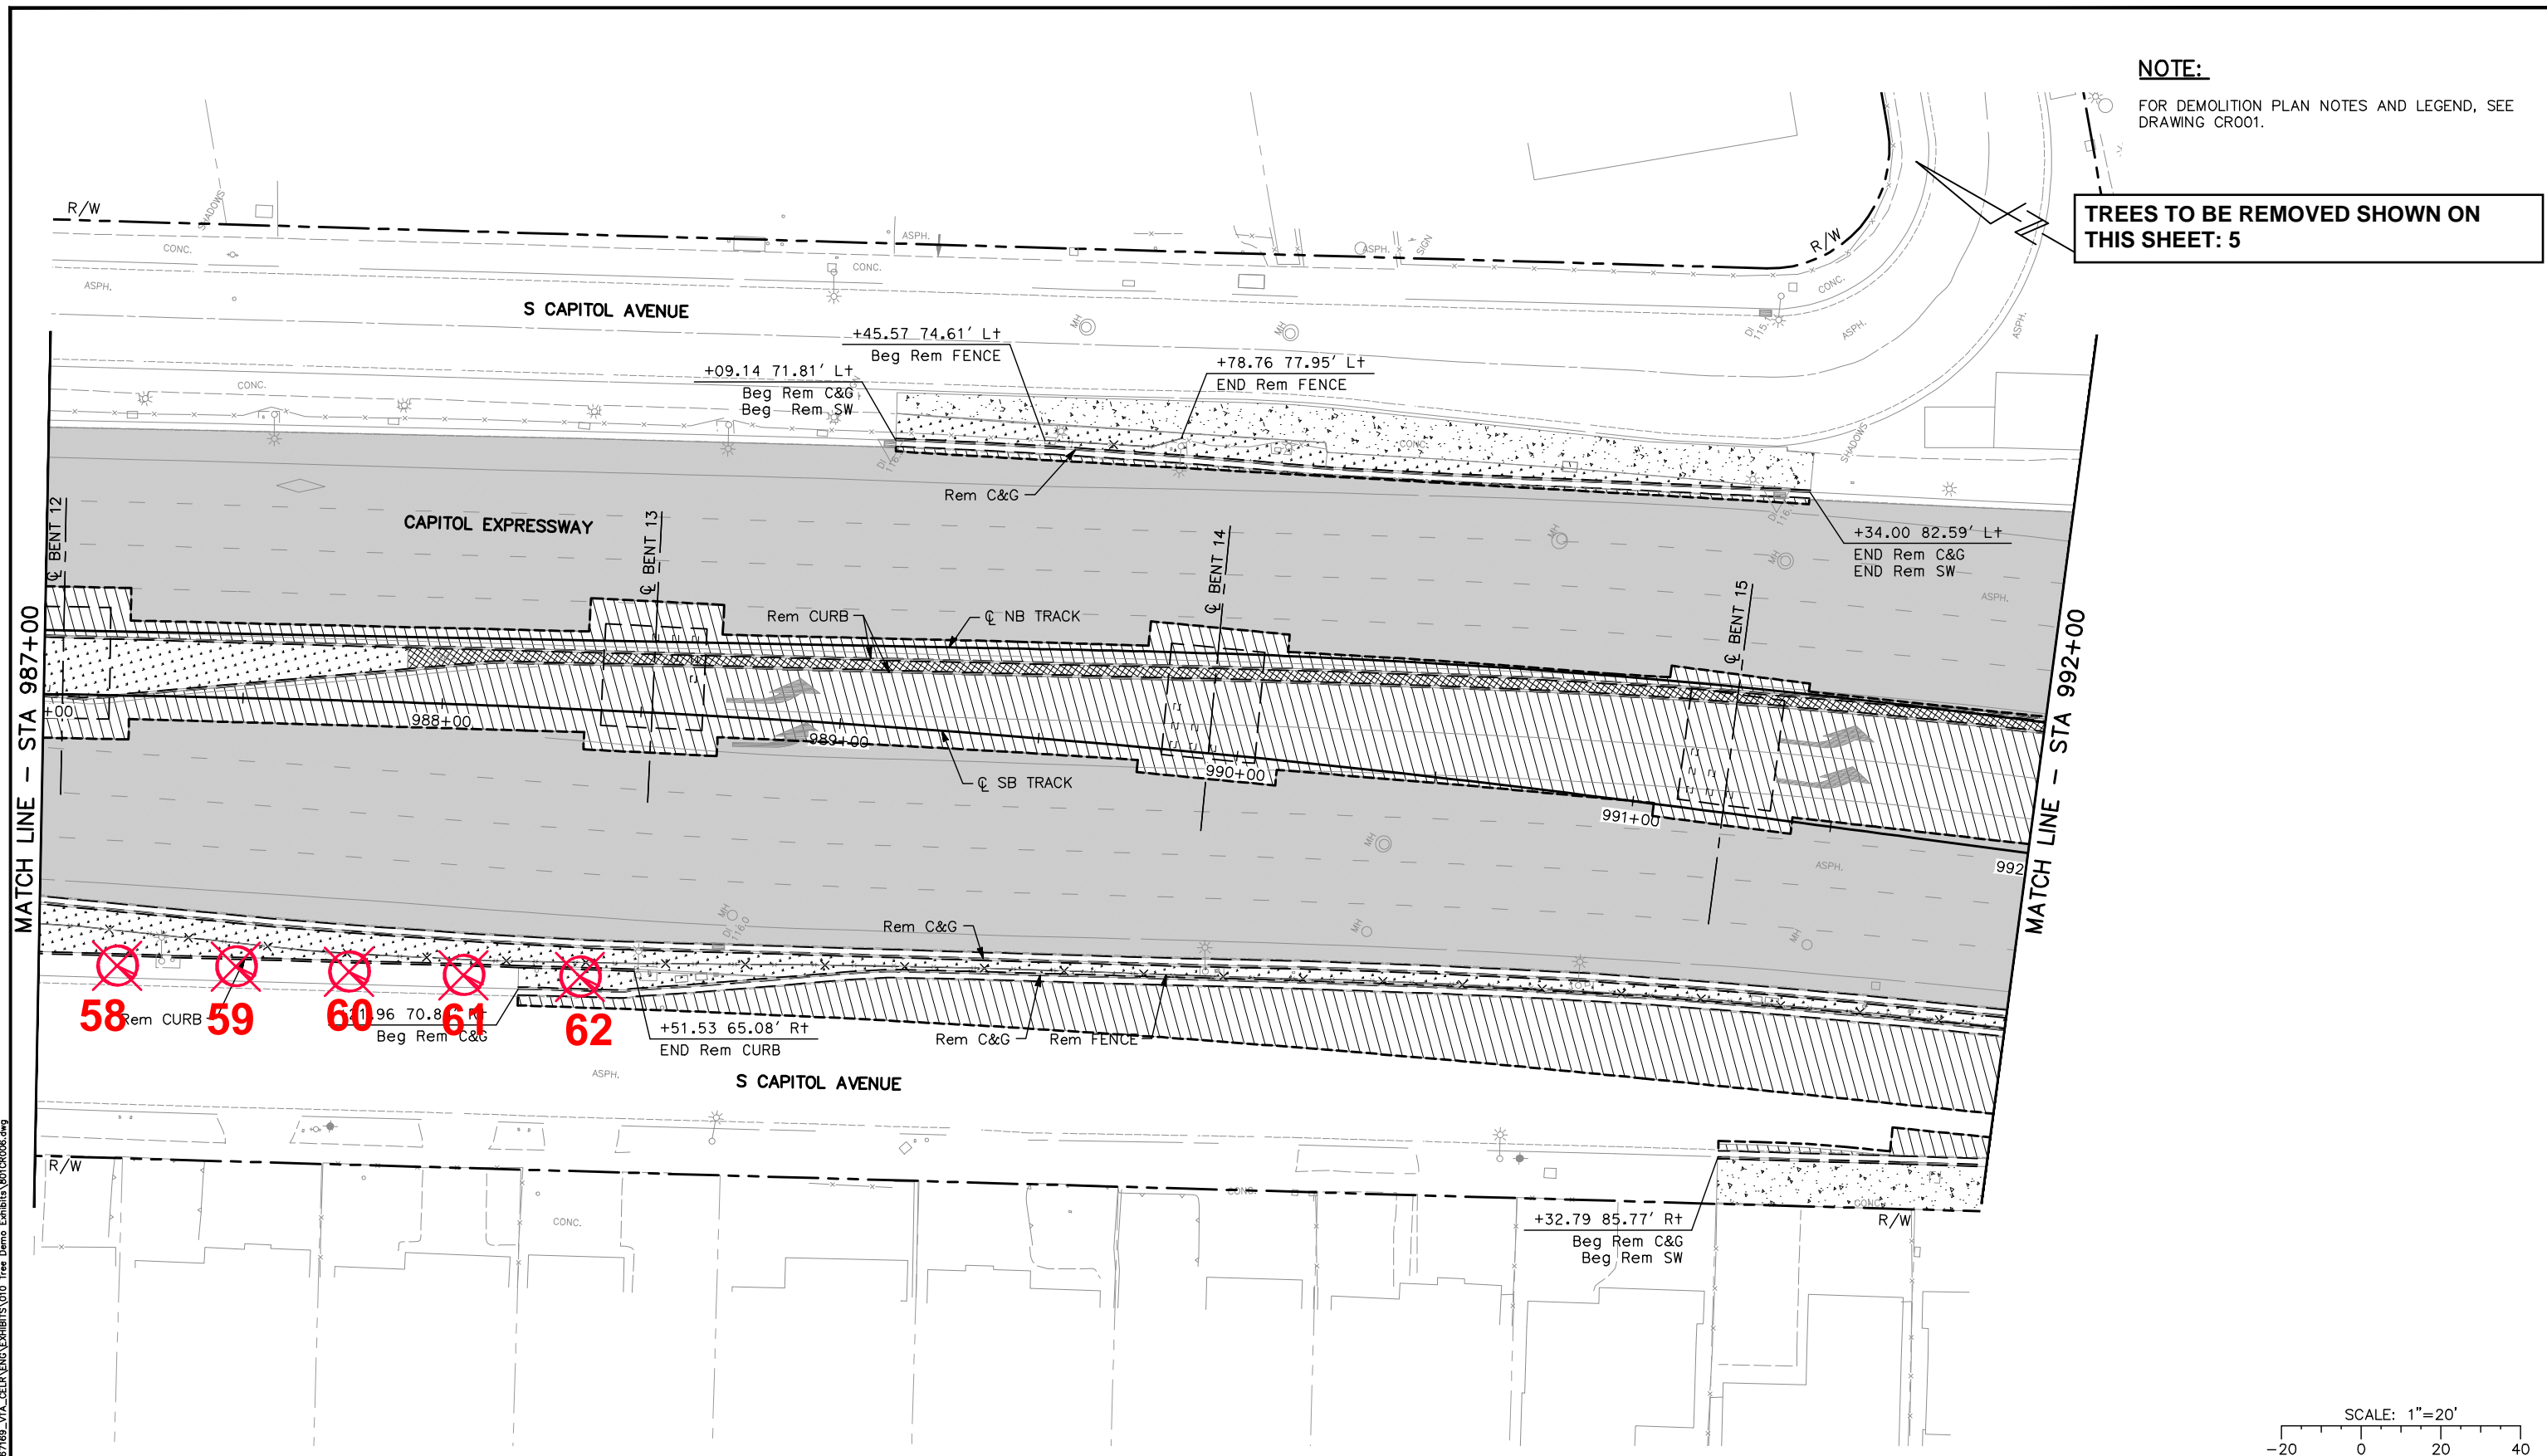

MATCH LINE - STA 987+00


MATCH LINE - STA 992+00

ALL DIMENSIONS ARE IN FEET UNLESS OTHERWISE SHOWN

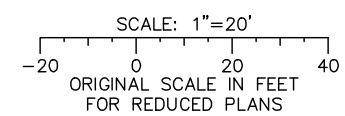

HEIN Oct 17, 2019 - 8:56am K:\2019\187169\_187169\_VTA\_CELVENC\EXHIBITS\010\_Tree Demolition Exhibits\010CR006.dwg

| NO. | DATE  | REVISIONS         |
|-----|-------|-------------------|
| B   | 03/19 | 65% SUBMITTAL SET |
| A   | 06/18 | 35% SUBMITTAL SET |

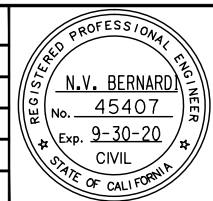

**BKF 100+ YEARS**  
ENGINEERS / SURVEYORS / PLANNERS

DESIGNED: C. Chi  
CHECKED: M. Cosentino  
DRAWN: A. Hernandez  
CADD FILE NAME: 801CR006.dwg



**BKF 100+ YEARS**  
ENGINEERS / SURVEYORS / PLANNERS


CADD FILE DATE: 03/01/19  
SCALE: 1" = 20'  
SUBMITTAL DATE: 03/11/19  
BOARD APPROVAL DATE:

|   |                      |                              |  |
|---|----------------------|------------------------------|--|
| EASTRIDGE TO BART REGIONAL CONNECTOR<br>CAPITOL EXPRESSWAY LIGHT RAIL PROJECT<br>CIVIL<br>DEMOLITION PLAN<br>STA 987+00 TO STA 992+00 |                      |                              | SHEET<br>OF<br>DRAWING NO.<br>CR006<br>REVISION<br>B |
| PCA NO.<br>000  | CONTRACT NO.<br>C801 | FILE LOCATION<br>PROJECTWISE |  |

**NOTE:**


FOR DEMOLITION PLAN NOTES AND LEGEND, SEE DRAWING CR001.


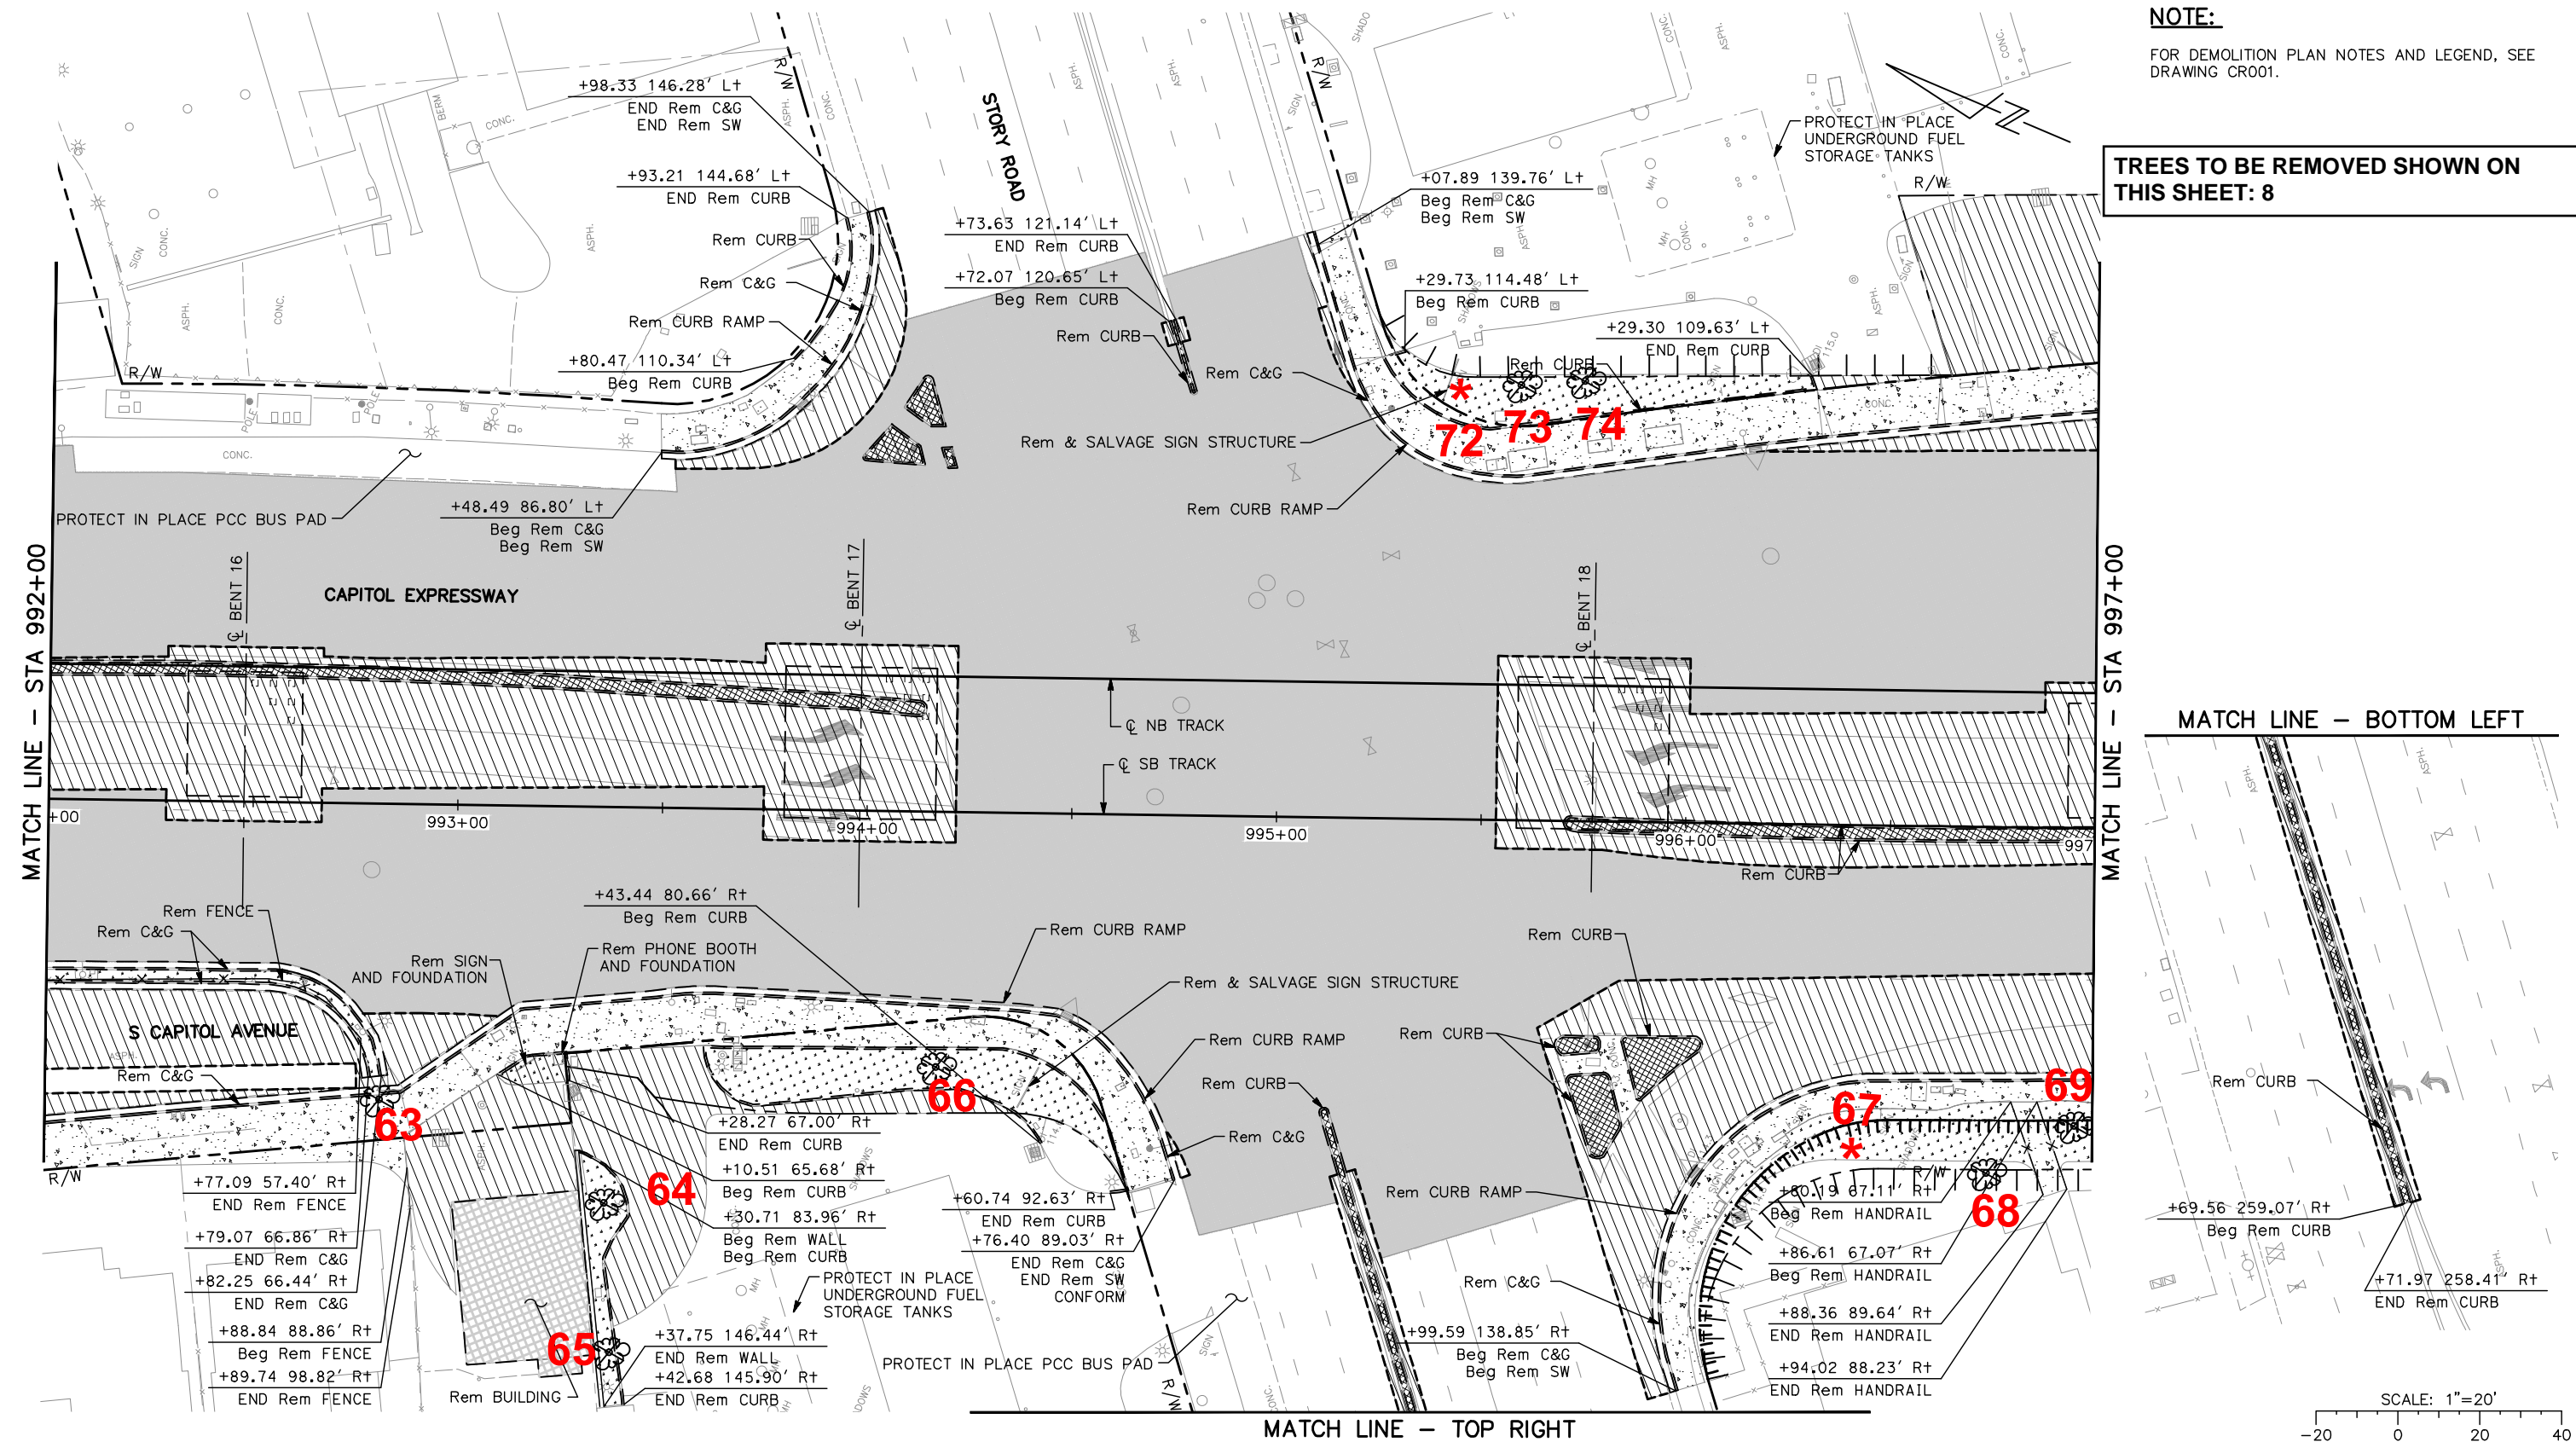

MATCH LINE - BOTTOM LEFT


MATCH LINE - TOP RIGHT

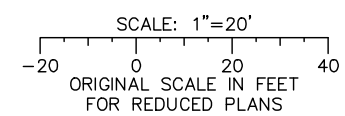

ALL DIMENSIONS ARE IN FEET UNLESS OTHERWISE SHOWN

HEIN Oct 17, 2019 - 8:57am K:\2016\167169\_VTA\_GELVENC\EXHIBITS\010\_Tree\_Demo\_Exhibits\01CR007.dwg

| NO. | DATE  | REVISIONS         |
|-----|-------|-------------------|
| B   | 03/19 | 65% SUBMITTAL SET |
| A   | 06/18 | 35% SUBMITTAL SET |

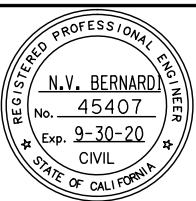

SUBMITTED

**BKF 100+ YEARS**  
ENGINEERS / SURVEYORS / PLANNERS

DESIGNED: C. Chi  
CHECKED: M. Cosentino  
DRAWN: A. Hernandez  
CADD FILE NAME: 801CR007.dwg

Santa Clara Valley  
Transportation  
Authority

APPROVED

**BKF 100+ YEARS**  
ENGINEERS / SURVEYORS / PLANNERS

CADD FILE DATE: 03/01/19  
SUBMITTAL DATE: 03/11/19  
SCALE: 1" = 20'  
BOARD APPROVAL DATE:


EASTRIDGE TO BART REGIONAL CONNECTOR  
CAPITOL EXPRESSWAY LIGHT RAIL PROJECT  
CIVIL  
DEMOLITION PLAN  
STA 992+00 TO STA 997+00

PLA NO: 000  
CONTRACT NO: C801  
FILE LOCATION: PROJECTWISE


|             |       |
|-------------|-------|
| SHEET OF    | CR007 |
| DRAWING NO. | CR007 |
| REVISION    | B     |

**NOTE:**  
FOR DEMOLITION PLAN NOTES AND LEGEND, SEE DRAWING CP001.


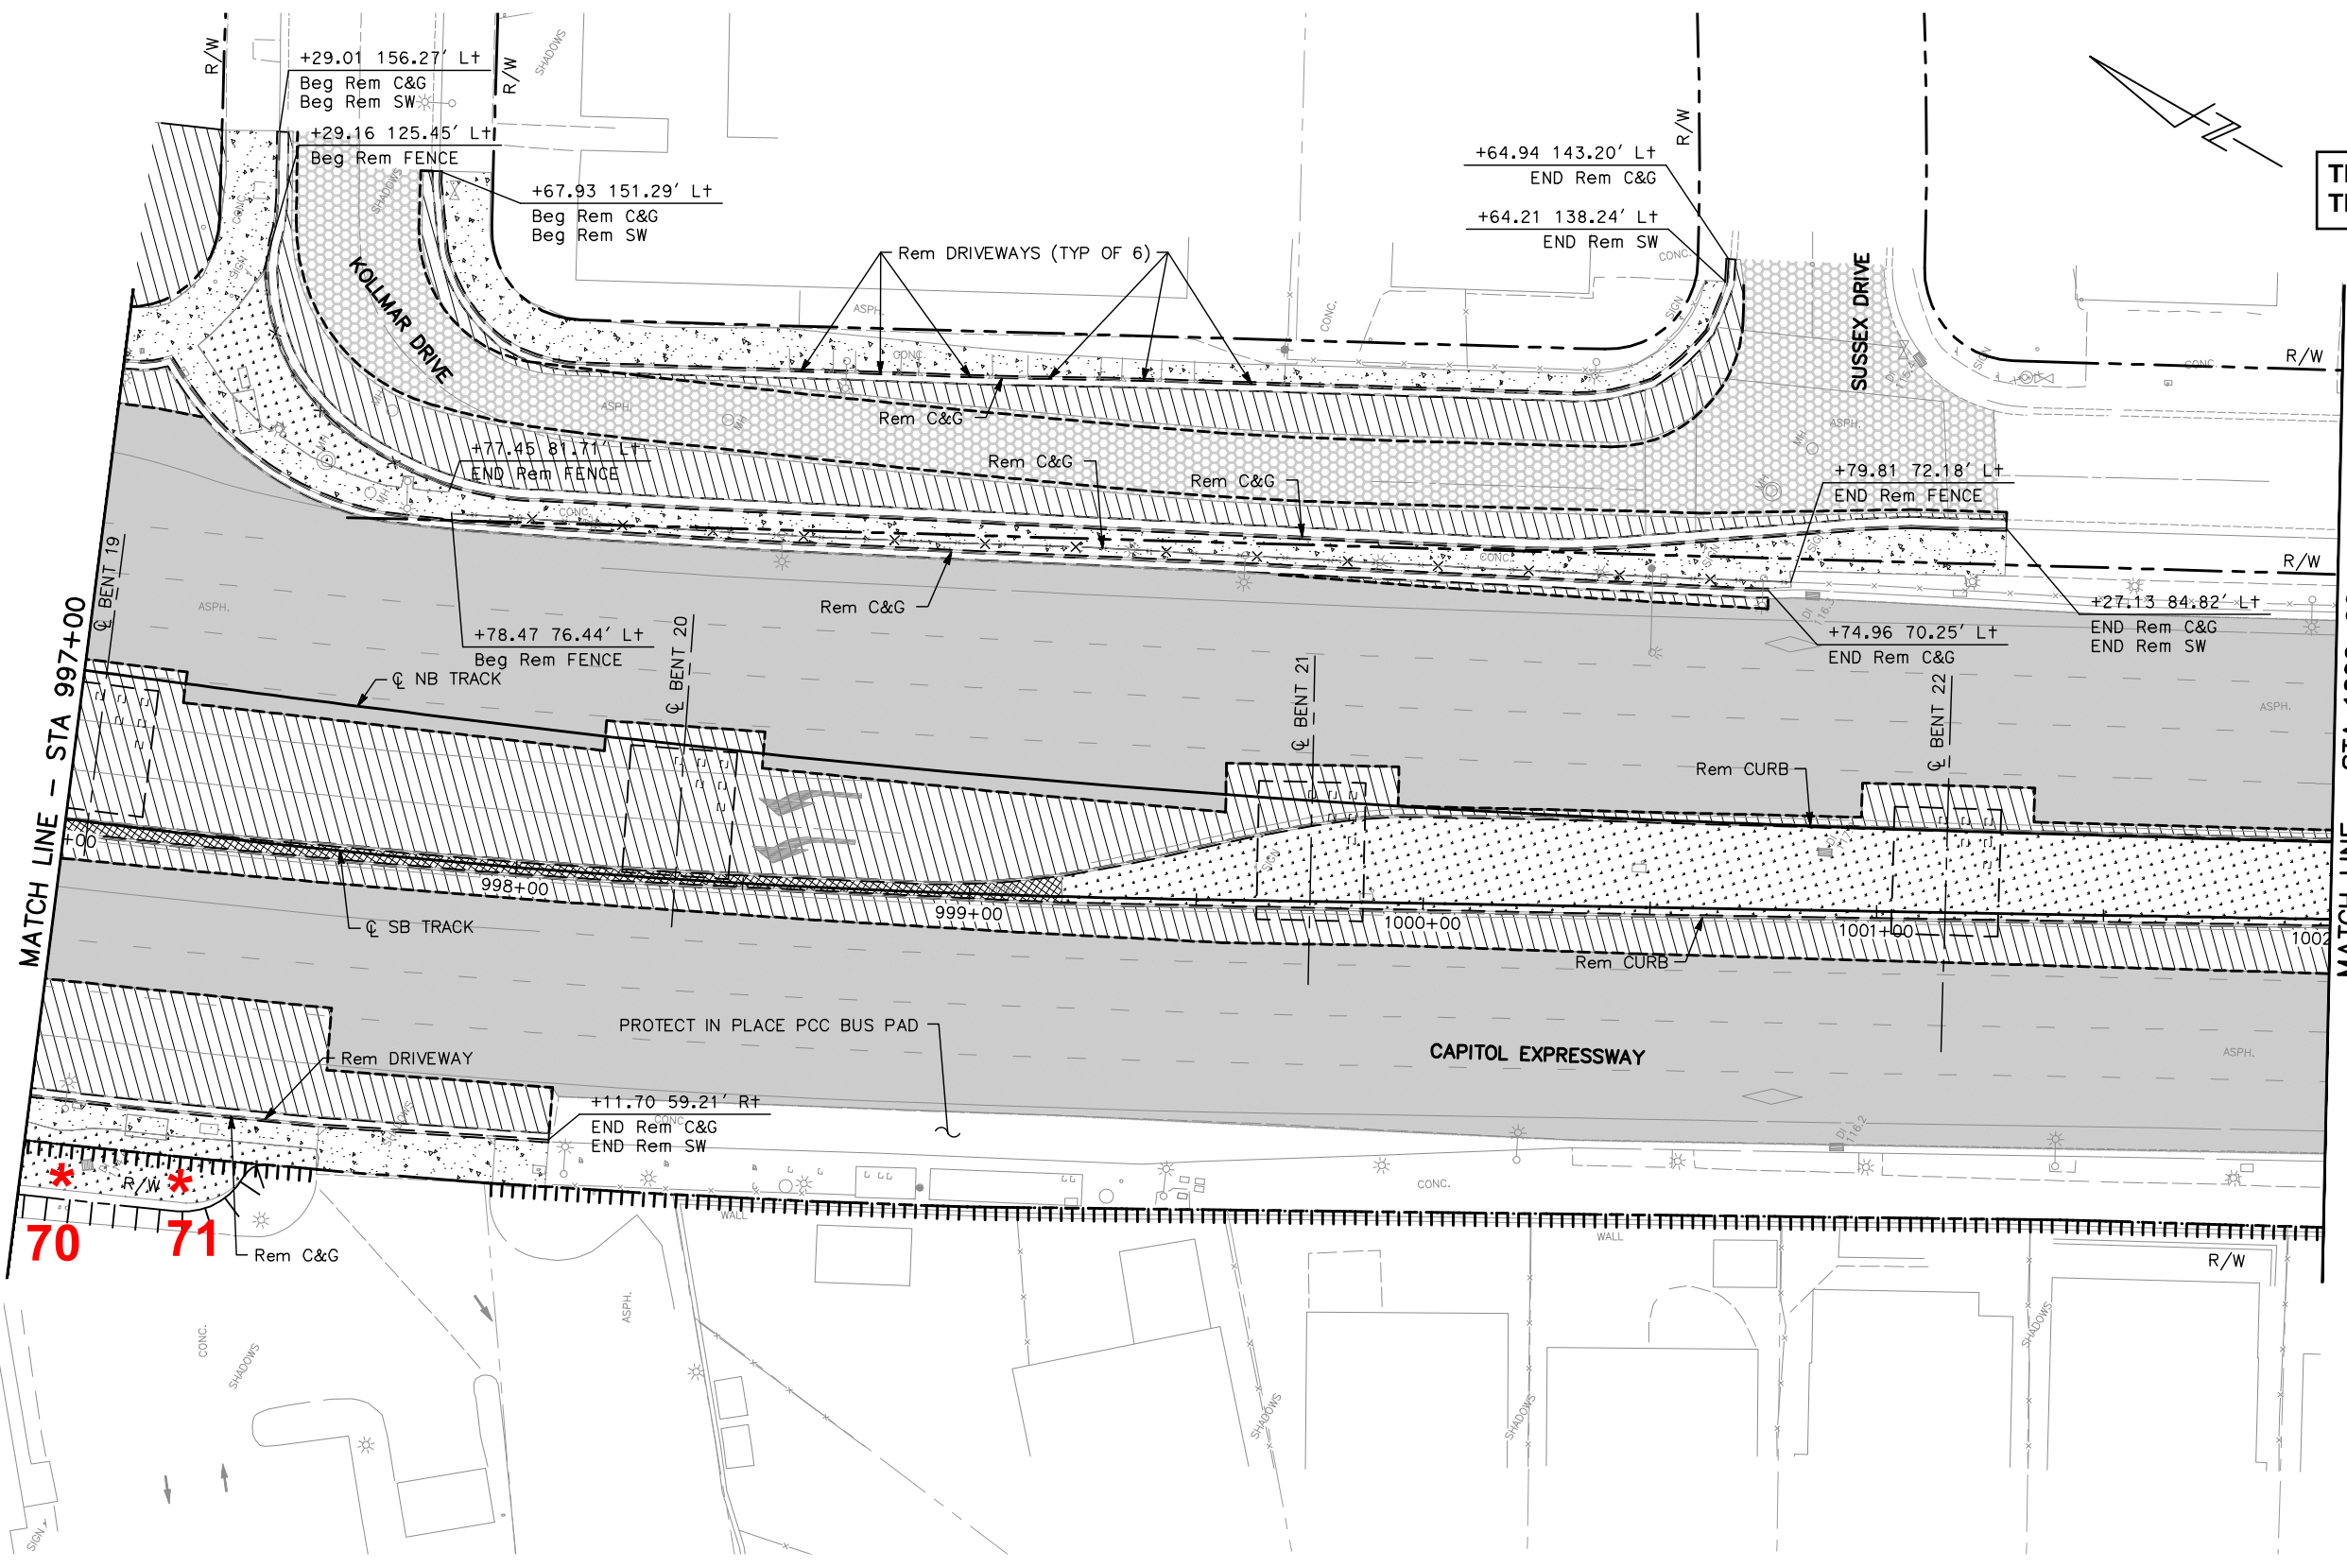


ALL DIMENSIONS ARE IN FEET UNLESS OTHERWISE SHOWN

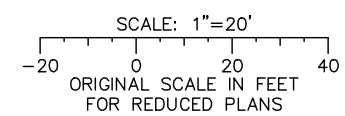

HERN Oct 17, 2019 - 8:55am K:\2019\167169\_VTA\_CELVENC\EXHIBITS\010\_Tree Demo Exhibits\010CR008.dwg

| NO. | DATE  | REVISIONS         |
|-----|-------|-------------------|
| B   | 03/19 | 65% SUBMITTAL SET |
| A   | 06/18 | 35% SUBMITTAL SET |

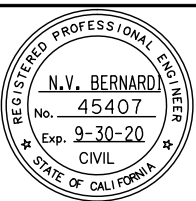

**BKF 100+ YEARS**  
ENGINEERS / SURVEYORS / PLANNERS

DESIGNED: C. Chi  
CHECKED: M. Cosentino  
DRAWN: A. Hernandez  
CADD FILE NAME: 801CR008.dwg



**BKF 100+ YEARS**  
ENGINEERS / SURVEYORS / PLANNERS

CADD FILE DATE: 03/01/19  
SCALE: 1" = 20'  
SUBMITTAL DATE: 03/11/19  
BOARD APPROVAL DATE:

EASTRIDGE TO BART REGIONAL CONNECTOR  
CAPITOL EXPRESSWAY LIGHT RAIL PROJECT  
CIVIL  
DEMOLITION PLAN  
STA 997+00 TO STA 1002+00

|             |       |
|-------------|-------|
| SHEET OF    |       |
| DRAWING NO. | CR008 |
| REVISION    | B     |


|         |     |              |      |               |             |
|---------|-----|--------------|------|---------------|-------------|
| PCA NO. | 000 | CONTRACT NO. | C801 | FILE LOCATION | PROJECTWISE |
|---------|-----|--------------|------|---------------|-------------|

MATCH LINE - SEE RIGHT

**NOTE:**

FOR DEMOLITION PLAN NOTES AND LEGEND, SEE DRAWING CR001.


**TREES TO BE REMOVED SHOWN ON THIS SHEET: 5**

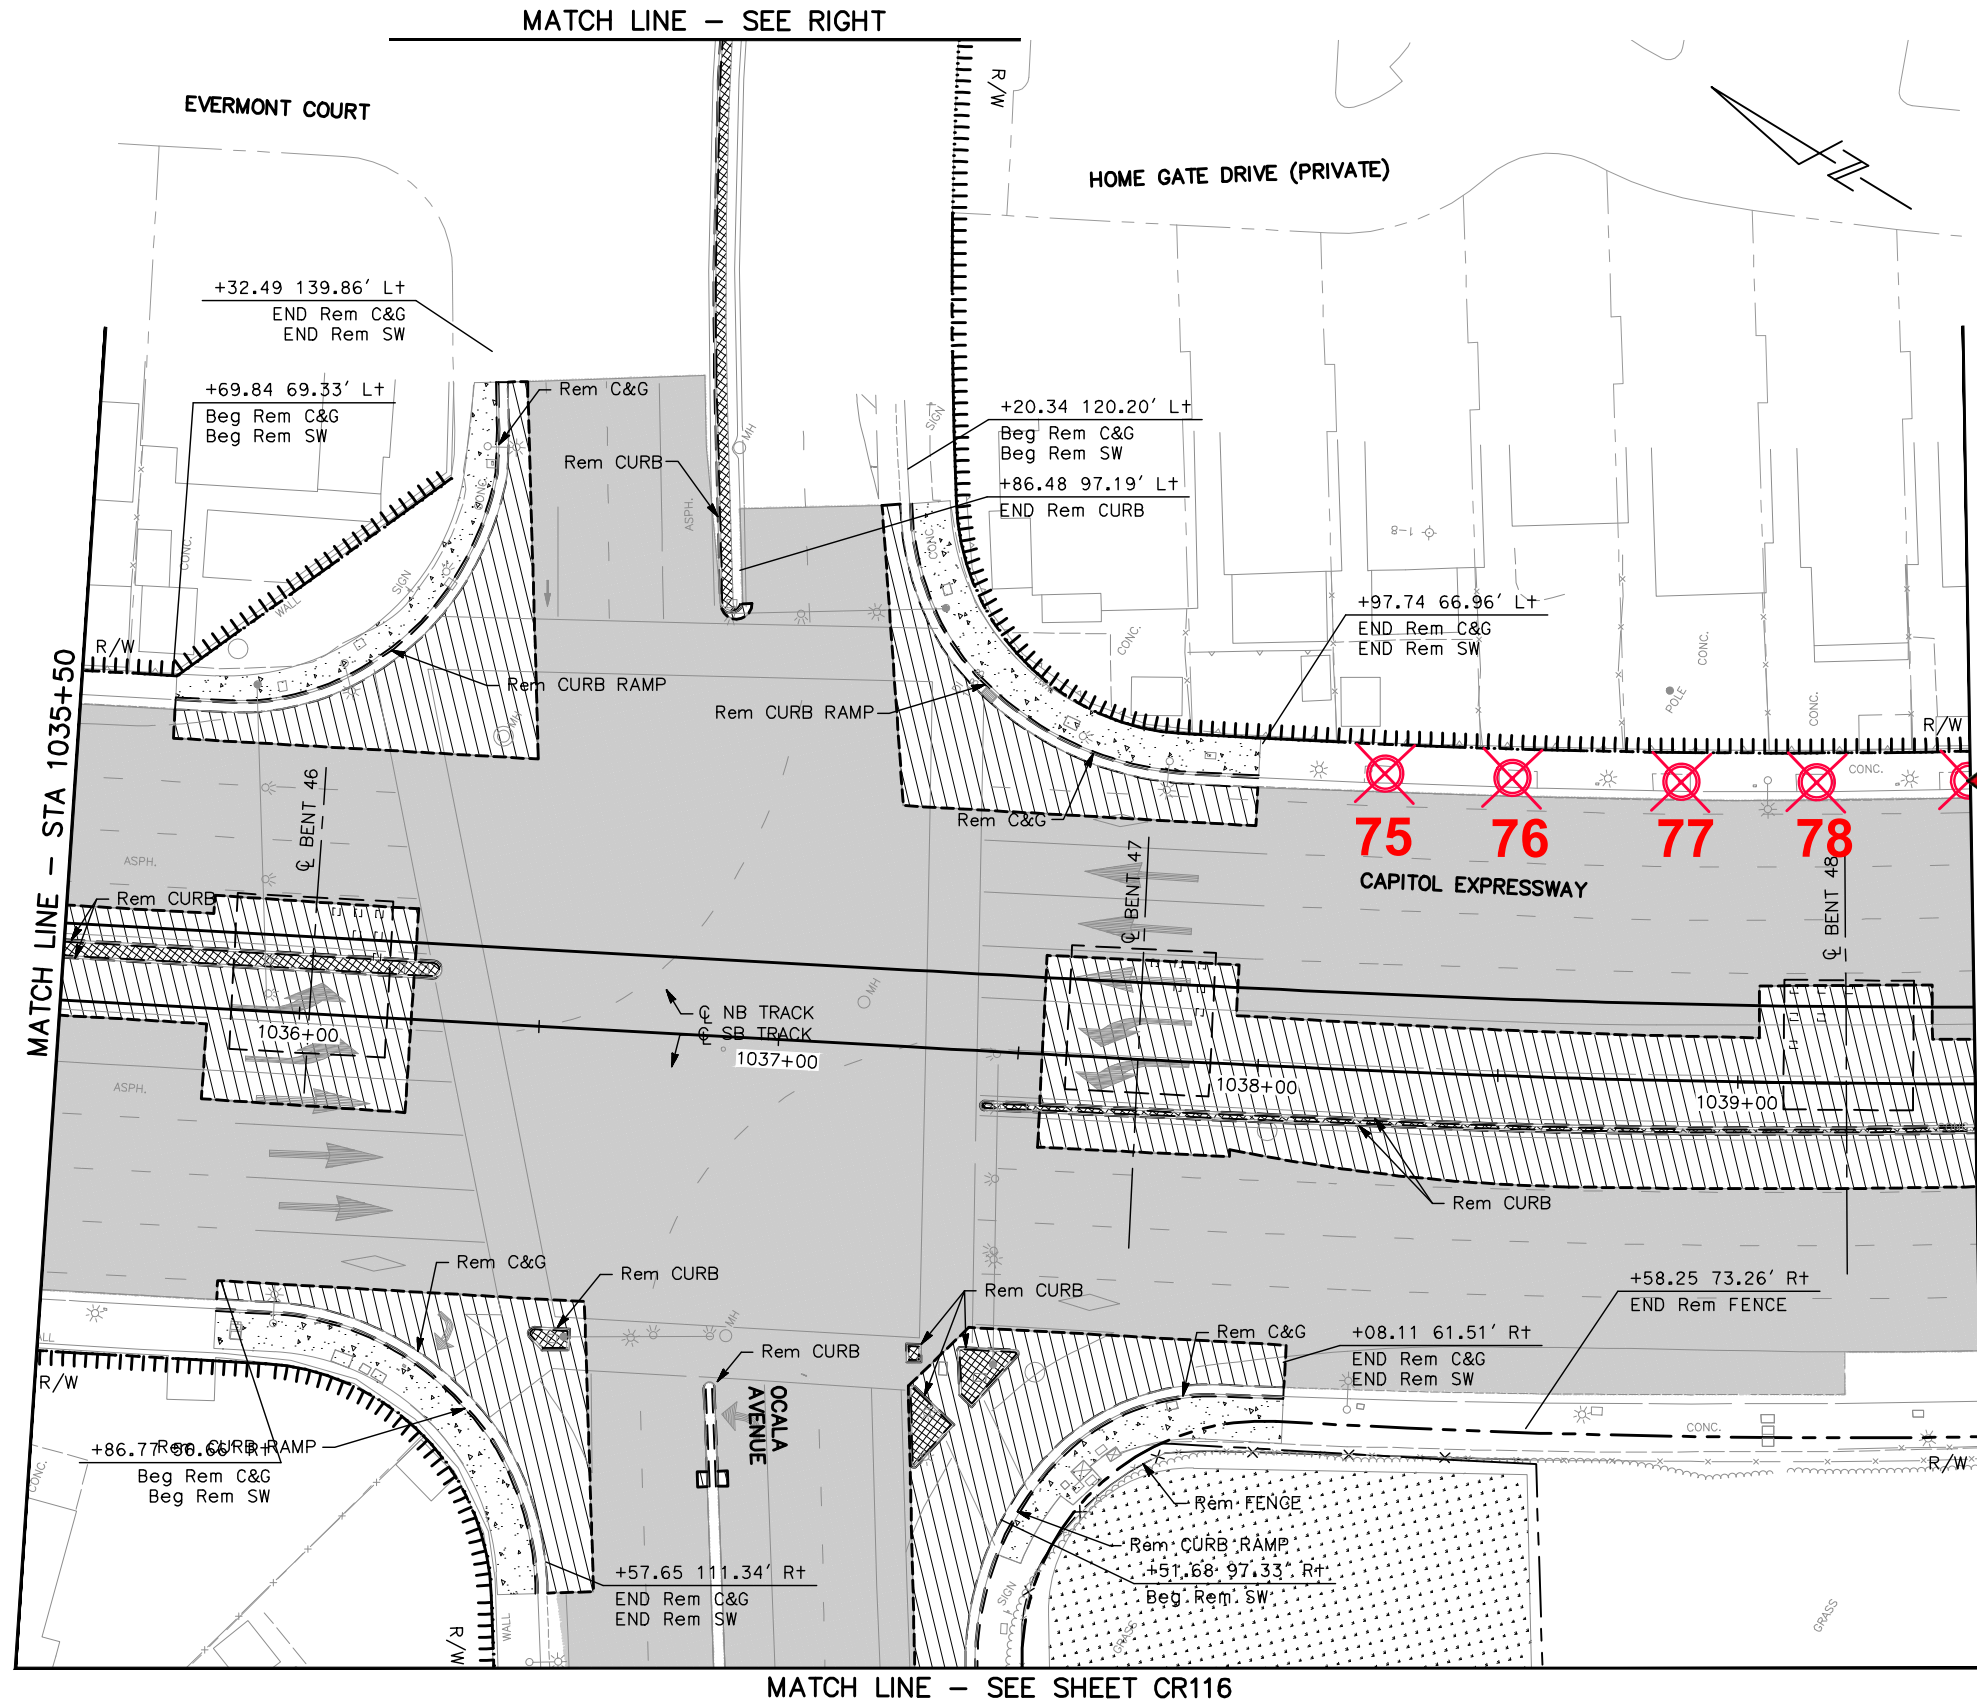

**No Tree**

MATCH LINE - SEE LEFT


MATCH LINE - SEE SHEET CR116

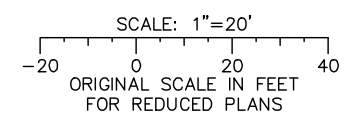

ALL DIMENSIONS ARE IN FEET UNLESS OTHERWISE SHOWN

HERN Oct 17, 2019 - 11:22am K:\2018\67169\_VTA\_CELV\ENG\EXHIBITS\010 Tree Demo Exhibits\010CR016.dwg

| NO. | DATE  | REVISIONS         |
|-----|-------|-------------------|
| B   | 03/19 | 65% SUBMITTAL SET |
| A   | 06/18 | 35% SUBMITTAL SET |

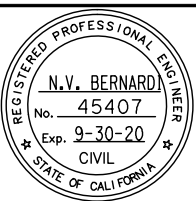

**BKF 100+ YEARS**  
ENGINEERS / SURVEYORS / PLANNERS

DESIGNED: C. Chi  
CHECKED: M. Cosentino  
DRAWN: A. Hernandez  
CADD FILE NAME: 801CR016.dwg

**Santa Clara Valley Transportation Authority**

**BKF 100+ YEARS**  
ENGINEERS / SURVEYORS / PLANNERS

CADD FILE DATE: 03/01/19  
SUBMITTAL DATE: 03/11/19  
SCALE: 1" = 20'  
BOARD APPROVAL DATE:

EASTRIDGE TO BART REGIONAL CONNECTOR  
CAPITOL EXPRESSWAY LIGHT RAIL PROJECT  
CIVIL  
DEMOLITION PLAN  
STA 1035+50 TO STA 1039+50

PCA NO.: 000  
CONTRACT NO.: C801  
FILE LOCATION: PROJECTWISE

|             |       |
|-------------|-------|
| SHEET OF    | CR016 |
| DRAWING NO. | CR016 |
| REVISION    | B     |

**NOTE:**


FOR DEMOLITION PLAN NOTES AND LEGEND, SEE DRAWING CR001.

**TREES TO BE REMOVED SHOWN ON THIS SHEET: 1**


**No Tree**



**79**

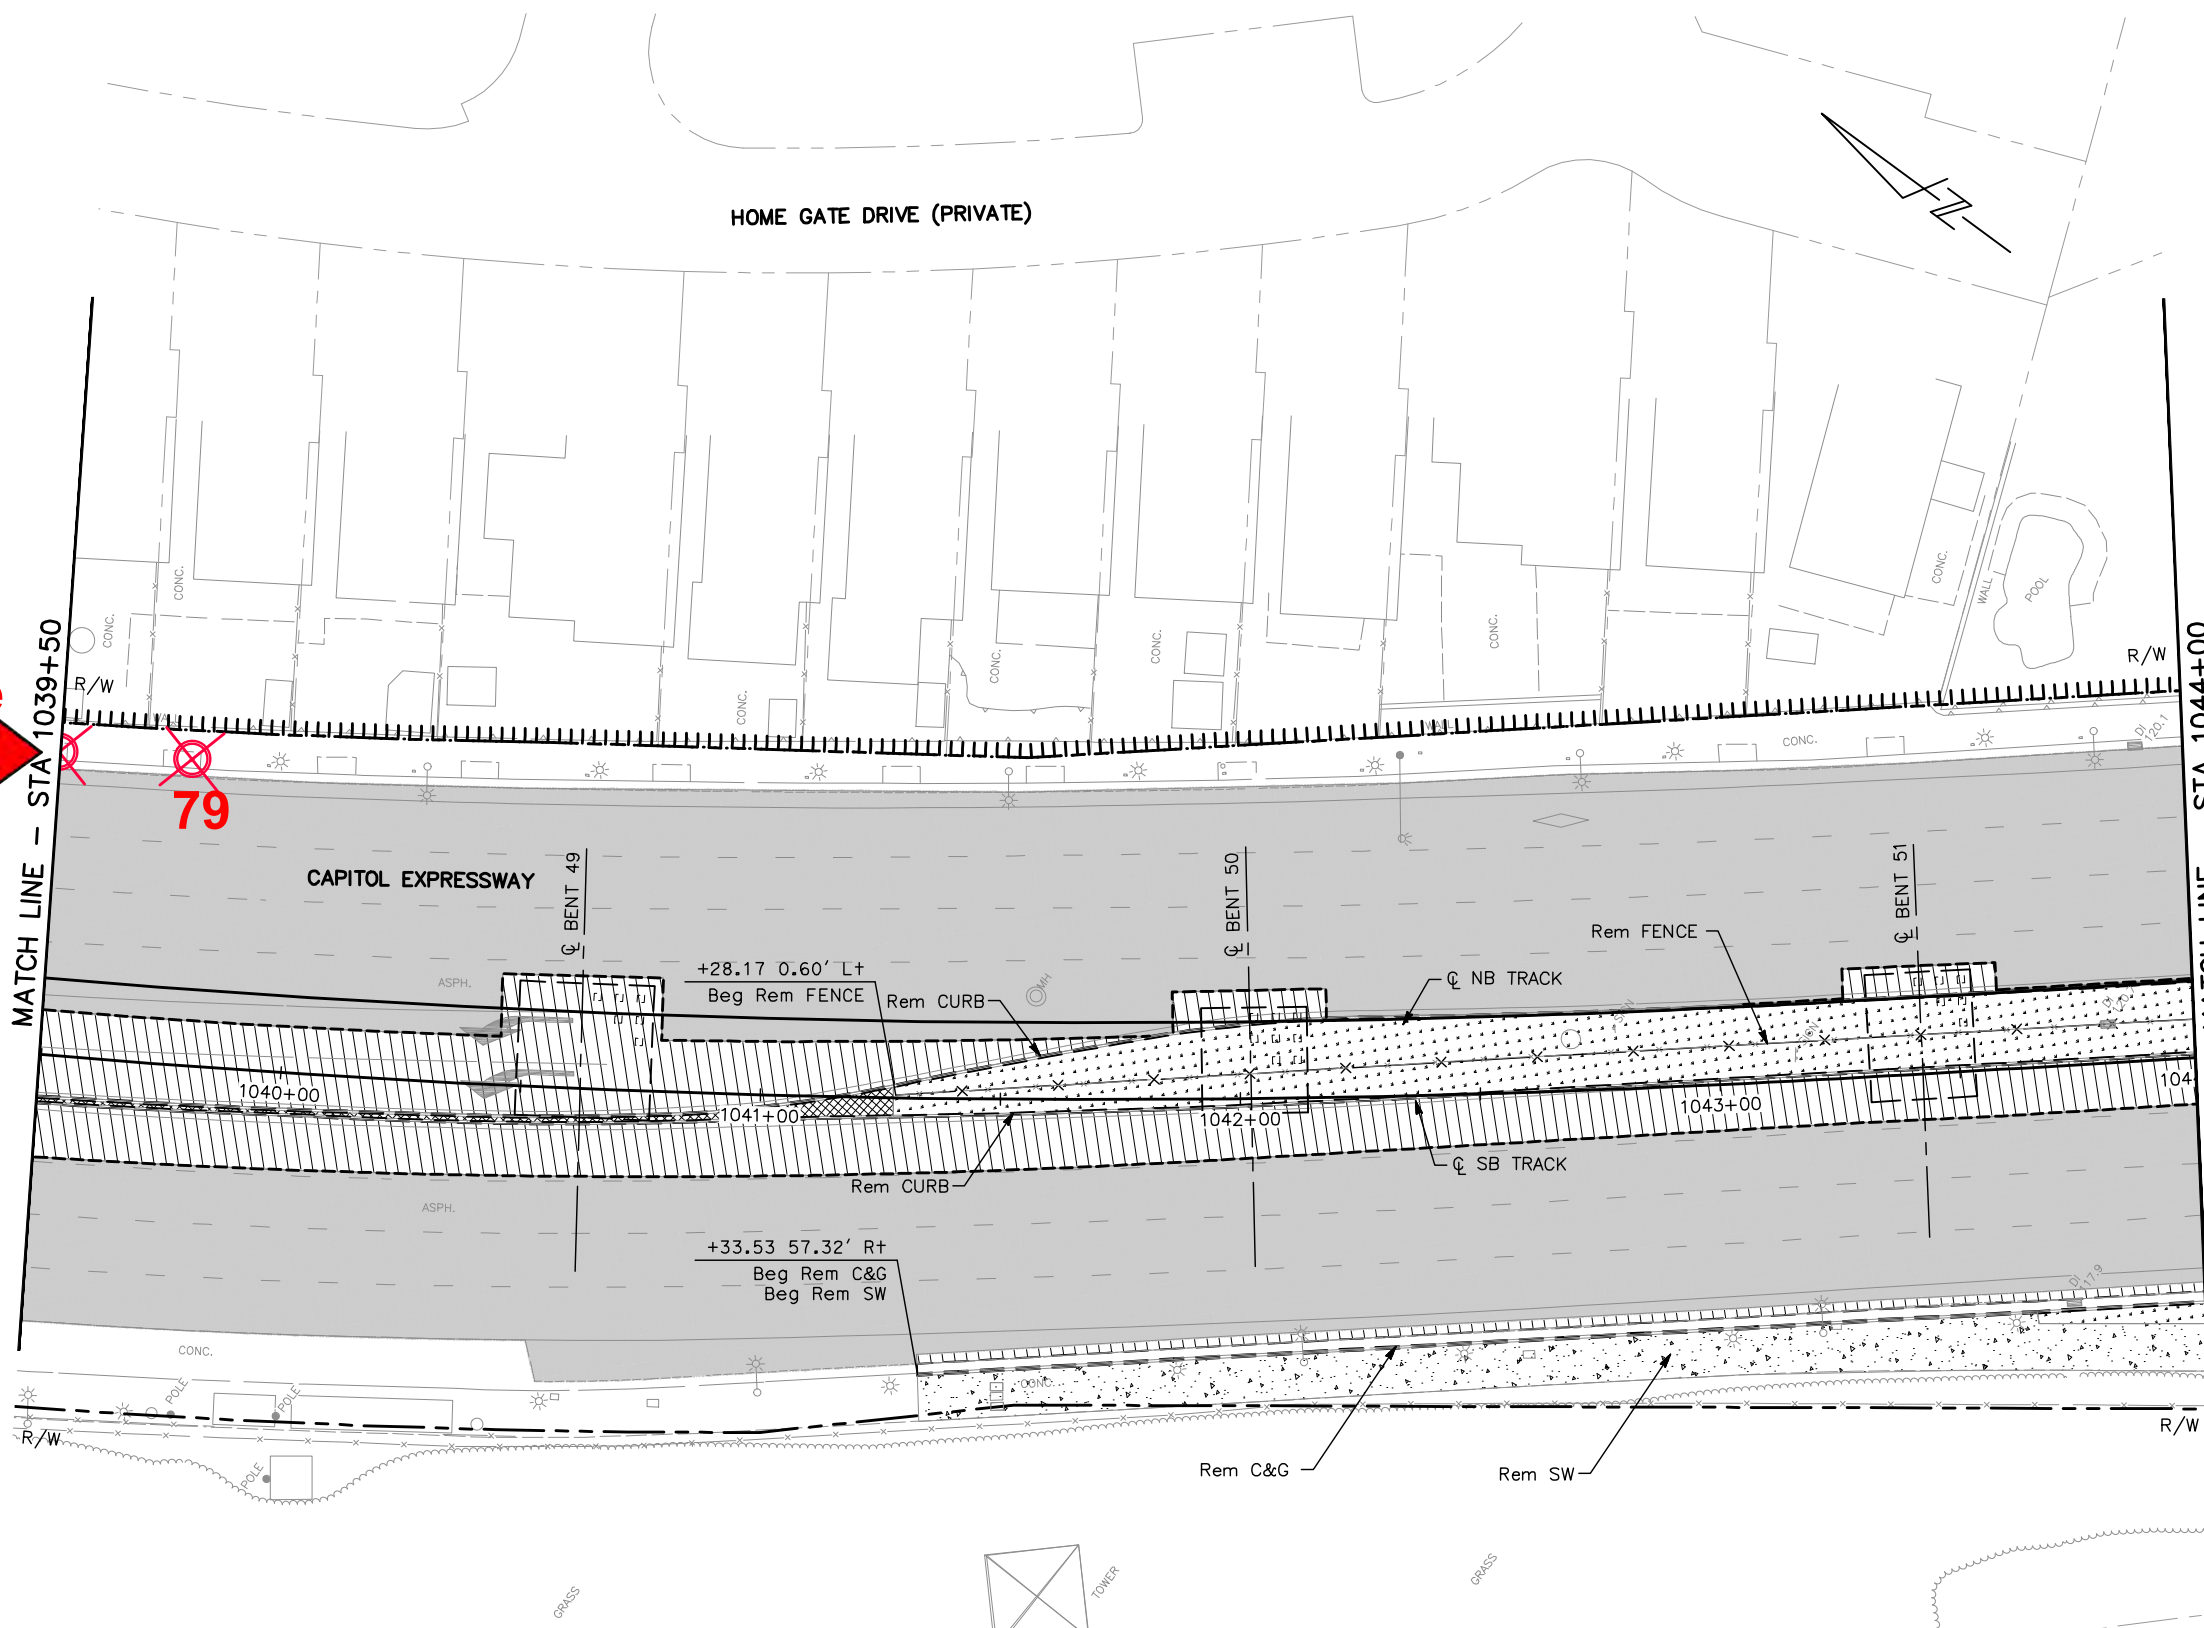


ALL DIMENSIONS ARE IN FEET UNLESS OTHERWISE SHOWN

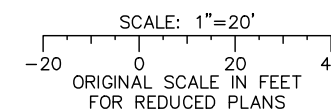

HERN Oct 17, 2019 - 11:22am K:\2018\67169\_VTA\_CELV\ENG\EXHIBITS\010 Tree Demo Exhibits\_801CR017.dwg

| NO. | DATE  | REVISIONS         |
|-----|-------|-------------------|
| B   | 03/19 | 65% SUBMITTAL SET |
| A   | 06/18 | 35% SUBMITTAL SET |

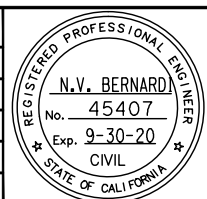

**BKF 100+ YEARS**  
ENGINEERS / SURVEYORS / PLANNERS

DESIGNED: C. Chi  
CHECKED: M. Cosentino  
DRAWN: A. Hernandez  
CADD FILE NAME: 801CR017.dwg



**BKF 100+ YEARS**  
ENGINEERS / SURVEYORS / PLANNERS

CADD FILE DATE: 03/01/19  
SCALE: 1" = 20'  
SUBMITTAL DATE: 03/11/19  
BOARD APPROVAL DATE:

EASTRIDGE TO BART REGIONAL CONNECTOR  
CAPITOL EXPRESSWAY LIGHT RAIL PROJECT  
CIVIL  
DEMOLITION PLAN  
STA 1039+50 TO STA 1044+00

PROJECTWISE



CONTRACT NO. C801

|          |       |
|----------|-------|
| SHEET OF | CR017 |
| REVISION | B     |

**NOTE:**

FOR DEMOLITION PLAN NOTES AND LEGEND, SEE DRAWING CR001.


**TREES TO BE REMOVED SHOWN ON THIS SHEET: 9**

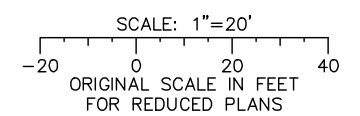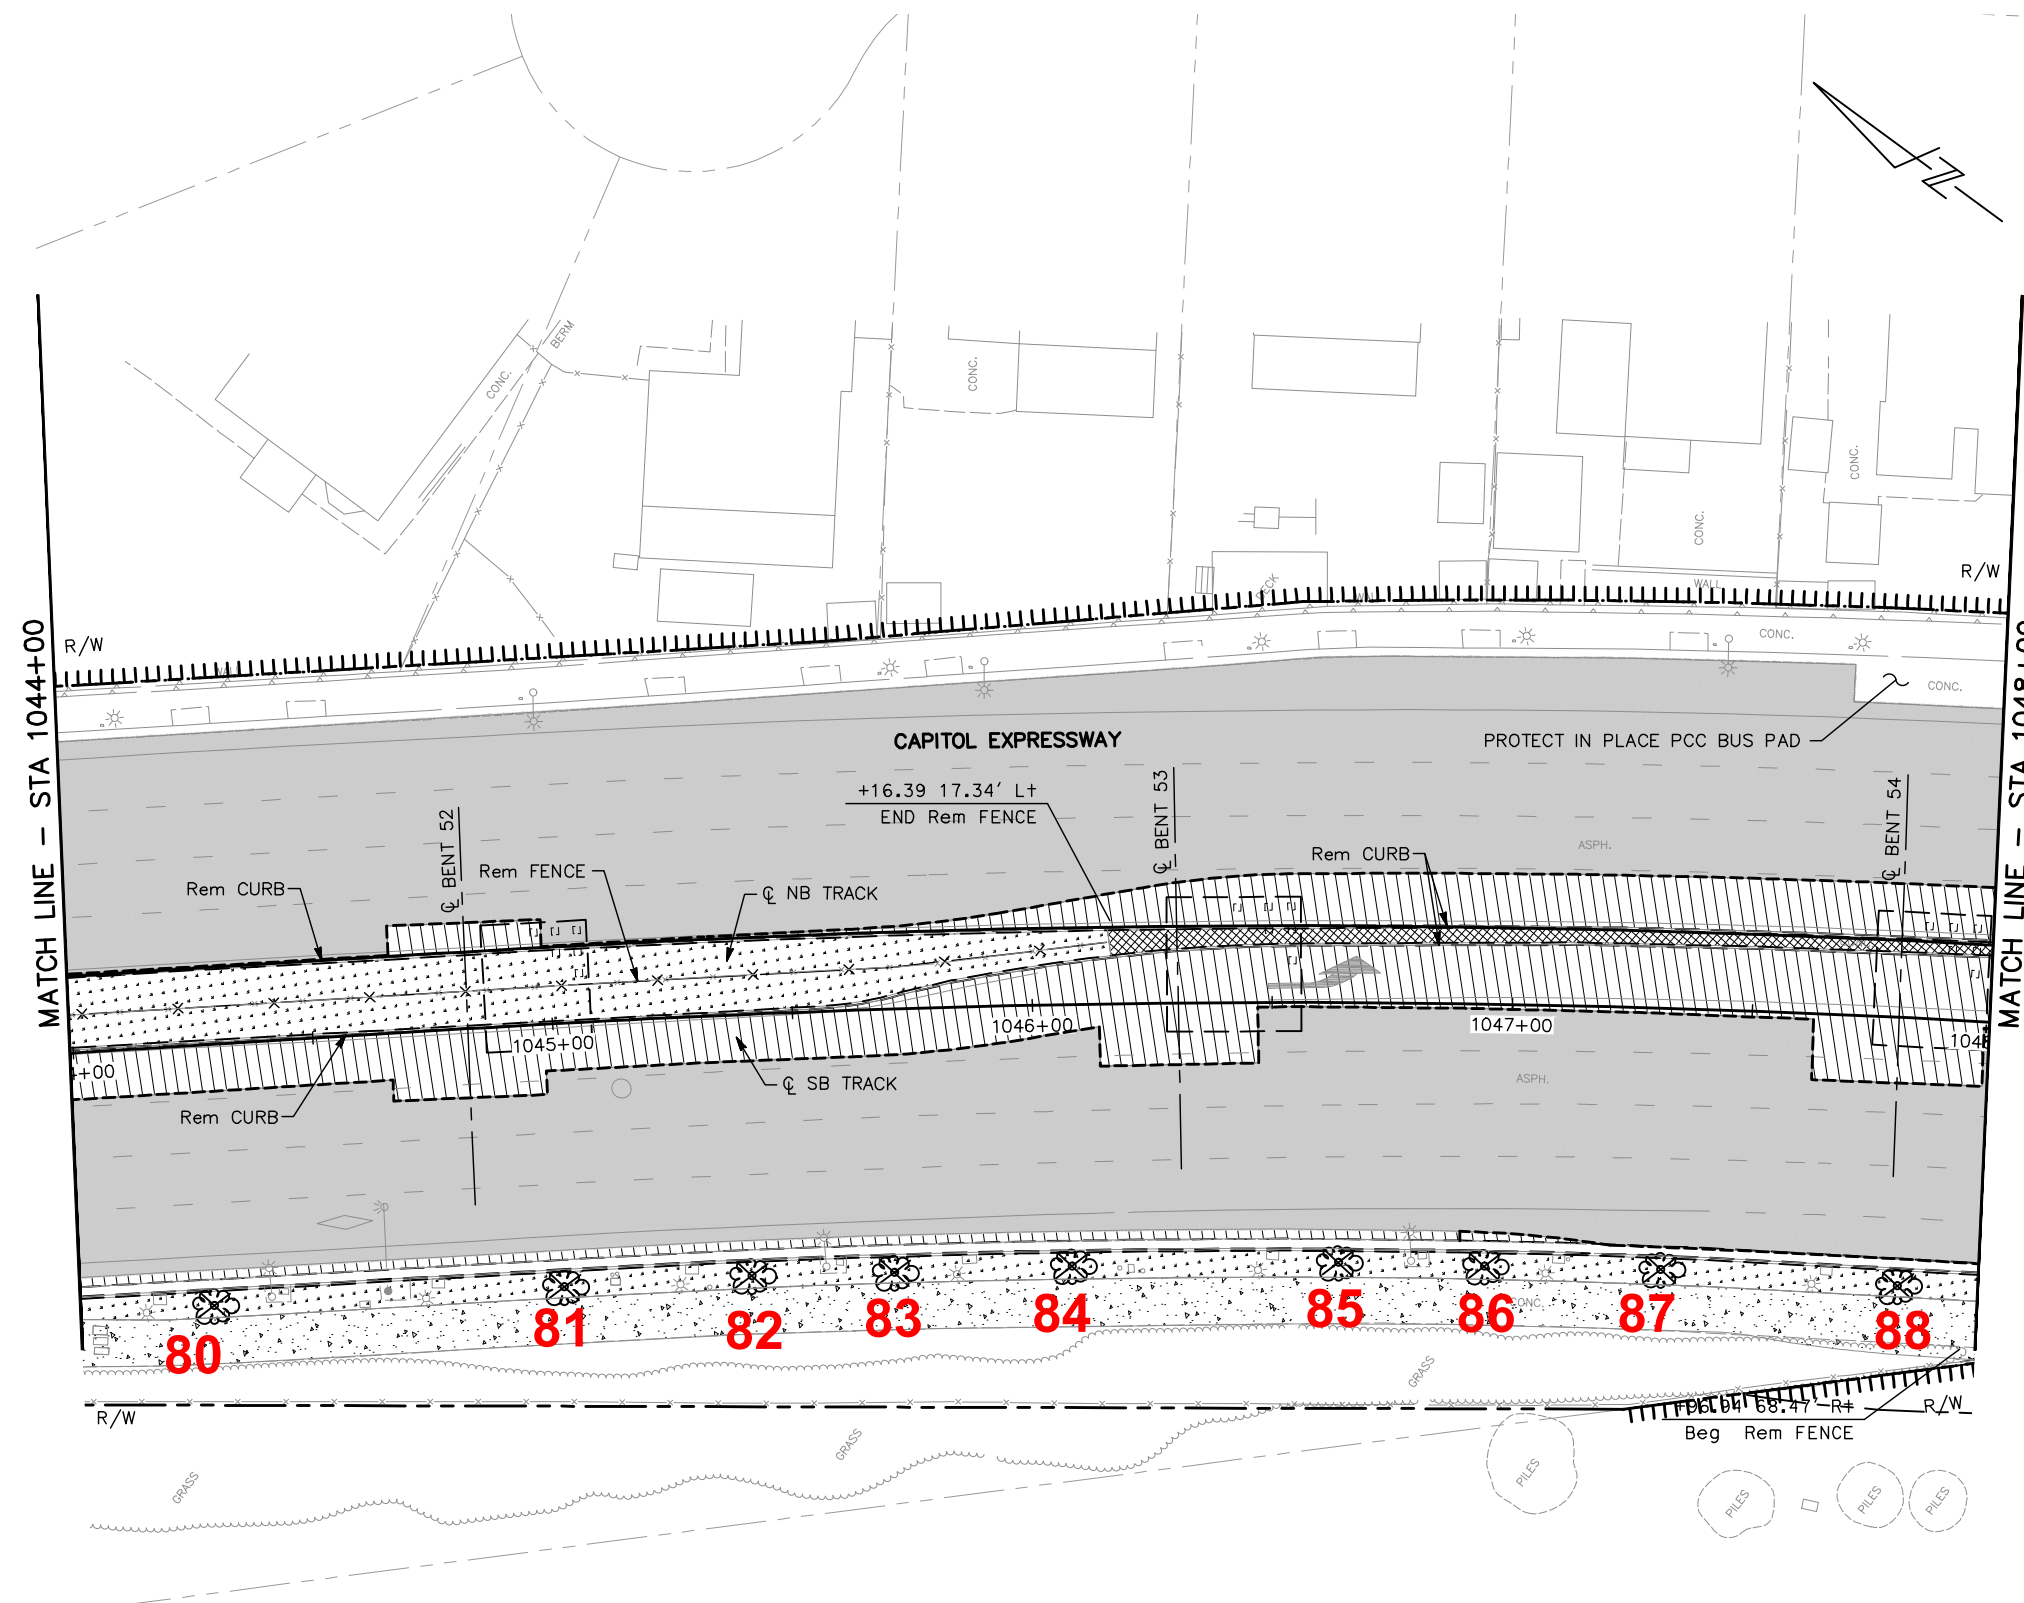

ALL DIMENSIONS ARE IN FEET UNLESS OTHERWISE SHOWN

HERN Oct 17, 2019 - 9:06am K:\2016\167169\_VTA\_GELV\ENG\EXHIBITS\010\_Tree\_Demo\_Exhibits\801CR018.dwg

| NO. | DATE  | REVISIONS         |
|-----|-------|-------------------|
| B   | 03/19 | 65% SUBMITTAL SET |
| A   | 06/18 | 35% SUBMITTAL SET |

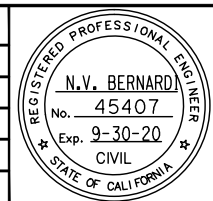

**BKF 100+ YEARS**  
**ENGINEERS / SURVEYORS / PLANNERS**

DESIGNED: C. Chi  
 CHECKED: M. Cosentino  
 DRAWN: A. Hernandez  
 CADD FILE NAME: 801CR018.dwg




**BKF 100+ YEARS**  
**ENGINEERS / SURVEYORS / PLANNERS**

CADD FILE DATE: 03/01/19  
 SCALE: 1" = 20'  
 SUBMITTAL DATE: 03/11/19  
 BOARD APPROVAL DATE:


|   |                      |                              |  |
|---|----------------------|------------------------------|--|
| EASTRIDGE TO BART REGIONAL CONNECTOR<br>CAPITOL EXPRESSWAY LIGHT RAIL PROJECT<br>CIVIL<br>DEMOLITION PLAN<br>STA 1044+00 TO STA 1048+00 |                      |                              | SHEET<br>OF<br>DRAWING NO.<br>CR018<br>REVISION<br>B |
| PCA NO.<br>000  | CONTRACT NO.<br>C801 | FILE LOCATION<br>PROJECTWISE |  |

**NOTE:**  
FOR DEMOLITION PLAN NOTES AND LEGEND, SEE DRAWING CR001.

**TREES TO BE REMOVED SHOWN ON THIS SHEET: 2**

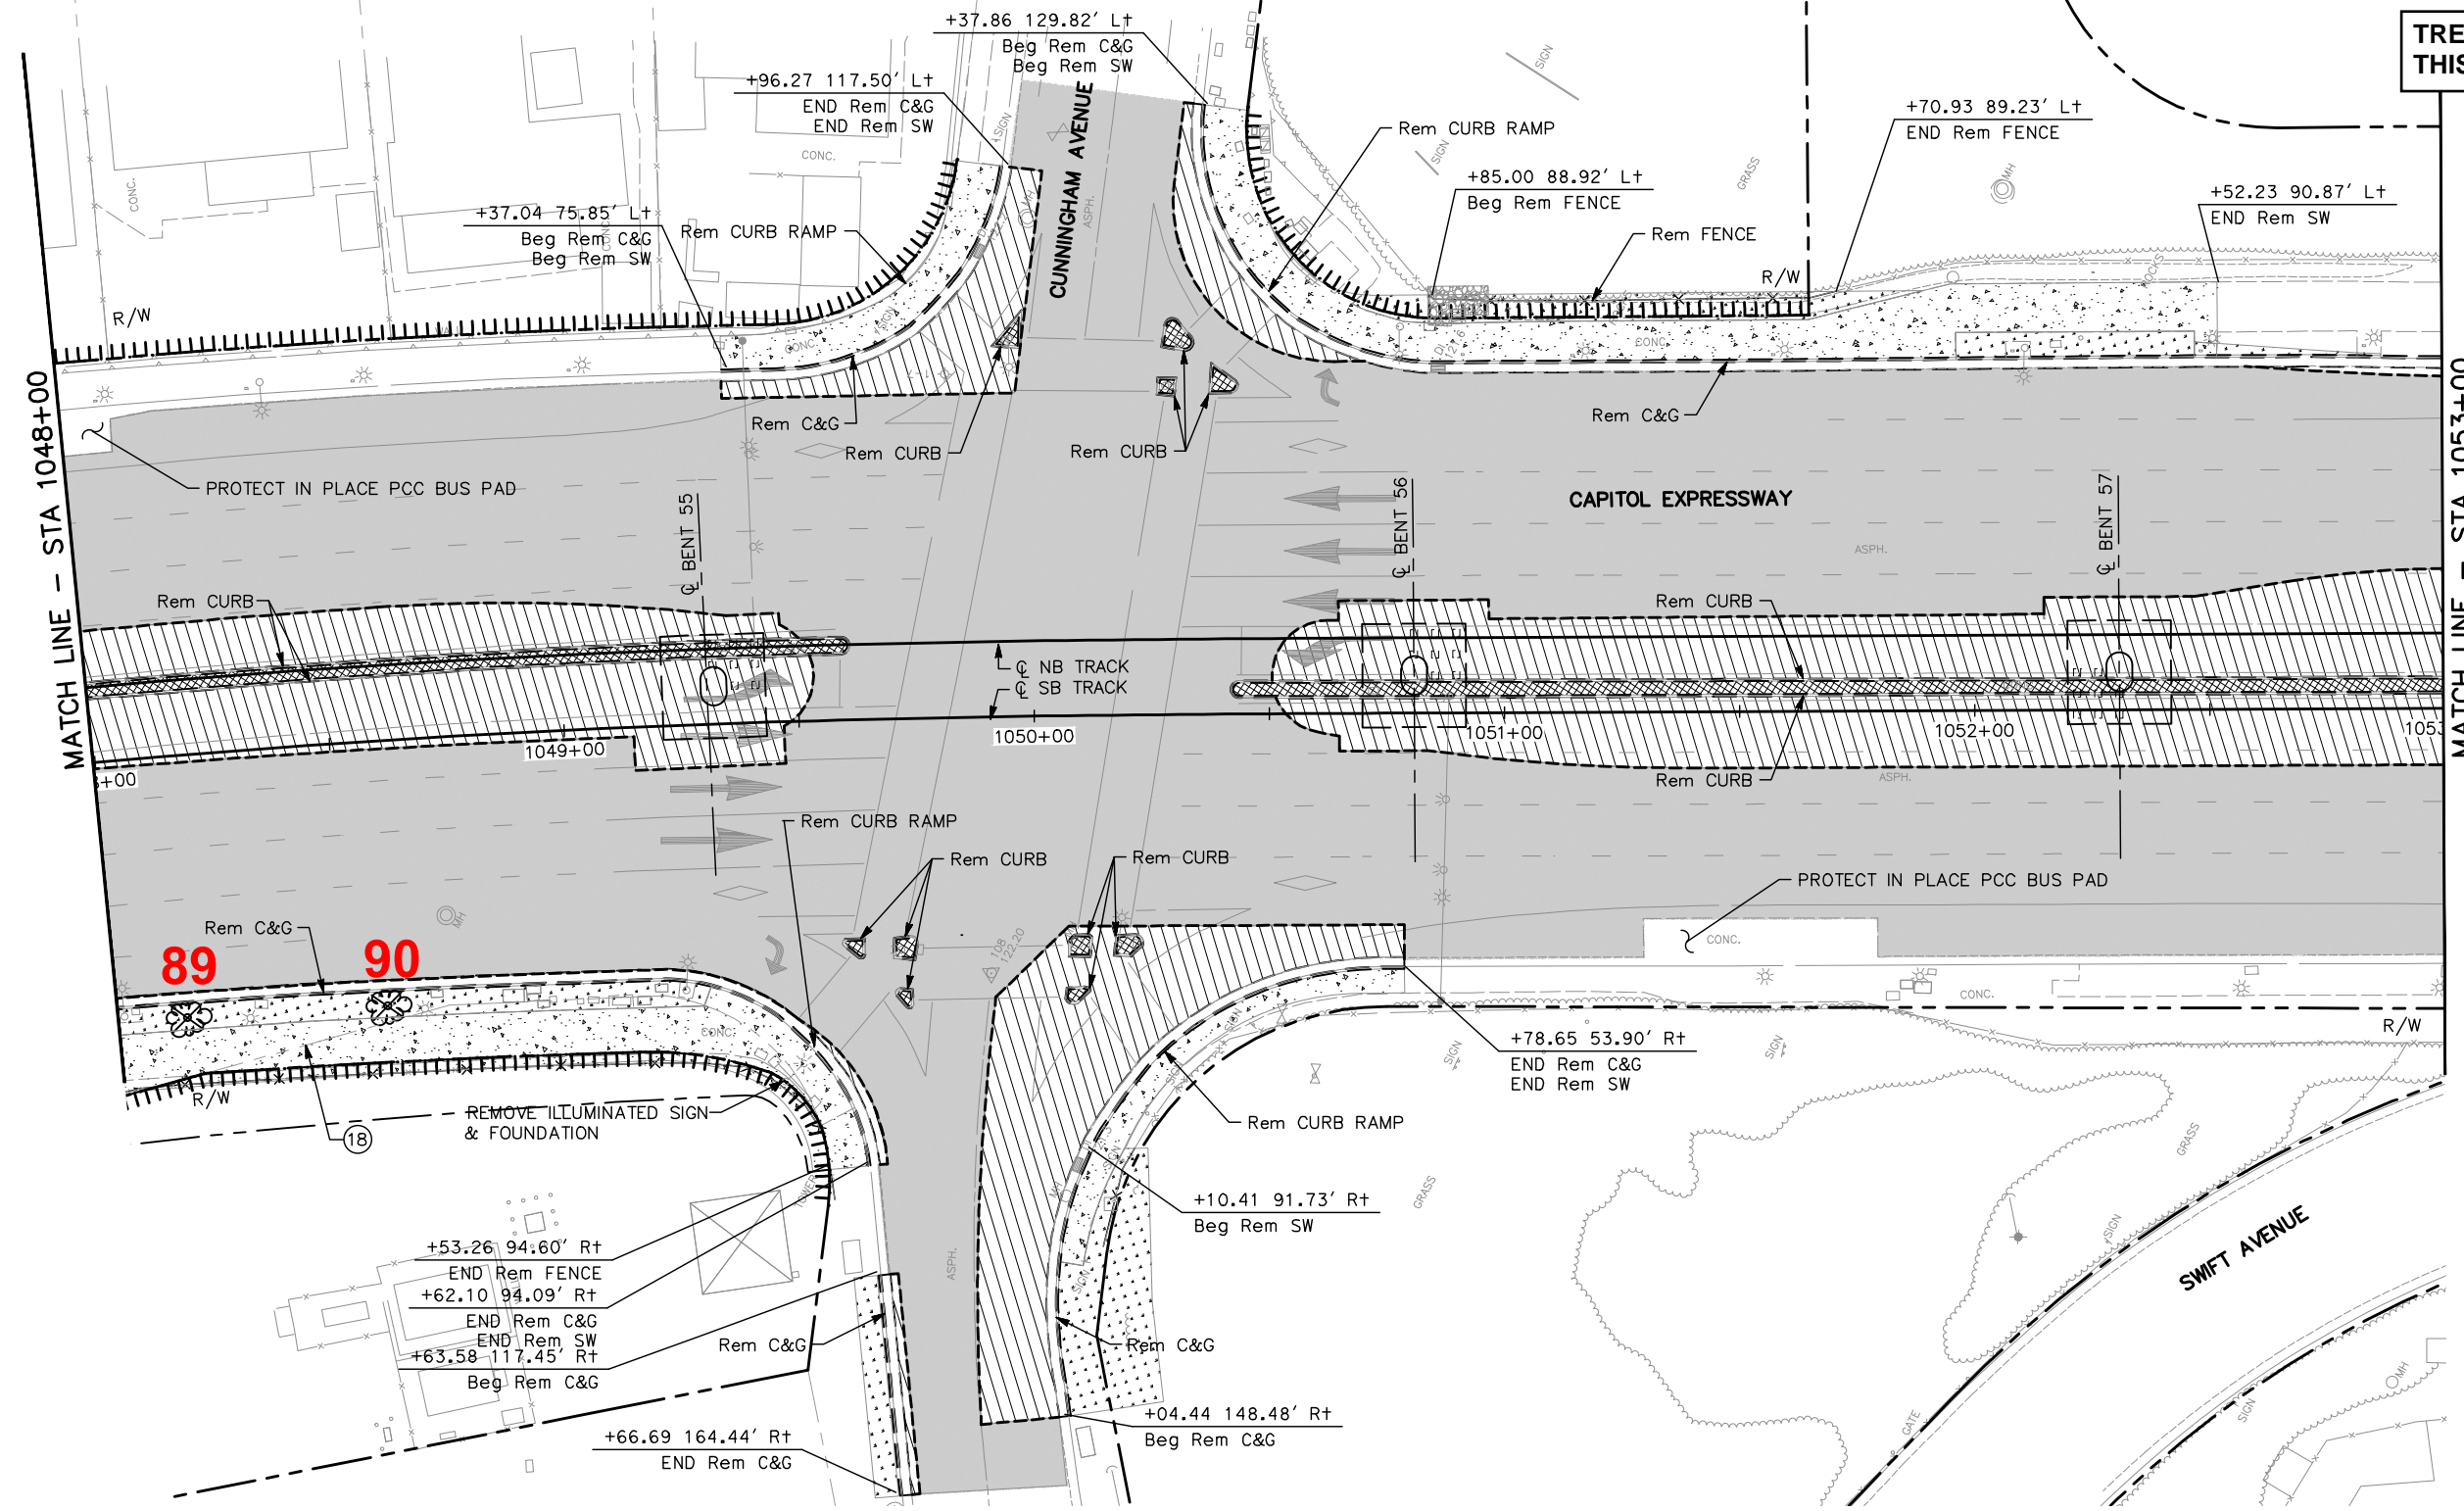


ALL DIMENSIONS ARE IN FEET UNLESS OTHERWISE SHOWN

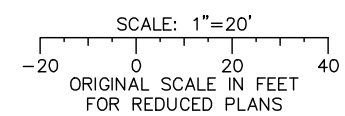

HERN Oct 17, 2019 - 9:07am K:\2019\187169\_VTA\_CELV\ENG\EXHIBITS\010\_Tree\_Demo\_Exhibits\010CR019.dwg

| NO. | DATE  | REVISIONS         |
|-----|-------|-------------------|
| B   | 03/19 | 65% SUBMITTAL SET |
| A   | 06/18 | 35% SUBMITTAL SET |

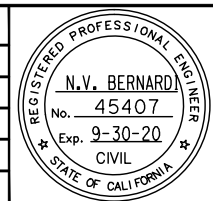

SUBMITTED

**BKF 100+ YEARS**  
ENGINEERS / SURVEYORS / PLANNERS

DESIGNED: C. Chi  
CHECKED: M. Cosentino  
DRAWN: A. Hernandez  
CADD FILE NAME: 801CR019.dwg

Santa Clara Valley  
Transportation  
Authority

APPROVED

**BKF 100+ YEARS**  
ENGINEERS / SURVEYORS / PLANNERS

CADD FILE DATE: 03/01/19  
SUBMITTAL DATE: 03/11/19  
SCALE: 1" = 20'  
BOARD APPROVAL DATE:


EASTRIDGE TO BART REGIONAL CONNECTOR  
CAPITOL EXPRESSWAY LIGHT RAIL PROJECT  
CIVIL  
DEMOLITION PLAN  
STA 1048+00 TO STA 1053+00

PCA NO. 000 CONTRACT NO. C801 FILE LOCATION PROJECTWISE


SHEET OF DRAWING NO. CR019 REVISION B

**NOTE:**  
FOR DEMOLITION PLAN NOTES AND LEGEND, SEE DRAWING CRO01.

**TREES TO BE REMOVED SHOWN ON THIS SHEET: 1**

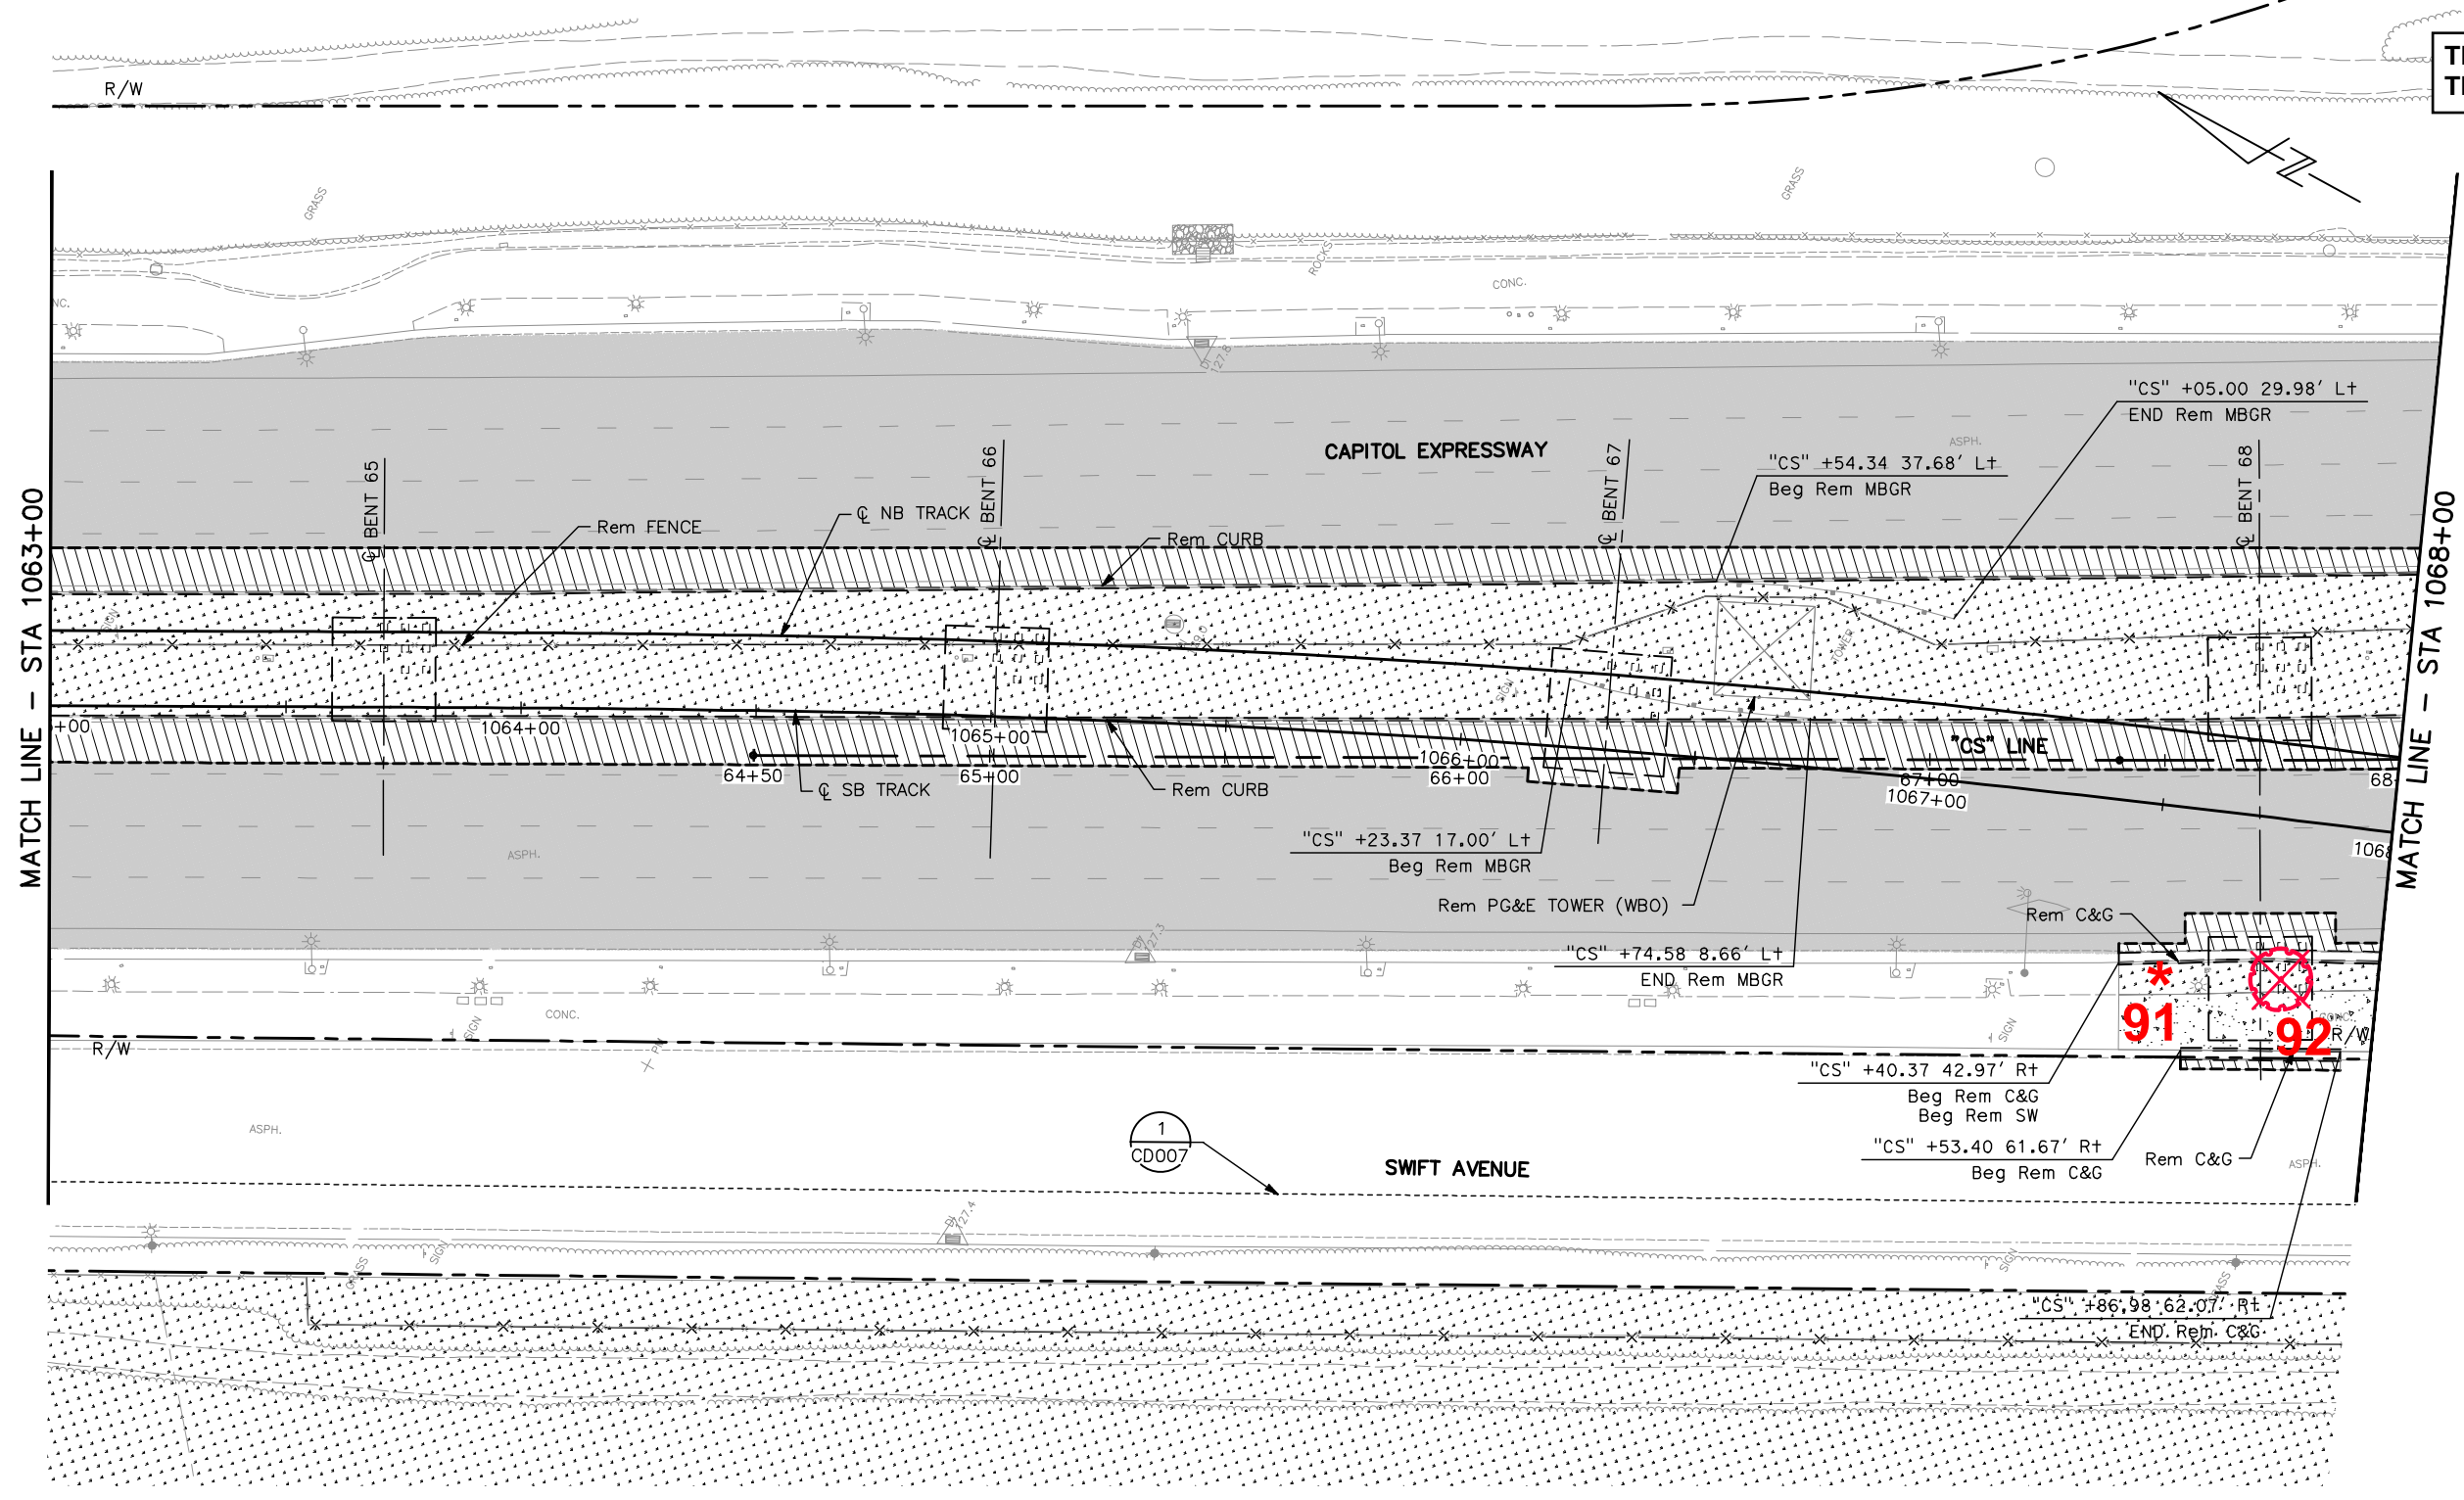


ALL DIMENSIONS ARE IN FEET UNLESS OTHERWISE SHOWN

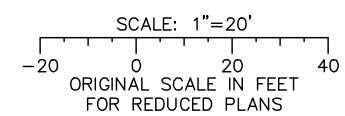

HERN Oct 17, 2019 - 9:09am K:\2016\167169\_VTA\_CELVLENG\EXHIBITS\010\_Tree Demo Exhibits\601CR022.dwg

| NO. | DATE  | REVISIONS         |
|-----|-------|-------------------|
| B   | 03/19 | 65% SUBMITTAL SET |
| A   | 06/18 | 35% SUBMITTAL SET |

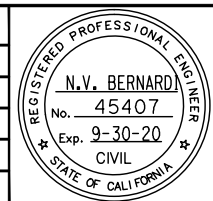

**BKF 100+ YEARS**  
ENGINEERS / SURVEYORS / PLANNERS

DESIGNED: C. Chi  
CHECKED: M. Cosentino  
DRAWN: A. Hernandez  
CADD FILE NAME: 801CR022.dwg



**BKF 100+ YEARS**  
ENGINEERS / SURVEYORS / PLANNERS

CADD FILE DATE: 03/01/19  
SCALE: 1" = 20'  
SUBMITTAL DATE: 03/11/19  
BOARD APPROVAL DATE:

EASTRIDGE TO BART REGIONAL CONNECTOR  
CAPITOL EXPRESSWAY LIGHT RAIL PROJECT  
CIVIL  
DEMOLITION PLAN  
STA 1063+00 TO STA 1068+00


PROJECTWISE

|             |       |
|-------------|-------|
| SHEET OF    | CRO22 |
| DRAWING NO. | CRO22 |
| REVISION    | B     |




**NOTE:**  
FOR DEMOLITION PLAN NOTES AND LEGEND, SEE DRAWING CR001.

**TREES TO BE REMOVED SHOWN ON THIS SHEET: 5**

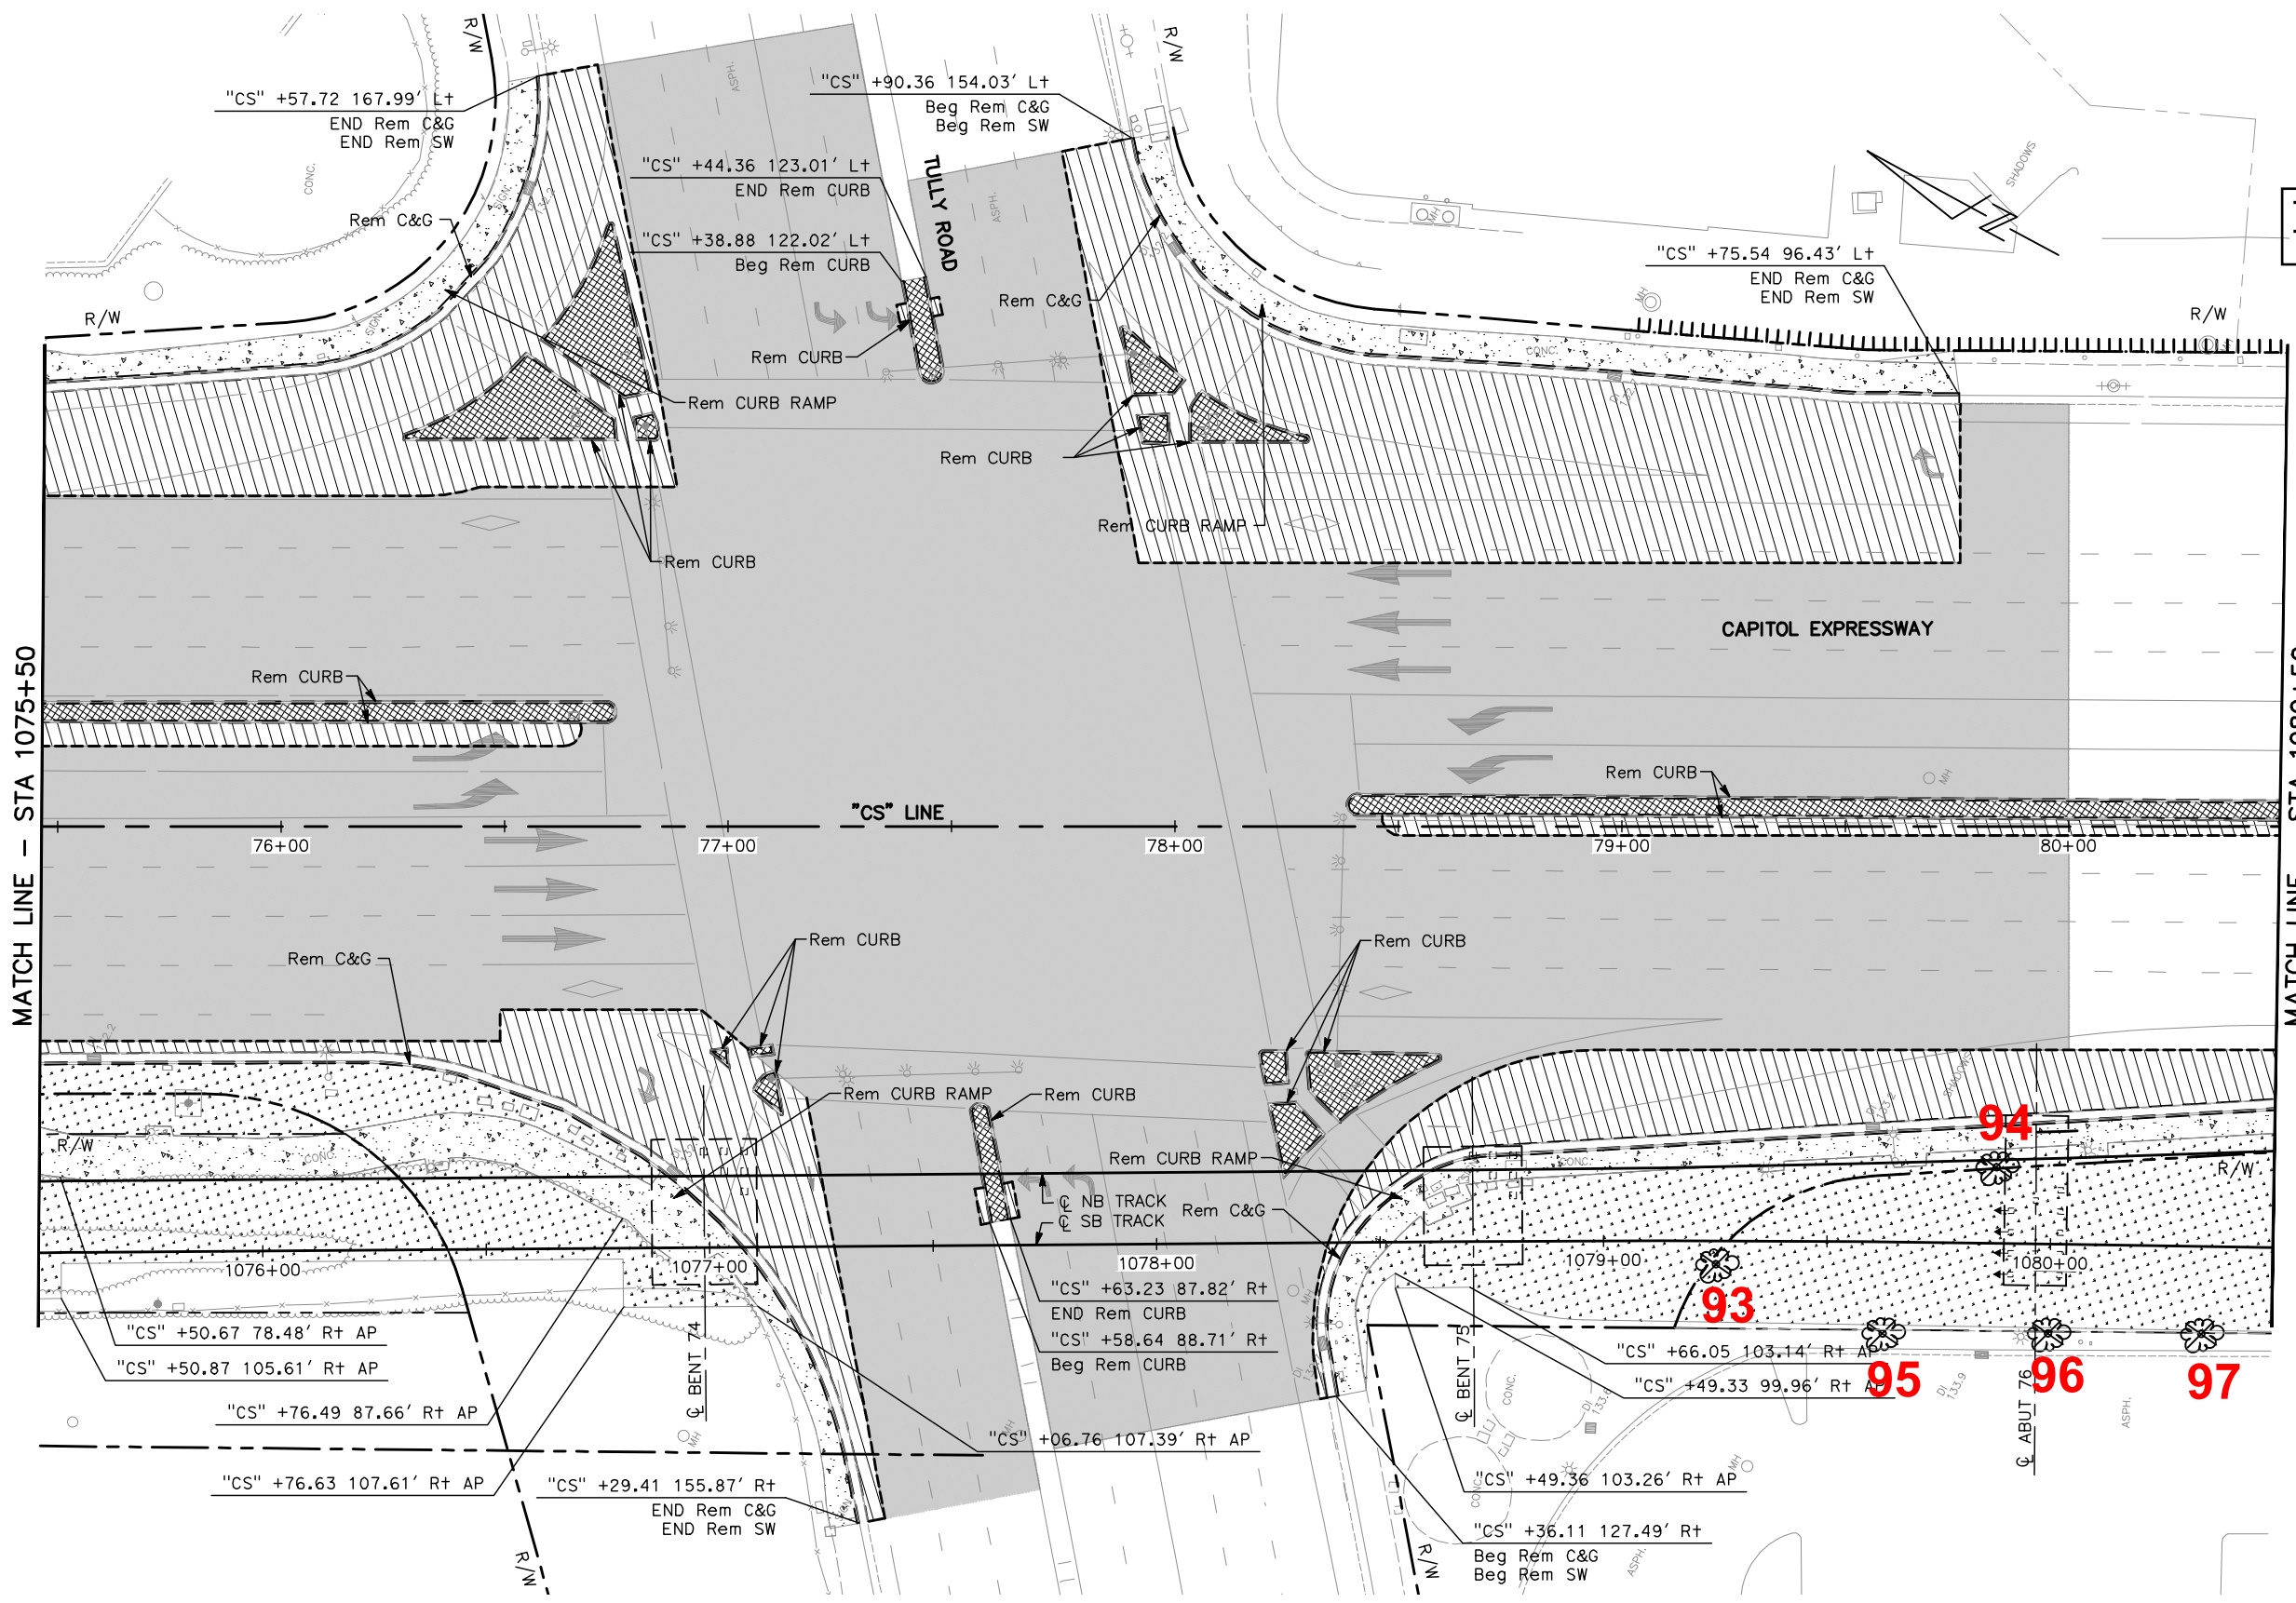


ALL DIMENSIONS ARE IN FEET UNLESS OTHERWISE SHOWN

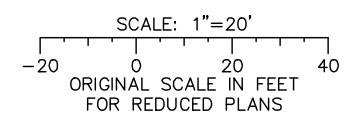

HERN Oct 17, 2019 - 9:11am K:\2016\167189\_VTA\_CELLR\ENG\EXHIBITS\010\_Tree Demo Exhibits\01CR025.dwg

| NO. | DATE  | REVISIONS         |
|-----|-------|-------------------|
| B   | 03/19 | 65% SUBMITTAL SET |
| A   | 06/18 | 35% SUBMITTAL SET |

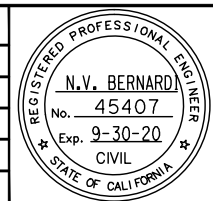

SUBMITTED

**BKF 100+ YEARS**  
ENGINEERS / SURVEYORS / PLANNERS

DESIGNED: C. Chi  
CHECKED: M. Cosentino  
DRAWN: A. Hernandez  
CADD FILE NAME: 801CR025.dwg

**Santa Clara Valley Transportation Authority**

APPROVED

**BKF 100+ YEARS**  
ENGINEERS / SURVEYORS / PLANNERS

CADD FILE DATE: 03/01/19  
SUBMITTAL DATE: 03/11/19  
SCALE: 1" = 20'  
BOARD APPROVAL DATE:

EASTRIDGE TO BART REGIONAL CONNECTOR  
CAPITOL EXPRESSWAY LIGHT RAIL PROJECT  
CIVIL  
DEMOLITION PLAN  
STA 1075+50 TO STA 1080+50


PCA NO. 000 CONTRACT NO. C801 FILE LOCATION PROJECTWISE

SHEET OF DRAWING NO. CR025 REVISION B

**NOTE:**

FOR DEMOLITION PLAN NOTES AND LEGEND, SEE DRAWING CR001.

**TREES TO BE REMOVED SHOWN ON THIS SHEET: 22**

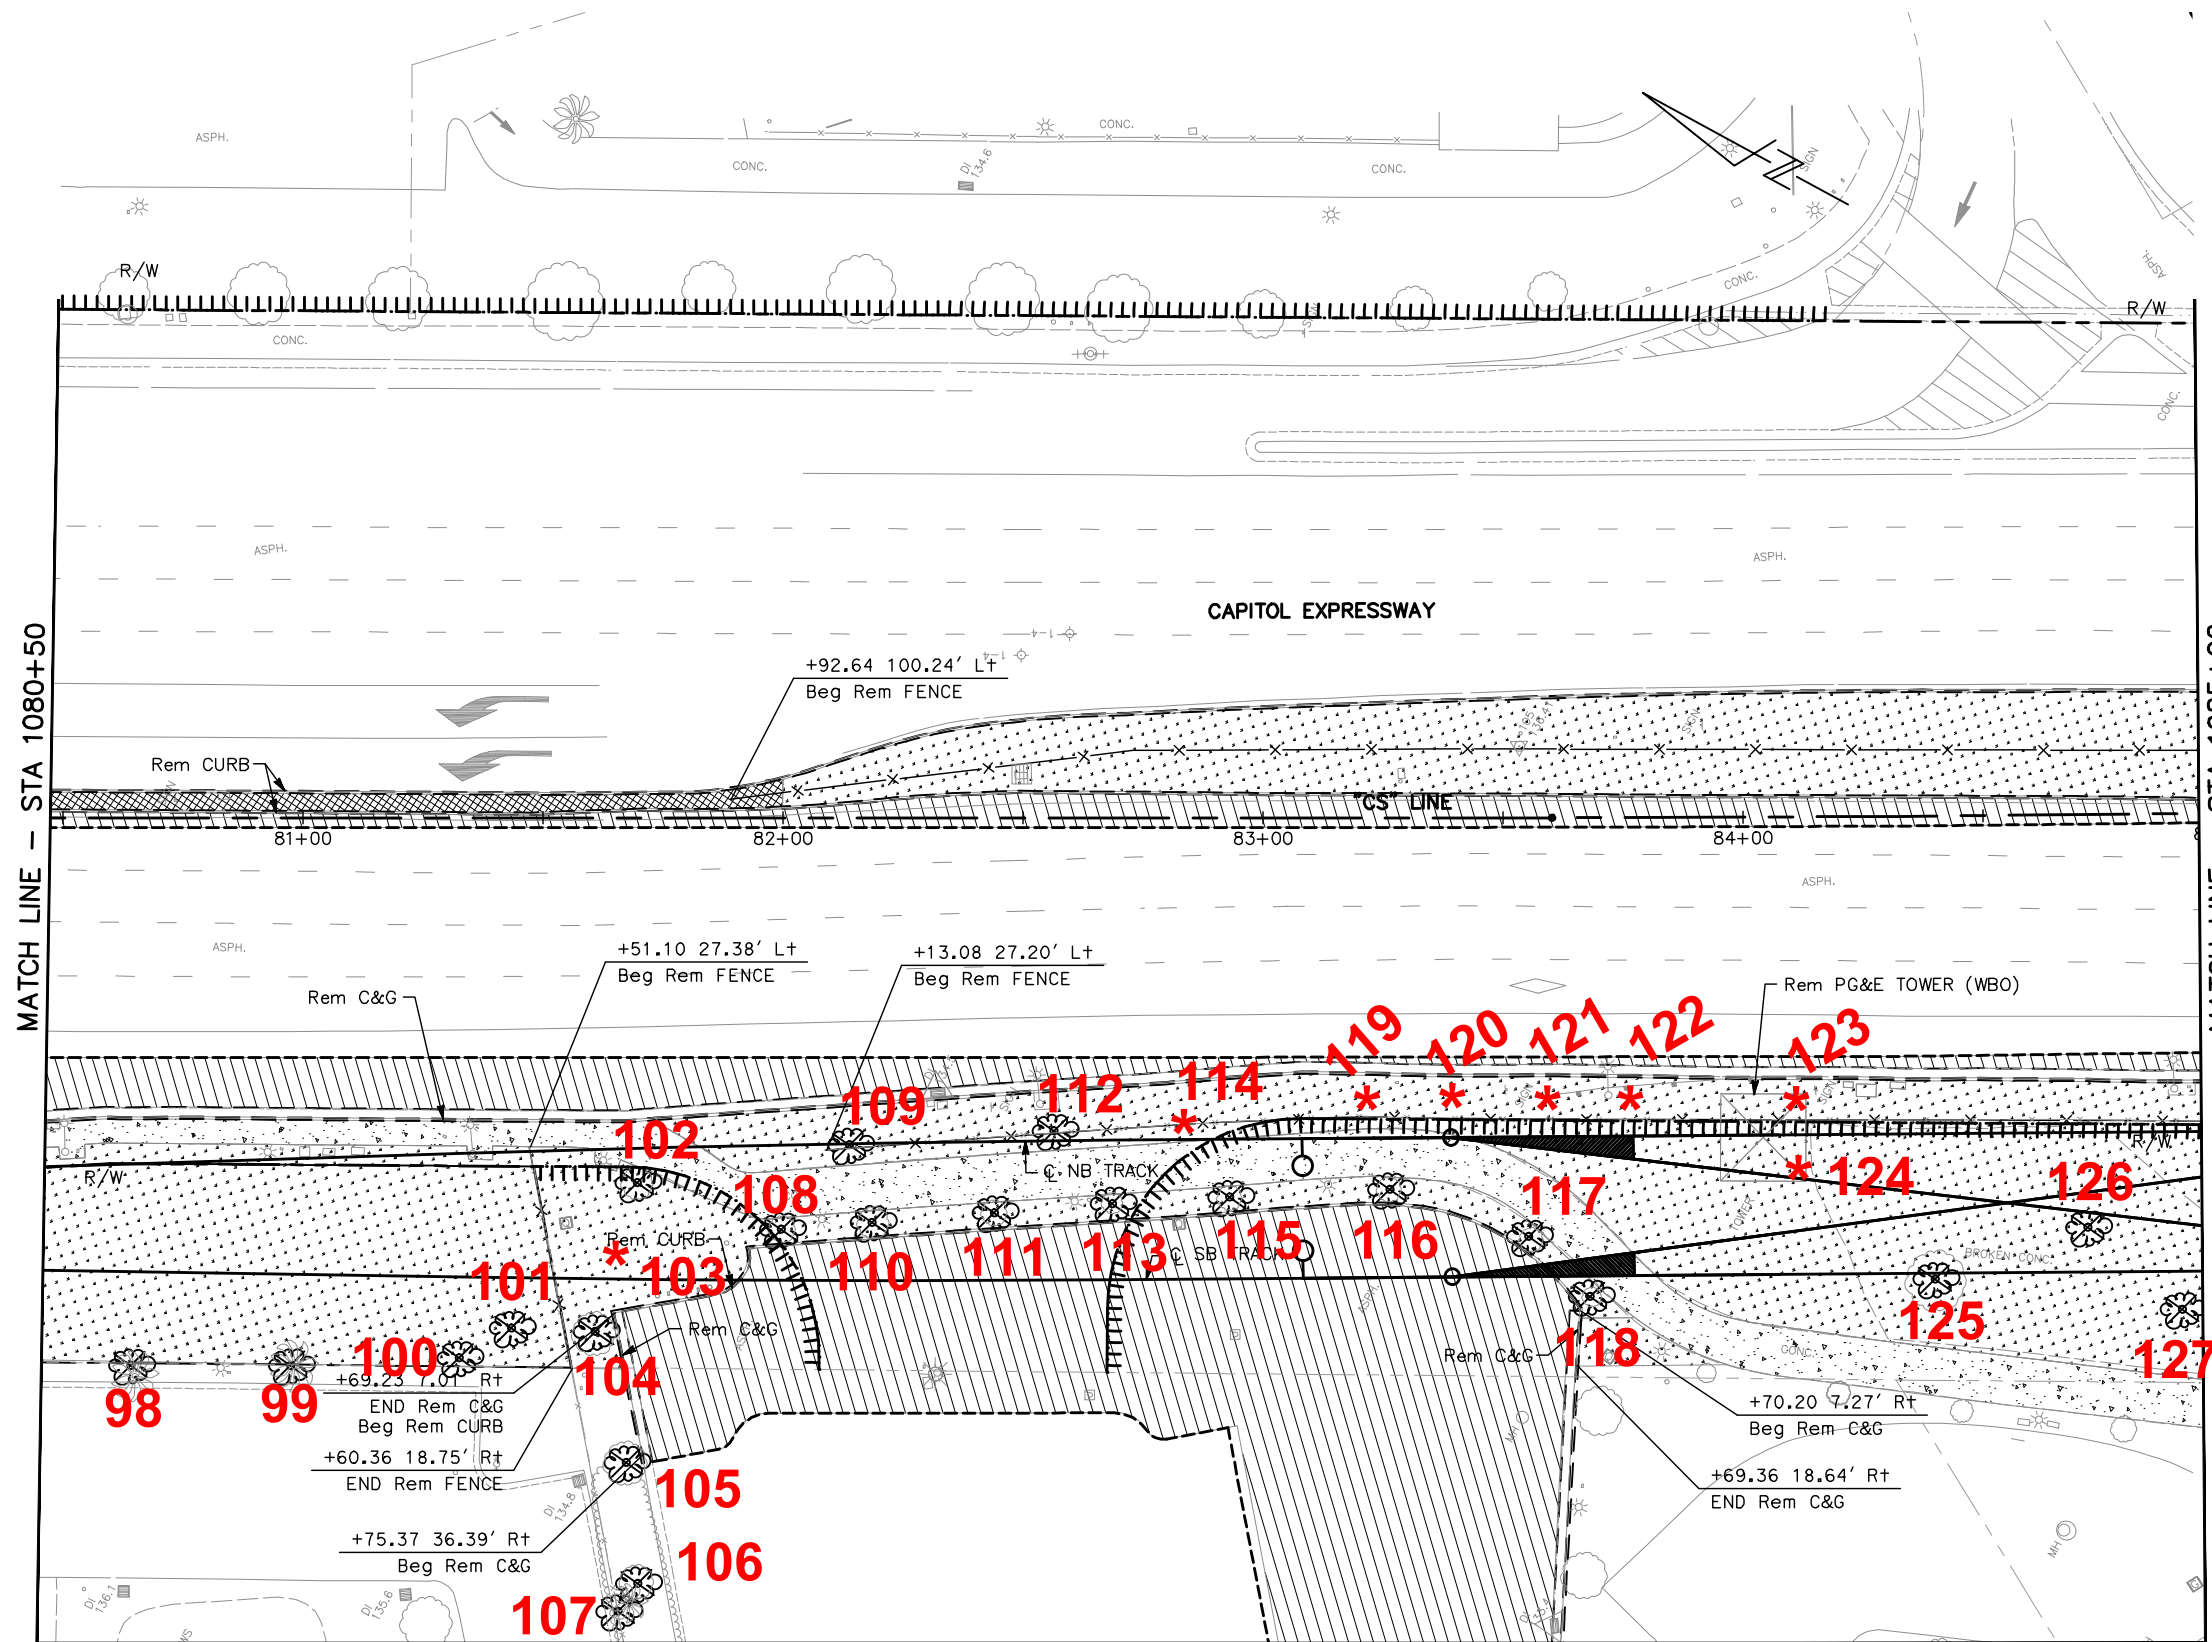


MATCH LINE - STA 1080+50

MATCH LINE - STA 1085+00


MATCH LINE - SEE SHEET CR126

ALL DIMENSIONS ARE IN FEET UNLESS OTHERWISE SHOWN

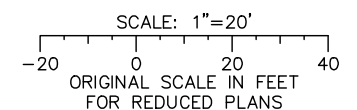

HERN Oct 17, 2019 - 9:12am K:\2016\167169\_VTA\_GEAR FENCE EXHIBITS\010\_Tree Demo Exhibits\01CR026.dwg

| NO. | DATE  | REVISIONS         |
|-----|-------|-------------------|
| B   | 03/19 | 65% SUBMITTAL SET |
| A   | 06/18 | 35% SUBMITTAL SET |

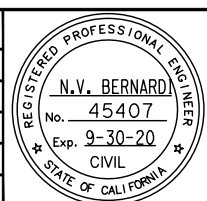

**BKF100+**  
YEARS  
ENGINEERS / SURVEYORS / PLANNERS

DESIGNED: C. Chi  
CHECKED: M. Cosentino  
DRAWN: A. Hernandez  
CADD FILE NAME: 801CR026.dwg



**BKF100+**  
YEARS  
ENGINEERS / SURVEYORS / PLANNERS


CADD FILE DATE: 03/01/19  
SUBMITTAL DATE: 03/11/19  
SCALE: 1" = 20'  
BOARD APPROVAL DATE:

|   |                      |                              |  |
|---|----------------------|------------------------------|--|
| EASTRIDGE TO BART REGIONAL CONNECTOR<br>CAPITOL EXPRESSWAY LIGHT RAIL PROJECT<br>CIVIL<br>DEMOLITION PLAN<br>STA 1080+50 TO STA 1085+00 |                      |                              | SHEET<br>OF<br>DRAWING NO.<br>CR026<br>REVISION<br>B |
| PCA NO.<br>000  | CONTRACT NO.<br>C801 | FILE LOCATION<br>PROJECTWISE |  |


**NOTE:**

FOR DEMOLITION PLAN NOTES AND LEGEND, SEE DRAWING CR001.

**TREES TO BE REMOVED SHOWN ON THIS SHEET: 2**

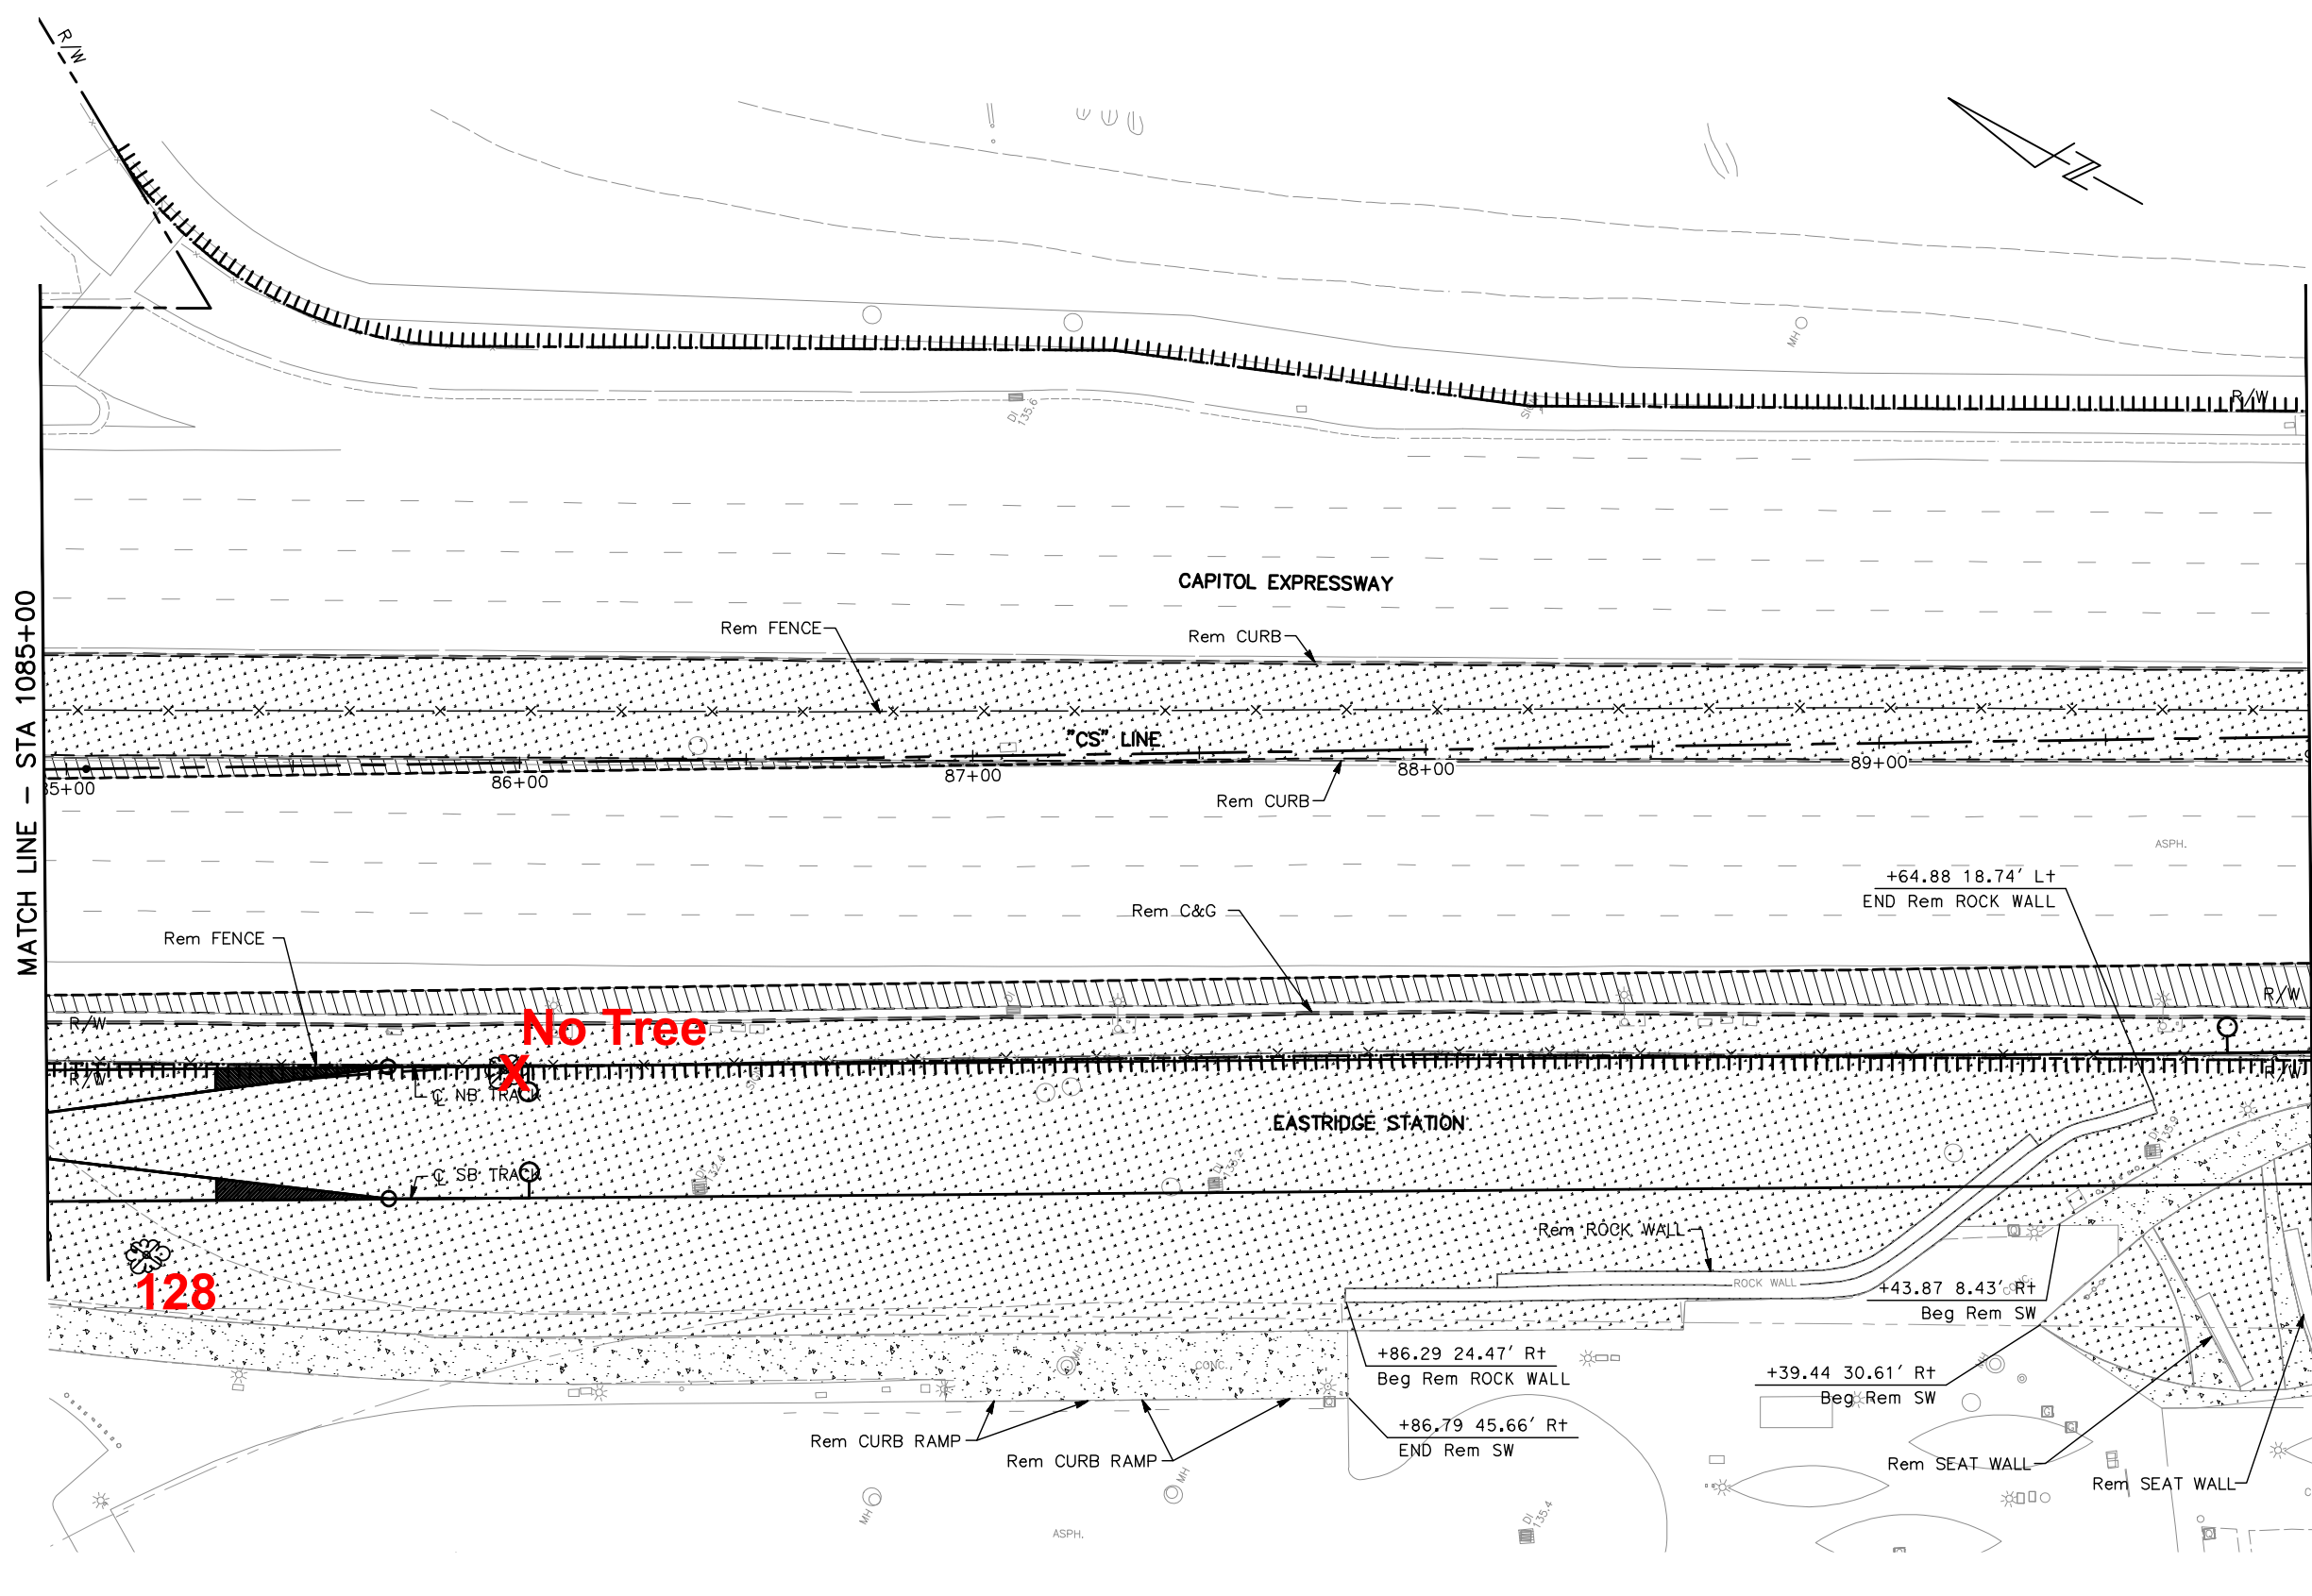


ALL DIMENSIONS ARE IN FEET UNLESS OTHERWISE SHOWN

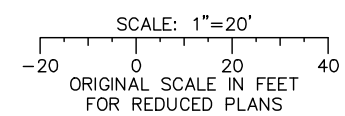

HERN Oct 17, 2019 - 9:14am K:\2016\167169\_VTA\_GEAR VENG EXHIBITS\010 Tree Demo Exhibits\01CR027.dwg

| NO. | DATE  | REVISIONS         |
|-----|-------|-------------------|
| B   | 03/19 | 65% SUBMITTAL SET |
| A   | 06/18 | 35% SUBMITTAL SET |

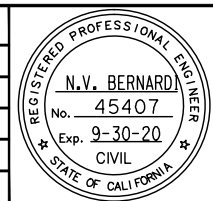

SUBMITTED

**BKF 100+ YEARS**  
ENGINEERS / SURVEYORS / PLANNERS

DESIGNED: C. Chi  
CHECKED: M. Cosentino  
DRAWN: A. Hernandez  
CADD FILE NAME: 801CR027.dwg

Santa Clara Valley  
Transportation  
Authority

APPROVED

**BKF 100+ YEARS**  
ENGINEERS / SURVEYORS / PLANNERS

CADD FILE DATE: 03/01/19  
SUBMITTAL DATE: 03/11/19  
SCALE: 1" = 20'  
BOARD APPROVAL DATE:

EASTRIDGE TO BART REGIONAL CONNECTOR  
CAPITOL EXPRESSWAY LIGHT RAIL PROJECT  
CIVIL  
DEMOLITION PLAN  
STA 1085+00 TO STA 1090+00

PC# NO. 000 CONTRACT NO. C801 FILE LOCATION PROJECTWISE


SHEET OF DRAWING NO. CR027 REVISION B

MATCH LINE – SEE SHEET CR026


**NOTE:**

FOR DEMOLITION PLAN NOTES AND LEGEND, SEE DRAWING CR001.

**TREES TO BE REMOVED SHOWN ON THIS SHEET: 16**

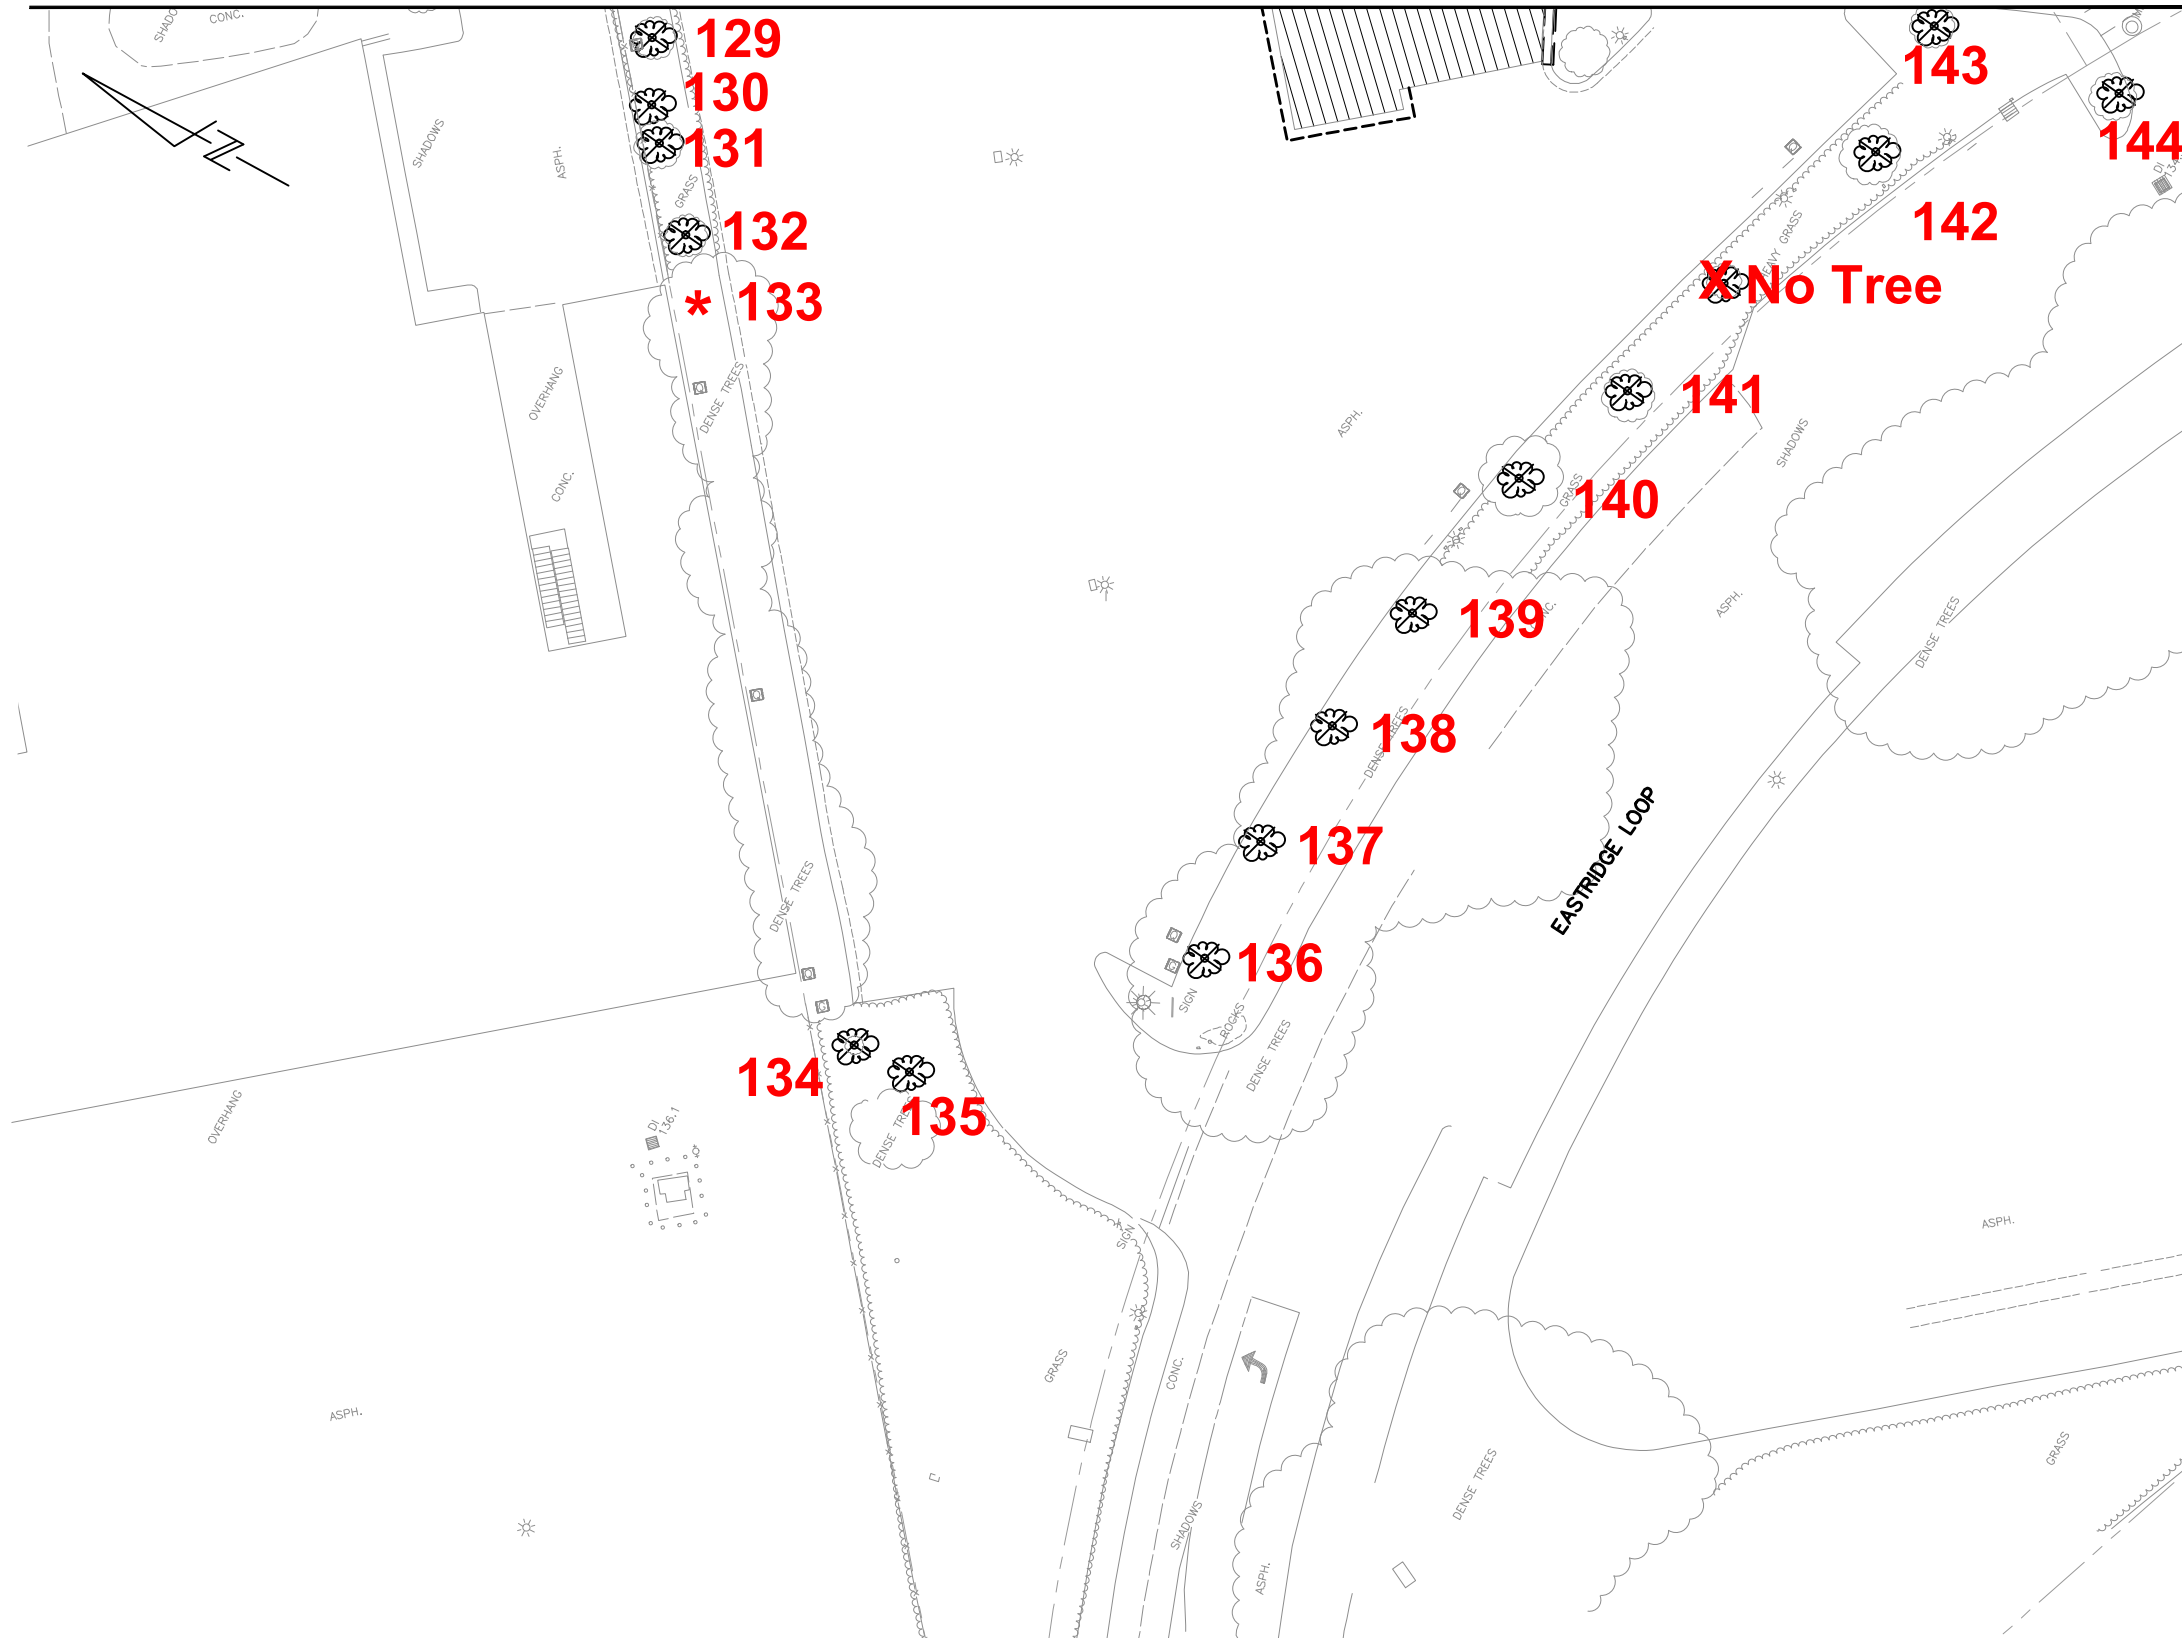


MATCH LINE – SEE SHEET CR127

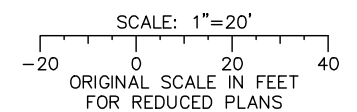

ALL DIMENSIONS ARE IN FEET UNLESS OTHERWISE SHOWN

HERN Oct 17, 2019 - 9:13am K:\2016\167189\_VTA\_CELR ENG EXHIBITS\010\_Tree Demo Exhibits\01CR126.dwg

| NO. | DATE  | REVISIONS         |
|-----|-------|-------------------|
| B   | 03/19 | 65% SUBMITTAL SET |
| A   | 06/18 | 35% SUBMITTAL SET |

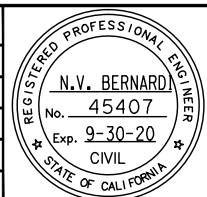

**BKF 100+ YEARS**  
ENGINEERS / SURVEYORS / PLANNERS

DESIGNED: C. Chi  
CHECKED: M. Cosentino  
DRAWN: A. Hernandez  
CADD FILE NAME: 801CR126.dwg



**BKF 100+ YEARS**  
ENGINEERS / SURVEYORS / PLANNERS


CADD FILE DATE: 03/01/19  
SCALE: 1" = 20'  
SUBMITTAL DATE: 03/11/19  
BOARD APPROVAL DATE:

|   |                      |                              |  |
|---|----------------------|------------------------------|--|
| EASTRIDGE TO BART REGIONAL CONNECTOR<br>CAPITOL EXPRESSWAY LIGHT RAIL PROJECT<br>CIVIL<br>DEMOLITION PLAN<br>EASTRIDGE LOOP |                      |                              | SHEET<br>OF<br>DRAWING NO.<br>CR126<br>REVISION<br>B |
| PCA NO.<br>000  | CONTRACT NO.<br>C801 | FILE LOCATION<br>PROJECTWISE |  |


**NOTE:**

FOR DEMOLITION PLAN NOTES AND LEGEND, SEE DRAWING CR001.

**TREES TO BE REMOVED SHOWN ON THIS SHEET: 2**

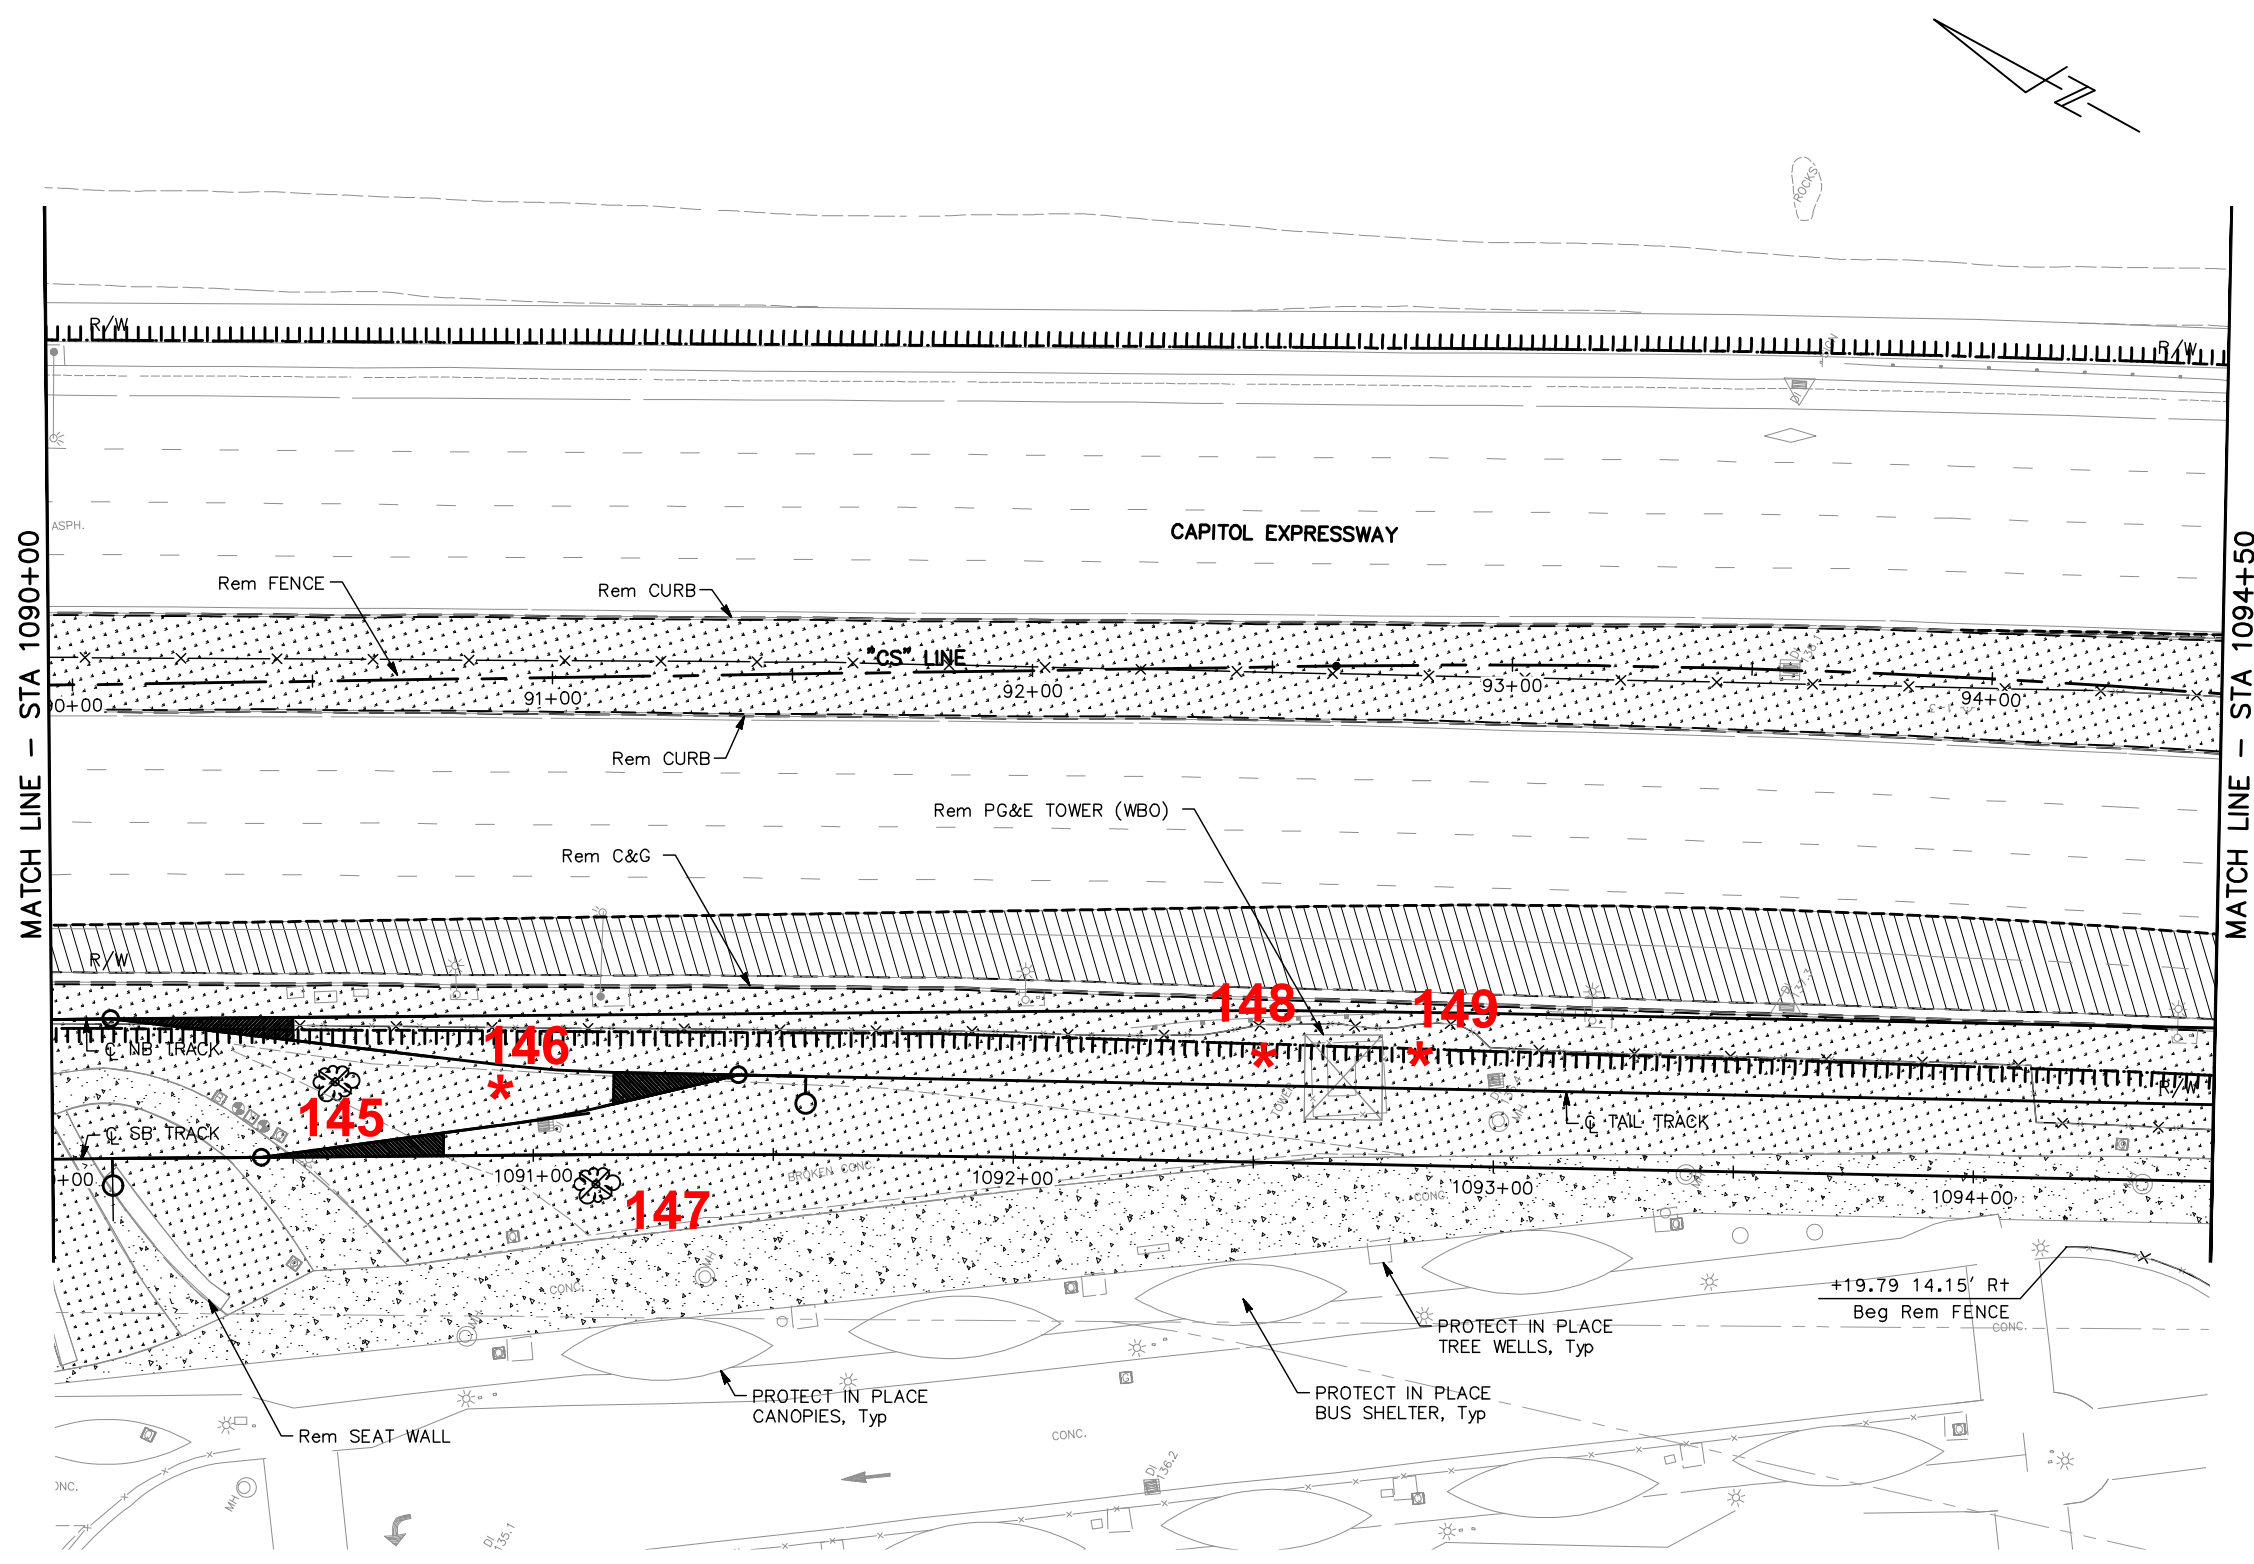


ALL DIMENSIONS ARE IN FEET UNLESS OTHERWISE SHOWN

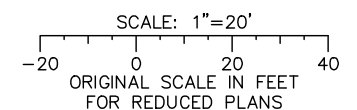

HERN Oct 17, 2019 - 9:15am K:\2016\167169\_VTA\_CELLAR VENG EXHIBITS\010 Tree Demo Exhibits\01CR028.dwg

| NO. | DATE  | REVISIONS         |
|-----|-------|-------------------|
| B   | 03/19 | 65% SUBMITTAL SET |
| A   | 06/18 | 35% SUBMITTAL SET |

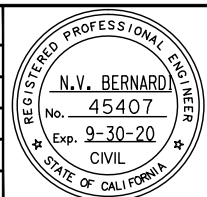

**BKF 100+ YEARS**  
**ENGINEERS / SURVEYORS / PLANNERS**  
 DESIGNED: C. Chi  
 CHECKED: M. Cosentino  
 DRAWN: A. Hernandez  
 CADD FILE NAME: 801CR028.dwg

**Santa Clara Valley Transportation Authority**

**BKF 100+ YEARS**  
**ENGINEERS / SURVEYORS / PLANNERS**  
 CADD FILE DATE: 03/01/19  
 SCALE: 1" = 20'  
 SUBMITTAL DATE: 03/11/19  
 BOARD APPROVAL DATE:

EASTRIDGE TO BART REGIONAL CONNECTOR  
 CAPITOL EXPRESSWAY LIGHT RAIL PROJECT  
 CIVIL  
 DEMOLITION PLAN  
 STA 1090+00 TO STA 1094+50

|             |                   |                           |
|-------------|-------------------|---------------------------|
| PCA NO. 000 | CONTRACT NO. C801 | FILE LOCATION PROJECTWISE |
|-------------|-------------------|---------------------------|

SHEET OF DRAWING NO. CR028 REVISION B

### EBRC TREE INVENTORY SPREADSHEET

| Tree # | Botanical Name       | Common Name      | CBH (Circumference at Breast Height) | Condition | Native? | Mitigation Requirement (if replacing w/ native)* | Mitigation Requirement (if replacing w/ non-native)* | Comments     | Noted in field, not on demo plan | Remove (per BKF demo plan) |
|--------|----------------------|------------------|--------------------------------------|-----------|---------|--|--|--------------|----------------------------------|----------------------------|
| 1      | Lagerstroemia indica | Crape Myrtle     | 7"                                   | Good      | N       | 1  | 2  |              |                                  | X                          |
| 2      | Lagerstroemia indica | Crape Myrtle     | 10"                                  | Good      | N       | 1  | 2  |              |                                  | X                          |
| 3      | Lagerstroemia indica | Crape Myrtle     | 20"                                  | Good      | N       | 1  | 2  |              |                                  | X                          |
| 4      | Lagerstroemia indica | Crape Myrtle     | 20"                                  | Good      | N       | 1  | 2  |              |                                  | X                          |
| 5      | Lagerstroemia indica | Crape Myrtle     | 20"                                  | Good      | N       | 1  | 2  |              |                                  | X                          |
| 6      | Lagerstroemia indica | Crape Myrtle     | 20"                                  | Good      | N       | 1  | 2  |              |                                  | X                          |
| 7      | Quercus suber        | Cork Oak         | 52"                                  | Good      | N       | 2  | 3  |              |                                  | X                          |
| 8      | Quercus suber        | Cork Oak         | 24"                                  | Good      | N       | 1  | 2  |              |                                  | X                          |
| 9      | Pistacia chinensis   | Chinese Pistache | 6"                                   | Fair      | N       | 1  | 2  |              |                                  | X                          |
| 10     | Acer rubrum          | Red Maple        | 18"                                  | Good      | N       | 1  | 2  |              |                                  | X                          |
| 11     | Acer rubrum          | Red Maple        | 12"                                  | Good      | N       | 1  | 2  |              |                                  | X                          |
| 12     | Acer rubrum          | Red Maple        | 24"                                  | Good      | N       | 1  | 2  |              |                                  | X                          |
| 13     | Acer rubrum          | Red Maple        | 24"                                  | Good      | N       | 1  | 2  |              |                                  | X                          |
| 14     | Acer rubrum          | Red Maple        | 12"                                  | Good      | N       | 1  | 2  |              |                                  | X                          |
| 15     | Lagerstroemia indica | Crape Myrtle     | 12"                                  | Good      | N       | 1  | 2  |              |                                  | X                          |
| 16     | Lagerstroemia indica | Crape Myrtle     | 10"                                  | Good      | N       | 1  | 2  |              |                                  | X                          |
| 17     | Lagerstroemia indica | Crape Myrtle     | 6"                                   | Good      | N       | 1  | 2  |              |                                  | X                          |
| 18     | Pyrus calleryana     | Flowering Pear   | 10"                                  | Fair      | N       | 1  | 2  | Basal damage |                                  | X                          |
| 19     | Lagerstroemia indica | Crape Myrtle     | 6"                                   | Good      | N       | 1  | 2  |              |                                  | X                          |
| 20     | Lagerstroemia indica | Crape Myrtle     | 10"                                  | Good      | N       | 1  | 2  |              |                                  | X                          |
| 21     | Lagerstroemia indica | Crape Myrtle     | 6"                                   | Good      | N       | 1  | 2  |              |                                  | X                          |
| 22     | Pyrus calleryana     | Flowering Pear   | 42"                                  | Fair      | N       | 2  | 3  | Basal damage |                                  | X                          |
| 23     | Lagerstroemia indica | Crape Myrtle     | 6"                                   | Good      | N       | 1  | 2  |              |                                  | X                          |
| 24     | Quercus suber        | Cork Oak         | 24"                                  | Fair      | N       | 1  | 2  | Basal damage |                                  | X                          |
| 25     | Fraxinus oxycarpa    | Raywood Ash      | 73"                                  | Good      | N       | 2  | 3  |              |                                  | X                          |
| 26     | Fraxinus oxycarpa    | Raywood Ash      | 73"                                  | Good      | N       | 2  | 3  |              |                                  | X                          |
| 27     | Fraxinus oxycarpa    | Raywood Ash      | 60"                                  | Good      | N       | 2  | 3  |              |                                  | X                          |
| 28     | Fraxinus oxycarpa    | Raywood Ash      | 36"                                  | Good      | N       | 1  | 2  |              |                                  | X                          |
| 29     | Pyrus calleryana     | Flowering Pear   | 36"                                  | Good      | N       | 1  | 2  |              | X                                |                            |

**EBRC TREE INVENTORY SPREADSHEET**

|    |                       |                  |     |      |   |   |   |              |   |   |
|----|-----------------------|------------------|-----|------|---|---|---|--------------|---|---|
|    | NO TREE               |                  |     |      |   |   |   |              |   | X |
| 30 | Chitalpa tashketensis | Chitalpa         | 15" | Fair | N | 1 | 2 | Stressed     |   | X |
| 31 | Platanus acerifolia   | London Plane     | 24" | Good | N | 1 | 2 |              |   | X |
| 32 | Platanus acerifolia   | London Plane     | 24" | Good | N | 1 | 2 |              |   | X |
| 33 | Platanus acerifolia   | London Plane     | 24" | Good | N | 1 | 2 |              |   | X |
| 34 | Platanus acerifolia   | London Plane     | 24" | Good | N | 1 | 2 |              |   | X |
| 35 | Platanus acerifolia   | London Plane     | 24" | Good | N | 1 | 2 |              |   | X |
| 36 | Platanus acerifolia   | London Plane     | 24" | Good | N | 1 | 2 |              |   | X |
| 37 | Albizzia julibrissin  | Silk Tree        | 24" | Fair | N | 1 | 2 | Poor shape   | X |   |
| 38 | Prunus serrulata      | Flowering Cherry | 24" | Fair | N | 1 | 2 | Poor shape   | X |   |
| 39 | Prunus cerasifera     | Flowering Plum   | 18" | Good | N | 1 | 2 | Narrow Strip |   | X |
| 40 | Platanus acerifolia   | London Plane     | 21" | Good | N | 1 | 2 |              |   | X |
| 41 | Platanus acerifolia   | London Plane     | 24" | Good | N | 1 | 2 |              |   | X |
| 42 | Platanus acerifolia   | London Plane     | 24" | Good | N | 1 | 2 |              |   | x |
| 43 | Platanus acerifolia   | London Plane     | 30" | Good | N | 1 | 2 |              |   | X |
| 44 | Platanus acerifolia   | London Plane     | 30" | Good | N | 1 | 2 |              |   | X |
| 45 | Platanus acerifolia   | London Plane     | 30" | Good | N | 1 | 2 |              |   | X |
| 46 | Quercus agrifolia     | Coast Live Oak   | 10" | Good | Y | 2 | 2 | CA Native    |   | X |
| 47 | Quercus agrifolia     | Coast Live Oak   | 15" | Good | Y | 2 | 2 | CA Native    |   | X |
| 48 | Platanus acerifolia   | London Plane     | 24" | Good | N | 1 | 2 |              |   | X |
| 49 | Platanus acerifolia   | London Plane     | 15" | Good | N | 1 | 2 |              |   | X |
| 50 | Platanus acerifolia   | London Plane     | 12" | Good | N | 1 | 2 |              |   | X |
| 51 | Platanus acerifolia   | London Plane     | 12" | Good | N | 1 | 2 |              |   | X |
| 52 | Platanus acerifolia   | London Plane     | 12" | Good | N | 1 | 2 |              |   | X |
| 53 | Platanus acerifolia   | London Plane     | 15" | Good | N | 1 | 2 |              |   | X |
| 54 | Platanus acerifolia   | London Plane     | 12" | Good | N | 1 | 2 |              |   | X |
| 55 | Platanus acerifolia   | London Plane     | 18" | Good | N | 1 | 2 |              |   | X |
| 56 | Platanus acerifolia   | London Plane     | 18" | Good | N | 1 | 2 |              |   | X |
| 57 | Platanus acerifolia   | London Plane     | 18' | Good | N | 1 | 2 |              |   | X |
| 58 | Platanus acerifolia   | London Plane     | 12" | Good | N | 1 | 2 |              |   | X |
| 59 | Platanus acerifolia   | London Plane     | 9"  | Good | N | 1 | 2 |              |   | X |
| 60 | Platanus acerifolia   | London Plane     | 18" | Good | N | 1 | 2 |              |   | X |

### EBRC TREE INVENTORY SPREADSHEET

|    |                         |                  |     |      |   |   |   |           |   |   |
|----|-------------------------|------------------|-----|------|---|---|---|-----------|---|---|
| 61 | Platanus acerifolia     | London Plane     | 18" | Good | N | 1 | 2 |           |   | X |
| 62 | Platanus acerifolia     | London Plane     | 18" | Good | N | 1 | 2 |           |   | X |
| 63 | Pistacia chinensis      | Chinese Pistache | 54" | Good | N | 2 | 3 |           |   | X |
| 64 | Pistacia chinensis      | Chinese Pistache | 48" | Good | N | 2 | 3 |           |   | X |
| 65 | Pistacia chinensis      | Chinese Pistache | 42" | Good | N | 2 | 3 |           |   | X |
| 66 | Pistacia chinensis      | Chinese Pistache | 24" | Good | N | 1 | 2 |           |   | X |
| 67 | Pistacia chinensis      | Chinese Pistache | 24" | Good | N | 1 | 2 |           | X |   |
| 68 | Pistacia chinensis      | Chinese Pistache | 24" | Good | N | 1 | 2 |           |   | X |
| 69 | Pistacia chinensis      | Chinese Pistache | 24" | Good | N | 1 | 2 |           |   | X |
| 70 | Pistacia chinensis      | Chinese Pistache | 18" | Good | N | 1 | 2 |           | X |   |
| 71 | Pistacia chinensis      | Chinese Pistache | 24" | Good | N | 1 | 2 |           | X |   |
| 72 | Liquidamber styraciflua | Sweet Gum        | 54" | Fair | N | 2 | 3 |           | X |   |
| 73 | Liquidamber styraciflua | Sweet Gum        | 72" | Fair | N | 2 | 3 |           |   | X |
| 74 | Liquidamber styraciflua | Sweet Gum        | 54" | Fair | N | 2 | 3 |           |   | X |
| 75 | Chitalpa tashketensis   | Chitalpa         | 9"  | Good | N | 1 | 2 |           |   | X |
| 76 | Chitalpa tashketensis   | Chitalpa         | 6"  | Good | N | 1 | 2 |           |   | X |
| 77 | Chitalpa tashketensis   | Chitalpa         | 9"  | Good | N | 1 | 2 |           |   | X |
| 78 | Chitalpa tashketensis   | Chitalpa         | 9"  | Good | N | 1 | 2 |           |   | X |
|    | NO TREE                 |                  |     |      |   |   |   |           |   | X |
| 79 | Chitalpa tashketensis   | Chitalpa         | 9"  | Good | N | 1 | 2 |           |   | X |
| 80 | Acer rubrum             | Red Maple        | 9"  | Good | N | 1 | 2 |           |   | X |
| 81 | Acer rubrum             | Red Maple        | 9"  | Good | N | 1 | 2 |           |   | X |
| 82 | Acer rubrum             | Red Maple        | 9"  | Good | N | 1 | 2 |           |   | X |
| 83 | Acer rubrum             | Red Maple        | 9"  | Good | N | 1 | 2 |           |   | X |
| 84 | Acer rubrum             | Red Maple        | 9"  | Good | N | 1 | 2 |           |   | X |
| 85 | Acer rubrum             | Red Maple        | 9"  | Good | N | 1 | 2 |           |   | X |
| 86 | Acer rubrum             | Red Maple        | 9"  | Good | N | 1 | 2 |           |   | X |
| 87 | Acer rubrum             | Red Maple        | 9"  | Good | N | 1 | 2 |           |   | X |
| 88 | Acer rubrum             | Red Maple        | 9"  | Good | N | 1 | 2 |           |   | X |
| 89 | Acer rubrum             | Red Maple        | 9"  | Good | N | 1 | 2 |           |   | X |
| 90 | Acer rubrum             | Red Maple        | 6"  | Good | N | 1 | 2 |           |   | X |
| 91 | Quercus agrifolia       | Coast Live Oak   | 3"  | Fair | Y | 2 | 2 | CA Native | X |   |



### EBRC TREE INVENTORY SPREADSHEET

|     |                      |                   |     |      |   |   |   |              |   |   |
|-----|----------------------|-------------------|-----|------|---|---|---|--------------|---|---|
| 92  | Quercus agrifolia    | Coast Live Oak    | 3"  | Fair | Y | 2 | 2 | CA Native    |   | X |
| 93  | Washingtonia robusta | Mexican Fan Palm  | 42" | Fair | N | 2 | 3 |              |   | X |
| 94  | Schinus molle        | California Pepper | 68" | Good | N | 2 | 3 |              |   | X |
| 95  | Washingtonia robusta | Mexican Fan Palm  | 48' | Fair | N | 2 | 3 |              |   | X |
| 96  | Washingtonia robusta | Mexican Fan Palm  | 48" | Fair | N | 2 | 3 |              |   | X |
| 97  | Washingtonia robusta | Mexican Fan Palm  | 48" | Fair | N | 2 | 3 |              |   | X |
| 98  | Washingtonia robusta | Mexican Fan Palm  | 48" | Fair | N | 2 | 3 |              |   | X |
| 99  | Washingtonia robusta | Mexican Fan Palm  | 48" | Fair | N | 2 | 3 |              |   | X |
| 100 | Eucalyptus sp.       | Eucalyptus        | 60" | Fair | N | 2 | 3 | Basal damage |   | X |
| 101 | Washingtonia robusta | Mexican Fan Palm  | 48" | Fair | N | 2 | 3 |              |   | X |
| 102 | Pyrus calleryana     | Flowering Pear    | 12" | Poor | N | 1 | 2 | Dead         |   | X |
| 103 | Acer rubrum          | Red Maple         | 12" | Good | N | 1 | 2 |              | X |   |
| 104 | Acer rubrum          | Red Maple         | 12" | Good | N | 1 | 2 |              |   | X |
| 105 | Acer rubrum          | Red Maple         | 12" | Good | N | 1 | 2 |              |   | X |
| 106 | Acer rubrum          | Red Maple         | 12" | Good | N | 1 | 2 |              |   | X |
| 107 | Washingtonia robusta | Mexican Fan Palm  | 36" | Good | N | 1 | 2 |              |   | X |
| 108 | Pyrus calleryana     | Flowering Pear    | 12" | Fair | N | 1 | 2 |              |   | X |
| 109 | Eucalyptus sp.       | Eucalyptus        | 12" | Fair | N | 1 | 2 |              |   | X |
| 110 | Pyrus calleryana     | Flowering Pear    | 12" | Fair | N | 1 | 2 |              |   | X |
| 111 | Pyrus calleryana     | Flowering Pear    | 12" | Poor | N | 1 | 2 | Stressed     |   | X |
| 112 | Eucalyptus sp.       | Eucalyptus        | 12" | Fair | N | 1 | 2 |              |   | X |
| 113 | Pyrus calleryana     | Flowering Pear    | 12" | Poor | N | 1 | 2 | Dead         |   | X |
| 114 | Eucalyptus sp.       | Eucalyptus        | 18' | Good | N | 1 | 2 |              | X |   |
| 115 | Pyrus calleryana     | Flowering Pear    | 9"  | Poor | N | 1 | 2 | Dead         |   | X |
| 116 | Pyrus calleryana     | Flowering Pear    | 9"  | Good | N | 1 | 2 |              |   | X |
| 117 | Pyrus calleryana     | Flowering Pear    | 9"  | Good | N | 1 | 2 |              |   | X |
| 118 | Pyrus calleryana     | Flowering Pear    | 12" | Good | N | 1 | 2 |              |   | X |
| 119 | Ulmus americana      | American Elm      | 24" | Fair | N | 1 | 2 | Multi        | X |   |
| 120 | Ulmus americana      | American Elm      | 24" | Fair | N | 1 | 2 | Multi        | X |   |
| 121 | Olea europaea        | Olive             | 12" | Good | N | 1 | 2 | Multi        | X |   |
| 122 | Olea europaea        | Olive             | 12" | Good | N | 1 | 2 | Multi        | X |   |
| 123 | Olea europaea        | Olive             | 12" | Good | N | 1 | 2 | Multi        | X |   |



# Appendix C

## Summary of Significant Environment Impacts and Mitigation Measures

## Appendix C Summary of Significant Environmental Impacts and Mitigation Measures

| Significant Impact <sup>1</sup>   | Mitigation Measures   | Level of Significance <sup>2</sup>    |                                       |                                       |                                    |
|---|---|---------------------------------------|---------------------------------------|---------------------------------------|------------------------------------|
|   |   | 2005 Final EIR                        | 2007 SEIR                             | 2014 Subsequent IS/MND                | SEIR-2 or Second Subsequent IS     |
| <b>Transportation (SEIR-2)</b>  |   |                                       |                                       |                                       |                                    |
| Impact TRN-2a (Traffic Impact at Capitol Expressway/ Story Road in 2018 (now 2023))   | No mitigation is feasible   | <b>Significant and Unavoidable</b>    | <b>Significant and Unavoidable</b>    | Less than Significant with Mitigation | <b>Significant and Unavoidable</b> |
| Impact TRN-2b (Traffic Impact at Capitol Expressway/Ocala Avenue in 2018 (now 2023))  | No mitigation is feasible   | <b>Significant and Unavoidable</b>    | <b>Significant and Unavoidable</b>    | <b>Significant and Unavoidable</b>    | <b>Significant and Unavoidable</b> |
| Impact TRN-2c (Traffic Impact at Capitol Expressway/ Tully Road in 2018 (now 2023))   | Mitigation Measure TRN-2c (Maintain eight lanes on Capitol Expressway at Tully Road Intersection) | Less than Significant with Mitigation | Less than Significant with Mitigation | N/A                                   | Not evaluated                      |
| Impact TRN-8b (Traffic Impact at Capitol Expressway/ Story road in 2025 (now 2043))   | No mitigation is feasible   | <b>Significant and Unavoidable</b>    | <b>Significant and Unavoidable</b>    | N/A                                   | <b>Significant and Unavoidable</b> |
| Impact TRN-8c (Traffic Impact at Capitol Expressway/ Ocala Avenue in 2025 (now 2043)) | No mitigation is feasible   | <b>Significant and Unavoidable</b>    | <b>Significant and Unavoidable</b>    | <b>Significant and Unavoidable</b>    | <b>Significant and Unavoidable</b> |
| Impact TRN-8d (Traffic Impact at Capitol Expressway/Tully Road in 2025 (now 2043))    | Mitigation Measure TRN-2c (Maintain eight lanes on Capitol Expressway at Tully Road Intersection) | Less than Significant with Mitigation | Less than Significant with Mitigation | N/A                                   | Not evaluated                      |

| Significant Impact <sup>1</sup>   | Mitigation Measures   | Level of Significance <sup>2</sup>    |                                       |                                       |                                       |
|---|---|---------------------------------------|---------------------------------------|---------------------------------------|---------------------------------------|
|   |   | 2005 Final EIR                        | 2007 SEIR                             | 2014 Subsequent IS/MND                | SEIR-2 or Second Subsequent IS        |
| Impact TRN (CON) -1 (Long-Term Street or Lane Closure)  | Mitigation Measures TRN (CON)-2a (Prepare Traffic Management Plan), TRN (CON)-2b (Inform Public of Traffic Detours), and TRN (CON)-2c (Inform Public of Transit Service Changes)  | Less than Significant with Mitigation | Less than Significant with Mitigation | Less than Significant with Mitigation | <b>Significant and Unavoidable</b>    |
| Impact TRN (CON)-2 (Long-Term Loss of Parking or Access Essential for Business Operations)                          | Mitigation Measures TRN (CON)-2a (Prepare Traffic Management Plan), TRN (CON)-2b (Inform Public of Traffic Detours), and TRN (CON)-2c (Inform Public of Transit Service Changes)  | Less than Significant with Mitigation | Less than Significant with Mitigation | Less than Significant with Mitigation | Less than Significant with Mitigation |
| <b><i>Air Quality and Climate Change (SEIR-2)</i></b>   |   |                                       |                                       |                                       |                                       |
| Impact AQ (CON)-1 (Temporary Increase in Construction-Related Emissions during Grading and Construction Activities) | Mitigation Measures AQ (CON)-1 (BAAQMD's BMPs to reduce particulate matter emissions from construction activities) and AQ (CON)-2 (BAAQMD's BMPs to reduce GHG emissions from construction equipment) and AQ (CON)-3 use Tier 3 or Tier 4 equipment where possible. | Less than Significant with Mitigation | Less than Significant with Mitigation | Less than Significant with Mitigation | Less than Significant with Mitigation |
| Impact AQ (CON)-3 (Cumulative PM2.5 Concentrations During Construction)   | Mitigation Measures CON-1 (AQ) (BAAQMD's BMPs to reduce particulate matter emissions from construction activities) and CON-2 (AQ)   | Not evaluated                         | Not evaluated                         | Not evaluated                         | <b>Significant and Unavoidable</b>    |

| Significant Impact <sup>1</sup>   | Mitigation Measures   | Level of Significance <sup>2</sup>    |                                       |                                       |                                       |
|---|---|---------------------------------------|---------------------------------------|---------------------------------------|---------------------------------------|
|   |   | 2005 Final EIR                        | 2007 SEIR                             | 2014 Subsequent IS/MND                | SEIR-2 or Second Subsequent IS        |
|   | (BAAQMD's BMPs to reduce GHG emissions from construction equipment) and AQ (CON)-3 (Use Tier 3 or Tier 4 equipment where possible).                                   |                                       |                                       |                                       |                                       |
| <b>Biological Resources (Second Subsequent IS)</b>                        |   |                                       |                                       |                                       |                                       |
| Impact BIO-7 (Permanent Loss of Habitat and Disturbance to Species)       | Mitigation Measure BIO-7 (Conduct Preconstruction Surveys for Western Burrowing Owls and Implement Measures to Avoid or Minimize Adverse Effects if Owls are Present) | Less than Significant with Mitigation | Less than Significant with Mitigation | Less than Significant with Mitigation | Less than Significant with Mitigation |
| Impact BIO-8 (Temporary Disturbance of Riparian Forest)                   | Mitigation Measures BIO-8a Conduct Preconstruction Surveys to Identify Environmentally Sensitive habitat areas) and BIO-8b (Compensate for Disturbed Riparian Forest) | Less than Significant with Mitigation | Less than Significant with Mitigation | N/A                                   | N/A                                   |
| Impact BIO-10 (Temporary Degradation of Water Quality)                    | Mitigation Measure BIO-10 (Implement Water Quality Measures)  | Less than Significant with Mitigation | Less than Significant with Mitigation | N/A                                   | N/A                                   |
| Impact BIO-11 (Loss or Disturbance of California Red-Legged Frog Habitat) | Mitigation Measures BIO-11a (Avoid and Minimize Effects to California Red-Legged Frog) and BIO-11b (Compensate for Loss of Aquatic Habitat for                        | Less than Significant with Mitigation | Less than Significant with Mitigation | N/A                                   | N/A                                   |

| Significant Impact <sup>1</sup>   | Mitigation Measures   | Level of Significance <sup>2</sup>    |                                       |                                       |                                       |
|---|---|---------------------------------------|---------------------------------------|---------------------------------------|---------------------------------------|
|   |   | 2005 Final EIR                        | 2007 SEIR                             | 2014 Subsequent IS/MND                | SEIR-2 or Second Subsequent IS        |
|   | California Red-Legged Frog)   |                                       |                                       |                                       |                                       |
| Impact BIO-12 (Permanent Loss of Aquatic Habitat, Temporary Disturbance of Riparian Habitat, and Temporary Disturbance of Southwestern Pond Turtle) | Mitigation Measure BIO-12 (Conduct Preconstruction Surveys for and Implement Measures to Avoid or Minimize Adverse Effects to Southwestern Pond Turtles if Present)                       | Less than Significant with Mitigation | Less than Significant with Mitigation | N/A                                   | Less than Significant with Mitigation |
| Impact BIO-14 (Temporary Disturbance of Nesting Raptors)  | Mitigation Measures BIO-14a (Conduct a Preconstruction Survey for Nesting Raptors) and BIO-14b (Avoid Active Raptor Nests)  | Less than Significant with Mitigation | Less than Significant with Mitigation | Less than Significant with Mitigation | Less than Significant with Mitigation |
| Impact BIO-15 (Temporary Disturbance to Nesting Habitat for Migratory Birds)  | Mitigation Measure BIO-15 (Conduct Preconstruction Surveys for Nesting Migratory Birds and Stop Construction until the Young have Fledged or the Nest is Removed in Accordance with CDFG) | Less than Significant with Mitigation | Less than Significant with Mitigation | Less than Significant with Mitigation | Less than Significant with Mitigation |
| Impact BIO-18 (Loss of Trees)   | Mitigation Measure BIO-18a (Conduct a Tree Survey) and BIO-18b (Replace Trees)  | Less than Significant with Mitigation | Less than Significant with Mitigation | Less than Significant with Mitigation | Less than Significant with Mitigation |

| Significant Impact <sup>1</sup>   | Mitigation Measures  | Level of Significance <sup>2</sup>    |                                       |                                       |  |
|---|--|---------------------------------------|---------------------------------------|---------------------------------------|--|
|   |  | 2005 Final EIR                        | 2007 SEIR                             | 2014 Subsequent IS/MND                | SEIR-2 or Second Subsequent IS                             |
| <b><i>Cultural Resources (Second Subsequent IS)</i></b>   |  |                                       |                                       |                                       |  |
| Impact CR-5 (Direct or Indirect Impacts to an Archaeological Resource)  | Mitigation Measure CR-5a (Develop and Implement a Historic Properties Treatment Plan Prior to Construction Activities) | Less than Significant with Mitigation | Less than Significant with Mitigation | Less than Significant with Mitigation | No Impact (with inclusion of standard practice procedures) |
| <b><i>Energy (Second Subsequent IS)</i></b>   |  |                                       |                                       |                                       |  |
| Impact E (CON)-1 (Consumption of Nonrenewable Energy Resources in a Wasteful, Inefficient, and/or Unnecessary Manner from Project Construction) | Mitigation Measure E (CON)-1 (Adopt Energy Conservation Measures)  | Less than Significant with Mitigation | Less than Significant with Mitigation | Less than Significant with Mitigation | Less than Significant with Mitigation                      |
| <b><i>Environmental Justice (SEIR-2)</i></b>  |  |                                       |                                       |                                       |  |
| Impact EJ-1 (Environmental Justice)   | No mitigation is feasible  | No Impact                             | <b>Significant and Unavoidable</b>    | N/A                                   | <b>Significant and Unavoidable</b>                         |
| <b><i>Geology, Soils, and Seismicity (Second Subsequent IS)</i></b>   |  |                                       |                                       |                                       |  |
| Impact GEO-4 (Risk Caused by Strong Seismic Ground Shaking)   | Mitigation Measure GEO-4 (Incorporate Caltrans Seismic Design Criteria)  | Less than Significant with Mitigation | Less than Significant with Mitigation | Less than Significant with Mitigation | Less than Significant with Mitigation                      |
| Impact GEO-5 (Risk Caused by Seismic-Related Ground Failure, Including Liquefaction)  | Mitigation Measure GEO-5 (Incorporate Liquefaction Minimization Methods)   | Less than Significant with Mitigation | Less than Significant with Mitigation | Less than Significant with Mitigation | Less than Significant with Mitigation                      |
| Impact GEO-6 (Risks from Lateral Spreading,   | Mitigation Measure GEO-6 (Minimize Risk of Lateral   | Less than Significant with Mitigation | Less than Significant with Mitigation | Less than Significant with Mitigation | Less than Significant with Mitigation                      |



| Significant Impact <sup>1</sup>  | Mitigation Measures  | Level of Significance <sup>2</sup>    |                                       |                                       |                                       |
|--|--|---------------------------------------|---------------------------------------|---------------------------------------|---------------------------------------|
|  |  | 2005 Final EIR                        | 2007 SEIR                             | 2014 Subsequent IS/MND                | SEIR-2 or Second Subsequent IS        |
| Subsidence, and Collapse)  | Spreading, Subsidence, and Collapse)   |                                       |                                       |                                       |                                       |
| Impact GEO-7 (Risk Caused by Expansive Soil)   | Mitigation Measure GEO-7 (Minimize Risk of Soil Expansivity)   | Less than Significant with Mitigation | Less than Significant with Mitigation | Less than Significant with Mitigation | Less than Significant with Mitigation |
| <b><i>Hazardous Materials (Second Subsequent IS)</i></b>   |  |                                       |                                       |                                       |                                       |
| Impact HAZ-9 (Hazard to the Public or Environment through Reasonable Foreseeable Upset and Accident Conditions Caused by the Release of Hazardous Materials) | Mitigation Measures HAZ-9a/(CON)-1a (Conduct Subsurface Investigations in Areas of the Corridor That May Be Underlain by Contaminated Soil or Groundwater) and HAZ-9b (Control Contamination Resulting from Previously Unidentified Hazardous Waste Materials) | Less than Significant with Mitigation | Less than Significant with Mitigation | Less than Significant with Mitigation | Less than Significant with Mitigation |
| Impact HAZ (CON)-1 (Release of Hazardous materials into the Environment)   | Mitigation Measures HAZ (CON)-1a (Conduct subsurface Investigations), HAZ (CON)-1b (Control Contamination), and HAZ (CON)-1c (Conduct Lead and Asbestos Surveys Prior to Building Demolition or Renovation),   | Less than Significant with Mitigation | Less than Significant with Mitigation | Less than Significant with Mitigation | Less than Significant with Mitigation |
| <b><i>Hydrology and Water Quality (Second Subsequent IS)</i></b>   |  |                                       |                                       |                                       |                                       |
| Impact HYD-11 (Violation of Water Quality Standards or   | Mitigation Measure HYD-11 (Comply with All Applicable Regulations and  | Less than Significant with Mitigation | Less than Significant with Mitigation | Less than Significant with Mitigation | N/A                                   |

| Significant Impact <sup>1</sup>  | Mitigation Measures   | Level of Significance <sup>2</sup>    |                                       |                                       |                                       |
|--|---|---------------------------------------|---------------------------------------|---------------------------------------|---------------------------------------|
|  |   | 2005 Final EIR                        | 2007 SEIR                             | 2014 Subsequent IS/MND                | SEIR-2 or Second Subsequent IS        |
| Waste Discharge Requirements)  | Subsequent Permit Programs Related to Water Quality Control)  |                                       |                                       |                                       |                                       |
| Impact HYD-12 (Creation of Additional Runoff)  | Mitigation Measure HYD-12 (Maintain Operational Water Quality)  | Less than Significant with Mitigation | Less than Significant with Mitigation | N/A                                   | Less than Significant with Mitigation |
| Impact HYD-13 (Alterations in Existing Drainage Patterns)  | Mitigation Measures HYD-11 (Comply with All Applicable Regulations and Subsequent Permit Programs Related to Water Quality Control) and HYD-14 (Construct Facilities to Minimize Flood Impacts) | Less than Significant with Mitigation | Less than Significant with Mitigation | N/A                                   | Less than Significant with Mitigation |
| Impact HYD-14 (Exposure to Flood Hazards)  | Mitigation Measure HYD-14 (Minimize Flood Impacts)  | Less than Significant with Mitigation | Less than Significant with Mitigation | Less than Significant with Mitigation | N/A                                   |
| Impact HYD (CON)-1 (Impair Water Quality)  | Mitigation Measure HYD (CON)-1 (Implement Water Quality Control Measures)   | Less than Significant with Mitigation | Less than Significant with Mitigation | Less than Significant with Mitigation | Less than Significant with Mitigation |
| Impact HYD (CON)-2 (Depletion of Groundwater Supplies)   | Mitigation Measure HYD (CON)-2 (Use Non-Potable Water)  | N/A                                   | N/A                                   | Less than Significant with Mitigation | Less than Significant with Mitigation |
| <b>Noise and Vibration (SEIR-2)</b>  |   |                                       |                                       |                                       |                                       |
| Impact NV-1 (Noise Levels from Transit Operations That Would Be Considered a Severe Impact by Federal Transit Administration Criteria) | Mitigation Measures NV-1a (Construct Soundwalls) and NV-1c (Provide Quiet Pavement)   | Less than Significant with Mitigation | Less than Significant with Mitigation | Less than Significant with Mitigation | Less than Significant with Mitigation |

| Significant Impact <sup>1</sup>   | Mitigation Measures  | Level of Significance <sup>2</sup>    |                                    |                                       |                                       |
|---|--|---------------------------------------|------------------------------------|---------------------------------------|---------------------------------------|
|   |  | 2005 Final EIR                        | 2007 SEIR                          | 2014 Subsequent IS/MND                | SEIR-2 or Second Subsequent IS        |
| Impact NV-4 (Vibration Levels in Buildings from Transit Operations That Exceed Federal Transit Administration Criteria) | Mitigation Measure NV-4b (Use Vibration-Dampening Track Construction Materials). No additional mitigation is recommended.  | Less than Significant with Mitigation | <b>Significant and Unavoidable</b> | Less than Significant with Mitigation | <b>Significant and Unavoidable</b>    |
| Impact NV (CON)-1: (Generation of Noise or Vibration That Substantially Affects Nearby Sensitive Receptors) (Noise)     | Mitigation Measures NV (CON)-1a (Notify Residents of Construction Activities), NV (CON)-1b (Construct Temporary Noise Barriers During Construction), NV (CON)-1c (Restrict Pile Driving), NV (CON)-1d (Use Noise Suppression Devices), NV (CON)-1e (Locate Stationary Construction Equipment as Far as Possible from Sensitive Receptors), NV (CON)-1f (Reroute Construction-Related Truck Traffic), and NV (CON)-1g (Develop Construction Noise Mitigation Plan), NV (CON)-2, and NV (CON)-1h (Use Impact Cushions) | Less than Significant with Mitigation | <b>Significant and Unavoidable</b> | <b>Significant and Unavoidable</b>    | Less than Significant with Mitigation |
| Impact NV (CON)-1: (Generation of Noise or Vibration That Substantially Affects   | Mitigation Measures NV (CON)-1a (Notify Residents of Construction Activities), NV (CON)-1c (Restrict Pile Driving), NV (CON)-1e  | Less than Significant with Mitigation | <b>Significant and Unavoidable</b> | <b>Significant and Unavoidable</b>    | <b>Significant and Unavoidable</b>    |

| Significant Impact <sup>1</sup>  | Mitigation Measures   | Level of Significance <sup>2</sup>    |                                       |                                       |                                       |
|--|---|---------------------------------------|---------------------------------------|---------------------------------------|---------------------------------------|
|  |   | 2005 Final EIR                        | 2007 SEIR                             | 2014 Subsequent IS/MND                | SEIR-2 or Second Subsequent IS        |
| Nearby Sensitive Receptors) (Vibration)  | (Locate Stationary Construction Equipment as Far as Possible from Sensitive Receptors), and NV (CON)-2  |                                       |                                       |                                       |                                       |
| <b><i>Safety and Security (Second Subsequent IS)</i></b>                       |   |                                       |                                       |                                       |                                       |
| Impact SS-3 (Pedestrian and/or Bicycle Safety Risks at Gated Crossings)        | Mitigation Measure SS-3 (Incorporate Pedestrian Friendly Features)  | Less than Significant with Mitigation | Less than Significant with Mitigation | Less than Significant with Mitigation | N/A                                   |
| Impact SS-4 (Inadequate Lighting or Visual Obstructions at Park-and-Ride Lots) | Mitigation Measures SS-4a (Implement Measures to Deter Crime), SS-4b (Use Lighting, Cameras, and Security Patrols to Enhance Safety), and SS-4c (Define Fire and Life Safety Procedures and Develop Evacuation Plans) | Less than Significant with Mitigation | Less than Significant with Mitigation | Less than Significant with Mitigation | Less than Significant with Mitigation |
| Impact SS (CON)-1 (Potential for Safety Risks during Construction)             | Mitigation Measure SS (CON)-1 (Implement Construction BMPs to Protect Workers and the Public)   | Less than Significant with Mitigation | Less than Significant with Mitigation | Less than Significant with Mitigation | Less than Significant with Mitigation |
| <b><i>Socioeconomics (Second Subsequent IS)</i></b>                            |   |                                       |                                       |                                       |                                       |
| Impact SOC-16 (Displacement of Existing Businesses or Housing)                 | Mitigation Measures SOC-16a (Comply with Legislation for Acquisition and Relocation) and SOC-16b (Inform Residents and Businesses of Project Status)  | Less than Significant with Mitigation | Less than Significant with Mitigation | Less than Significant with Mitigation | Less than Significant with Mitigation |

| Significant Impact <sup>1</sup>   | Mitigation Measures   | Level of Significance <sup>2</sup>    |                                       |                                       |                                       |
|---|---|---------------------------------------|---------------------------------------|---------------------------------------|---------------------------------------|
|   |   | 2005 Final EIR                        | 2007 SEIR                             | 2014 Subsequent IS/MND                | SEIR-2 or Second Subsequent IS        |
| <b>Utilities (Second Subsequent IS)</b>   |   |                                       |                                       |                                       |                                       |
| Impact UTL-3 (Require Construction of New Stormwater Drainage Facilities or Expansion of Existing Facilities) | Mitigation Measure HYD-14 (Maintain Operational Water Quality)  | Less than Significant with Mitigation | Less than Significant with Mitigation | Less than Significant with Mitigation | Less than Significant with Mitigation |
| Impact UTL (CON)-1 (Disrupt a Utility Service for a Period of 24 Hours or More)                               | Mitigation Measure UTL (CON)-1 (Coordinate with Utility Service Providers Prior to Construction of Light Rail Facilities) | Less than Significant with Mitigation | Less than Significant with Mitigation | Less than Significant with Mitigation | Less than Significant with Mitigation |
| <b>Visual Quality (Second Subsequent IS)</b>  |   |                                       |                                       |                                       |                                       |
| Impact VQ (CON)-1 (Creation of a New Source of Substantial Light or Glare)                                    | Mitigation Measure VQ (CON)-1 (Direct Lighting toward Construction Areas)   | Less than Significant with Mitigation | Less than Significant with Mitigation | Less than Significant with Mitigation | Less than Significant with Mitigation |
| Impact VQ-1 (Creation of Substantial Light or Glare)  | Mitigation Measure VQ-1 (Minimize Light and Glare)  | Less than Significant with Mitigation | Less than Significant with Mitigation | Less than Significant with Mitigation | Less than Significant with Mitigation |
| Impact VQ-3 (Degradation of Existing Visual Quality)  | Mitigation Measures VQ-3 (Involve Public in Station Design) and VQ-4 (Incorporate Landscaping)                            | Less than Significant with Mitigation | Less than Significant with Mitigation | Less than Significant with Mitigation | Less than Significant with Mitigation |
| <b>Construction (SEIR-2)</b>  |   |                                       |                                       |                                       |                                       |
| See construction-related impacts in the resource areas identified above.                                      |   |                                       |                                       |                                       |                                       |

| Significant Impact <sup>1</sup>   | Mitigation Measures   | Level of Significance <sup>2</sup> |                                       |                        |                                |
|---|---|------------------------------------|---------------------------------------|------------------------|--------------------------------|
|   |   | 2005 Final EIR                     | 2007 SEIR                             | 2014 Subsequent IS/MND | SEIR-2 or Second Subsequent IS |
| <b><i>Cumulative Effects (SEIR-2)</i></b>   |   |                                    |                                       |                        |                                |
| See Transportation, Air Quality and Climate Change, Environmental Justice, and Noise and Vibration.           |   |                                    |                                       |                        |                                |
| Impact E-Cum-9<br>(Increase Demand on Electricity Transmission Infrastructure)                                | No mitigation is feasible   | No Impact                          | <b>Significant and Unavoidable</b>    | N/A                    | N/A                            |
| Impacts NV-Cum-2<br>(Generate Noise from Pile Driving) and NV-Cum-3<br>(Generate Vibration from Pile Driving) | Mitigation Measures NV-Cum-2 and NV-Cum-3<br>(Coordinate activities with other construction projects where feasible and reasonable) | No Impact                          | Less than Significant with Mitigation | N/A                    | N/A                            |

# Appendix D

## Description of the Light Rail Alternative

# Description of the Eastridge to BART Regional Connector Project

The following section integrates the approved components of the Eastridge to BART Regional Connector (EBRC) Project from the 2005 Final Environmental Impact Report (EIR), 2007 Supplemental EIR, 2010 Revised Addendum, the 2014 Subsequent Mitigated Negative Declaration (MND), the 2019 Final Second Supplemental EIR, and the 2020 Second Addendum with the proposed change to the Project to provide a complete project description of the EBRC Project.

## **Eastridge to BART Regional Connector Project**


The EBRC Project would extend light rail along Capitol Expressway from the existing Alum Rock Light Rail Station to the Eastridge Transit Center a distance of approximately 2.4 miles. Light rail will operate primarily in the median of Capitol Expressway within exclusive and semi-exclusive rights-of-way. Property acquisition for the project would be minimized through the removal of two high-occupancy vehicle (HOV) lanes (one on each direction) on Capitol Expressway between Story Road and Tully Road. The project will include new light rail stations at Story Road (aerial) and Eastridge Transit Center (at-grade). The Project will also include traction power substations at Ocala Avenue and Eastridge Transit Center. Relocation and replacement of a number of 115-kilovolt steel lattice electrical transmission towers with Tubular Steel Poles (TSP) will be required as part of the Project.

Figure 1 shows the location of the EBRC Project.

Benefits of the EBRC Project are related to speed and travel time. The light rail trains would travel at high speeds and would be minimally impacted by roadway congestion. As a result, travel times for the EBRC Project would generally be faster, more reliable and dependable than other modes.

In addition, the EBRC Project would benefit transit users by providing a direct light rail connection to the Bay Area Rapid Transit (BART) at the Milpitas BART Station.



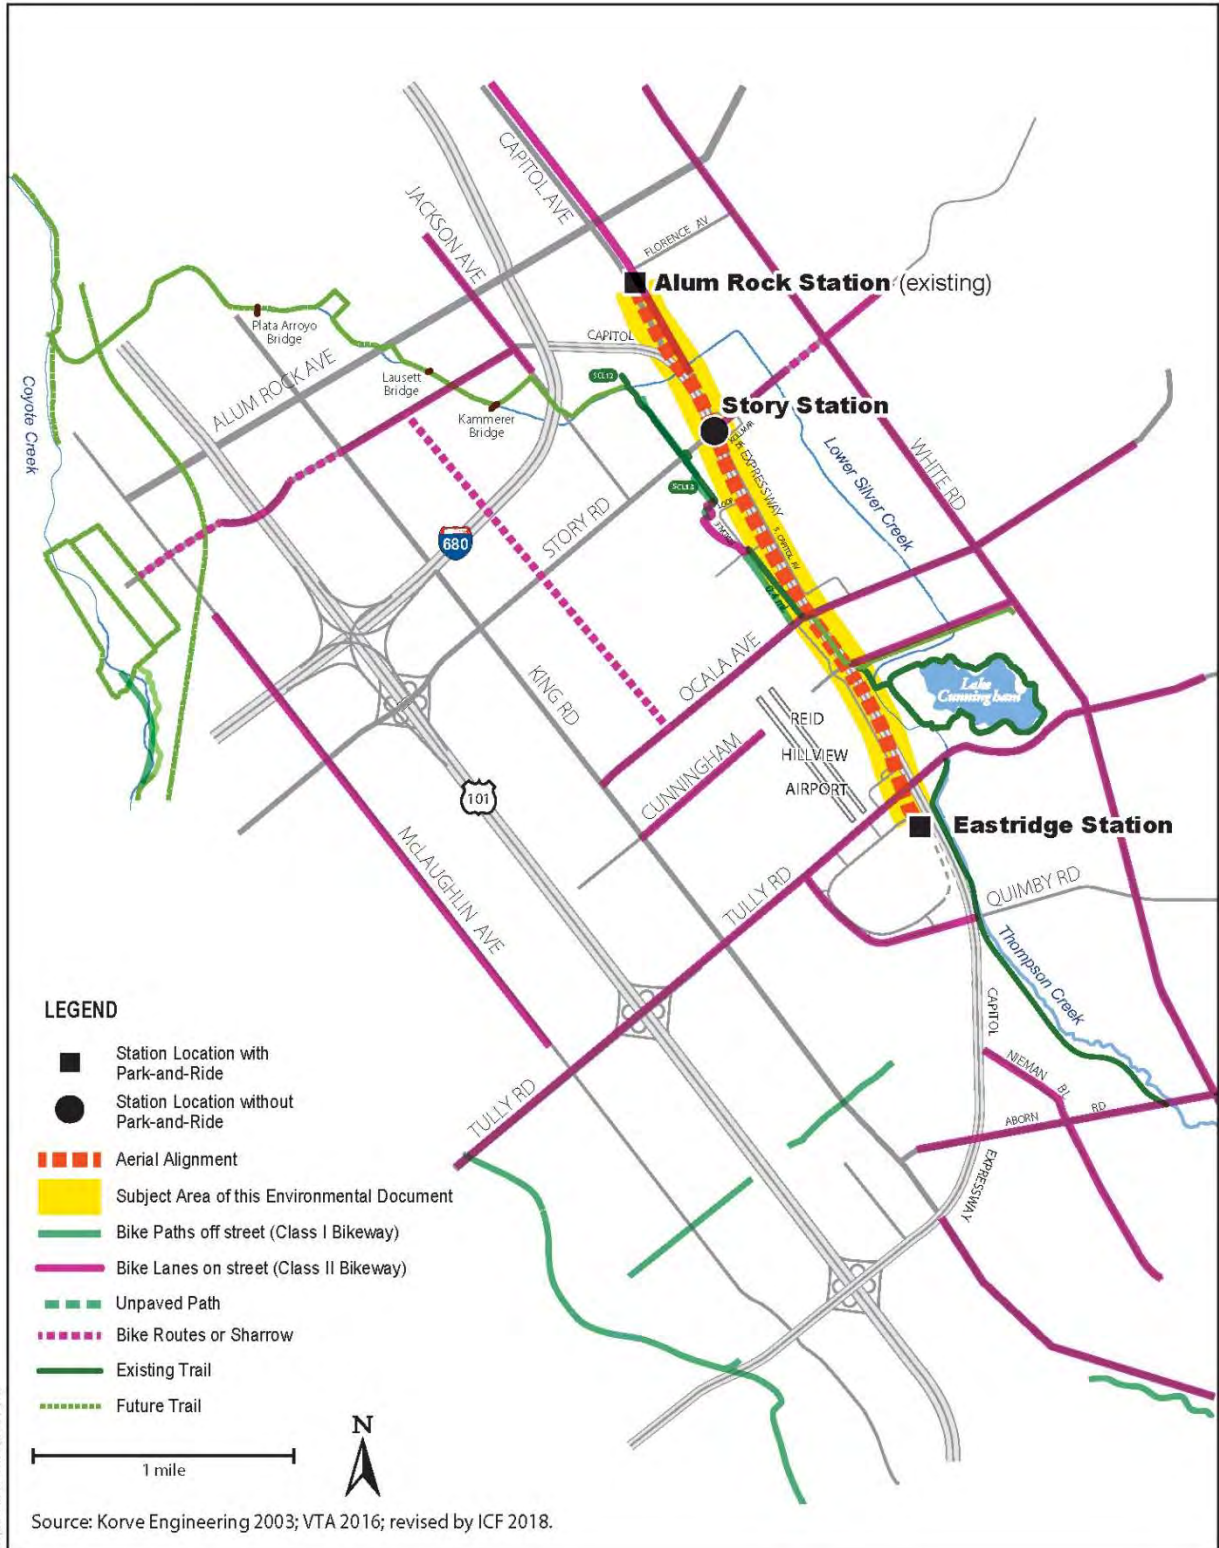

**Figure 1 EBRC Project Area**

**Background.** The EBRC Project is the last portion of the larger Capitol Expressway Corridor Project that transforms Capitol Expressway into a multi-modal boulevard offering pedestrian improvements, bus rapid transit (BRT), light rail transit (LRT), and convenient connections to the regional transit system. VTA first addressed pedestrian access and improved safety measures along Capitol Expressway between Quimby Road and Capitol Avenue. This was completed in Fall 2012 and included new sidewalks, street lighting, and landscaping . VTA also replaced the Eastridge Transit Center, which was completed in 2015.

In June 2016, VTA Board of Directors approved \$70 million to complete design, acquire right of way and relocate utilities for the project. In October 2016, VTA Board of Directors approved a full funding plan for the project. In June 2018, voters approved Regional Measure 3, which included \$130 million in funding for the project. In June 2020, the VTA Board of Directors approved the assignment of \$14 million in Low Carbon Transportation and Operations Program (LCTOP) funds to the EBRC Project.

## **URBAN DESIGN**

Since the conceptual engineering phase of the Capitol Expressway Corridor Project, there has been a consistent effort to incorporate attractive, urban design elements into the EBRC Project. These principles reflect the policy guidance of the Policy Advisory Board for this Project. The following section highlights the key urban design elements of the EBRC Project.

### *Urban Design Principles*

- Transform the expressway from an auto-oriented corridor to a multi-modal boulevard.
- Establish pedestrian and bicycle linkages along and across the corridor to connect neighborhoods to activity centers.
- Design stations to facilitate safe and convenient pedestrian access and to convey the personality and identity of adjacent neighborhoods.
- Introduce special treatments along the edges of the boulevard to reduce visual and noise impacts and to create a more positive relationship with adjacent neighborhoods.
- Promote opportunities for transit-oriented development that will enhance ridership and the quality of life of the surrounding community.

## **STATIONS AS NEIGHBORHOOD GATEWAYS**

The design of stations and their relationship with the adjacent neighborhoods is critical to promote a viable transit environment. Convenience, safety, and ease of access for residents and employees arriving by foot, bike, bus, or car are primary

---

design objectives. Additionally, stations can create identities and gateways to communities. Stations can also provide opportunities for neighborhood-serving retail uses and/or a mix of commercial, residential, and recreational uses. The EBRC Project will be consistent with the goal to integrate high-quality design enhancements, designed by artists and project architects, that reflect the identity of the communities and neighborhoods in which they are located.

There are numerous examples of community influenced design enhancements that have been incorporated into VTA's existing light rail stations. For example, at Alum Rock Station, artists working in coordination with the community designed special railings, shelter canopy glass, pavers, art tile benches, and entry markers.

## **ALIGNMENT DESCRIPTION**

The EBRC Project would be designed to reduce travel time and to support higher speed transit operations with grade separation at congested intersections. Construction of the light rail would alter the roadway geometry along some portions of Capitol Expressway. Perhaps the most dramatic change would be the removal of existing HOV lanes between Story Road and Tully Road to provide the additional right-of-way to accommodate light rail. While some property needs would be required for improvements and for utility relocations, especially at stations and substations, the removal of the HOV lanes would minimize the need for additional property for the EBRC Project and would be consistent with past policy decisions in the City of San Jose's Evergreen Specific Plan, Evergreen Specific Plan Transportation Improvements EIR and the Evergreen-East Hills Development Policy.

### *Alum Rock LRT Station to Story Road*

The light rail alignment would begin at the existing Alum Rock LRT Station on the Mountain View to Alum Rock LRT Line. In this section of the corridor, an aerial guideway would be constructed for the full distance from south of the Alum Rock LRT Station to south of Story Road to support higher speed transit operations and minimize congestion at major intersections. The guideway would be located largely in the median of Capitol Avenue and Capitol Expressway. The aerial guideway would include concrete columns supported on piled foundations. The aerial guideway would also include aerial sound walls where necessary to mitigate noise levels. At its northern end, the aerial structure would cross the northbound lanes of Capitol Avenue and Capitol Expressway and transition to an alignment in the median of Capitol Expressway. The light rail alignment would continue on the aerial structure over Story Road.

### *Story Road to Eastridge Transit Center*

From south of Story Road, the light rail alignment would continue on an aerial guideway for 1.25 miles to north of Tully Road. Before reaching Tully Road, the aerial guideway would transition from median-running north of Tully Road to side-running south of Tully Road. The light rail alignment would continue on the aerial

---

structure over Tully Road and return to grade on an embankment structure as it terminates at the Eastridge Transit Center

## **CROSSINGS**

The EBRC Project would include rail crossings along the corridor as shown in Table 1.

## **STATIONS AND PARK-AND-RIDE FACILITIES**

Two new stations are included with the EBRC Project between the northern terminus at the existing Alum Rock LRT Station and the southern terminus at the existing Eastridge Transit Center. The stations would be located approximately 1.0 miles apart. The placement of the stations was based on the desire to balance convenient passenger access and minimize travel time delay. The following sections describe each station along the alignment of the EBRC Project.

### *Alum Rock LRT Station (existing)*

At its northern end, the EBRC Project would connect to the existing light rail network at the Alum Rock LRT Station on the Mountain View to Alum Rock Line. The two lines would meet at the station, and the Mountain View to Alum Rock Line would be through-routed with the EBRC Project. Both lines would share the existing station platform and could operate in the same corridor. No improvements are anticipated at this station.

### *Story Station (new)*

The EBRC Project includes a two-level station in the median of Story Road with a mezzanine level and an elevated center platform. Since the traffic volumes and pedestrian/bicycle activity at the Story Road intersection are high, a single set of pedestrian overcrossings (POC) would be located south of Story Road connecting the southern corners of the intersections to the station. From the mezzanine level, an elevator and stairs would provide access to the station platform. The EBRC Project would restrict pedestrian access to the Story Station at the median to emergency purposes only.

Figure 2 shows the project features at Story Station.

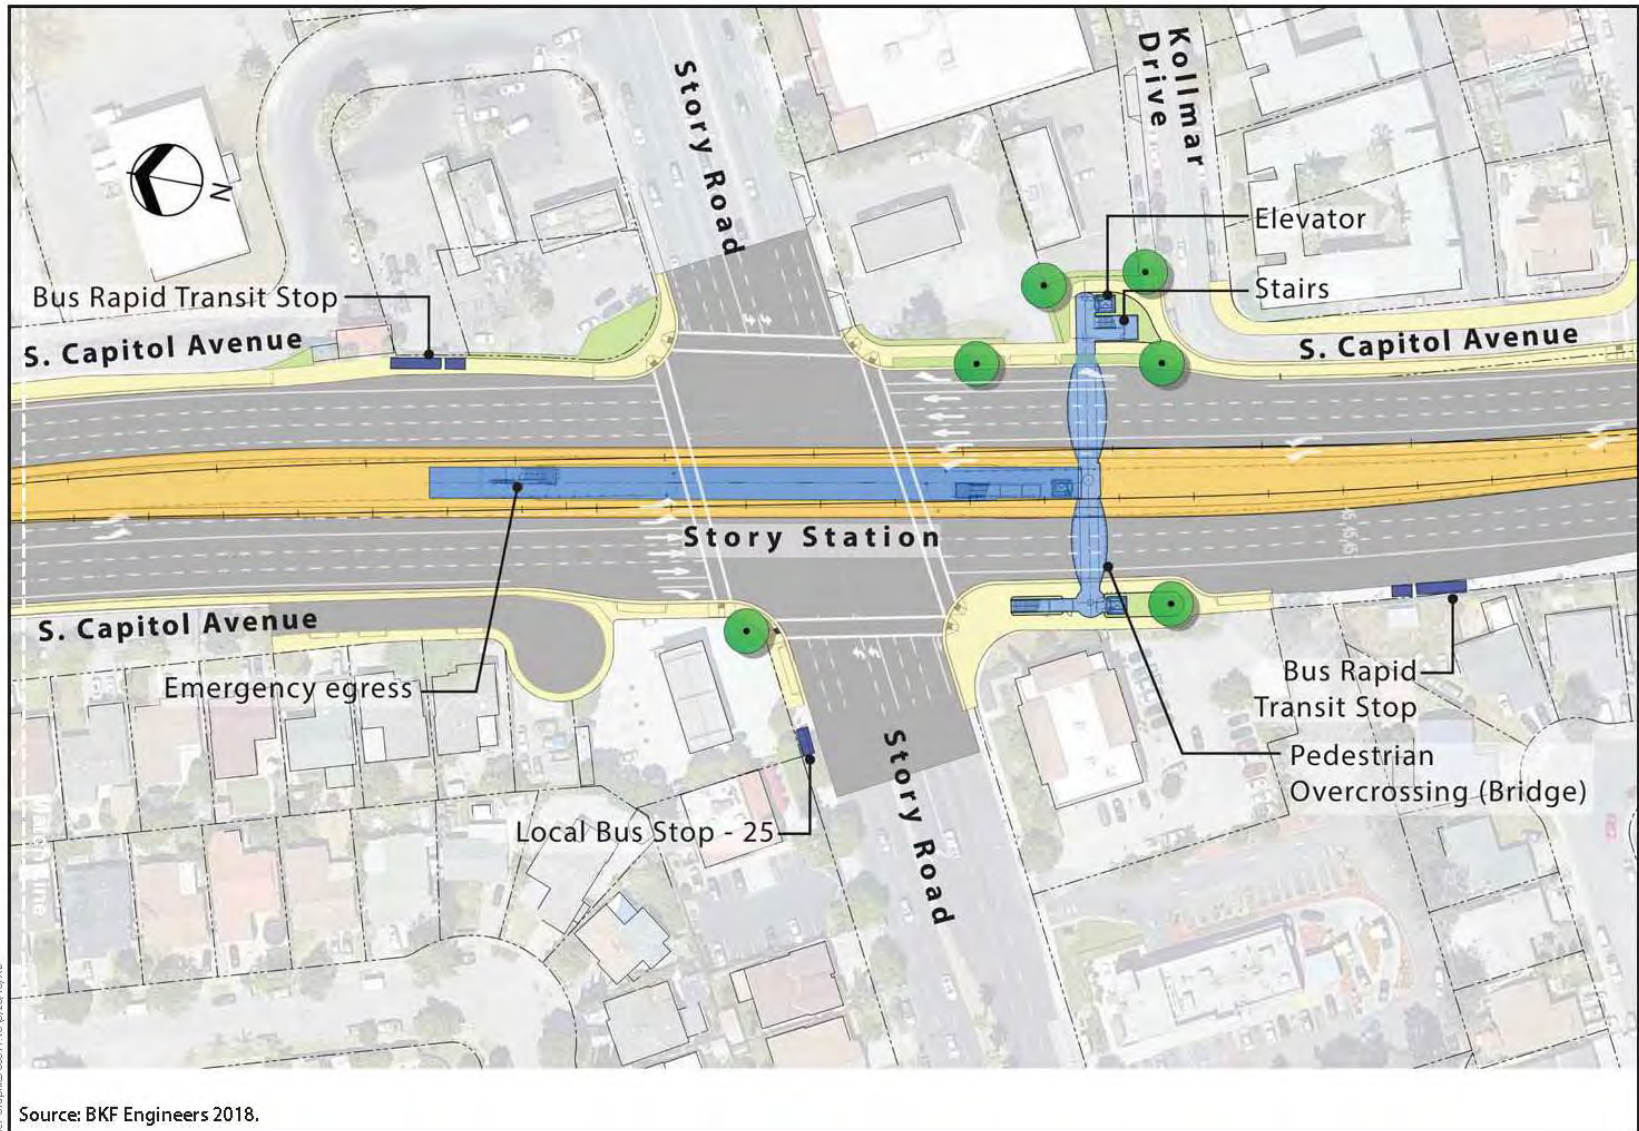


Figure 2 Story Station

**Table 1 Rail Crossings of the EBRC Project**

| <b>Cross Street</b>                  | <b>Track Stationing</b> | <b>Number of Tracks</b> | <b>Pedestrians</b> | <b>Automobiles</b>            | <b>Safety Risks</b>  | <b>Proposed Crossing Type</b>               | <b>Proposed Safety Devices (At Grade Crossings)</b> |
|--------------------------------------|-------------------------|-------------------------|--------------------|-------------------------------|--|---|---|
| Wilbur Avenue/Nuestra Castillo Court | +965+00                 | 2                       | 1 Crosswalk        | 2 Lanes                       | VTA buses, Left turns from Wilbur to southbound Capitol Avenue | At-grade (existing crossing with t-signals) | T-signals, Traffic signals                          |
| Northbound Capitol Avenue            | +974+00                 | 2                       | 2 Sidewalks        | 2 Lanes                       | High roadway traffic volumes                                   | Grade separated, Aerial                     | n/a   |
| Northbound Capitol Expressway        | +978+00                 | 2                       | 1 Sidewalk         | 4 Lanes                       | High roadway traffic volumes                                   | Grade separated, Aerial                     | n/a   |
| Story Road                           | +995+00                 | 2                       | 2 Crosswalks       | 6 Through lanes, 4 turn lanes | High auto and pedestrian traffic volumes. Left turn movements  | Grade separated, Aerial                     | n/a   |
| Ocala Avenue                         | +1037+00                | 2                       | 2 Crosswalks       | 4 Through lanes, 2 Turn lanes | School children, School buses, Heavy volume of LT movements    | Grade separated, Aerial                     | n/a   |
| Cunningham Avenue                    | +1050+00                | 2                       | 2 Crosswalks       | 2 Lanes                       | Light traffic volumes, low risk                                | Grade separated, Aerial                     | n/a   |
| SB Capitol Expressway                | +1067+00                | 2                       | 1 Sidewalk         | 3 Lanes                       | Heavy roadway traffic volumes                                  | Grade separated, Aerial                     | n/a   |

**Table 1 Rail Crossings of the EBRC Project**

| <b>Cross Street</b>                      | <b>Track Stationing</b> | <b>Number of Tracks</b> | <b>Pedestrians</b>     | <b>Automobiles</b>    | <b>Safety Risks</b>                      | <b>Proposed Crossing Type</b> | <b>Proposed Safety Devices (At Grade Crossings)</b> |
|--|-------------------------|-------------------------|------------------------|-----------------------|--|-------------------------------|---|
| Swift Lane                               | +1073+00                | 2                       | 2 Sidewalks            | 2 Lanes               | Light traffic volumes, low risk          | Grade separated, Aerial       | n/a   |
| Tully Road                               | +1078+00                | 2                       | 2 Sidewalks            | 6 Lanes, 4 Turn lanes | Heavy roadway traffic volumes            | Grade separated, Aerial       | n/a   |
| Northern Pedestrian Crossing to Platform | +1086+00                | 1                       | 1 Crossing of SB track | None                  | Incoming and departing trains            | At-grade                      | Crossing gates, Flashing Lights, and Bells          |
| Southern Pedestrian Crossing to Platform | +1089+80                | 1                       | 1 Crossing of SB track | None                  | Train movements in and out of tail track | At-grade                      | Crossing gates, Flashing Lights, and Bells          |

Source: VTA, 2018.

### *Eastridge Station (new)*

The Eastridge Transit Center is currently the second busiest transfer point in the VTA system, with significant bus transfer activity and a Park-and-Ride lot. Most bus routes serving the Downtown/East Valley area terminate at or pass through the center. The EBRC Project includes an at-grade station with one platform, tail tracks, and one traction power substation at the Eastridge Station. Additional project work at the Eastridge Station would include the following:

- Tail tracks, including a pocket track;
- Diamond crossover on the ballasted section of track;
- Passenger access at north and south ends of station;
- Platform raised on retained fill.

Figure 3 shows the proposed project features at the Eastridge Station.

### *Park-and-Ride Facilities*

Two existing Park-and-Ride lots are located along the alignment: Alum Rock Station and Eastridge Transit Center.

To serve the EBRC Project, there would be no increase in parking at Alum Rock Station due to space constraints. The Eastridge Park-and-Ride Lot currently includes 180 parking spaces due to the relocation of VTA Paratransit staff and vehicles to a remodeled building at this location in September 2017. VTA is proposing to increase the parking to approximately 302 spaces.

## **SUPPORT SYSTEMS**

In addition to the primary alignment, stations, and Park-and-Ride facilities, the EBRC Project would incorporate light rail support systems, including traction power and substations, overhead contact, supplemental feeders, communications, signaling, gates, Intrusion Detection System, closed-circuit television (CCTV) cameras, a fare collection system, and noise and vibration abatement. Support systems are described in the following sections.

### *Traction Power System and Substations*

A traction power system is a distribution system that converts high-voltage commercial electrical power received from substations to medium-voltage direct current (DC) and distributes it to the light rail vehicles via the overhead catenary or contact wire as they travel along the alignment. A traction power system consists of the power distribution mechanism and electrical substations. For the EBRC Project, the traction power system



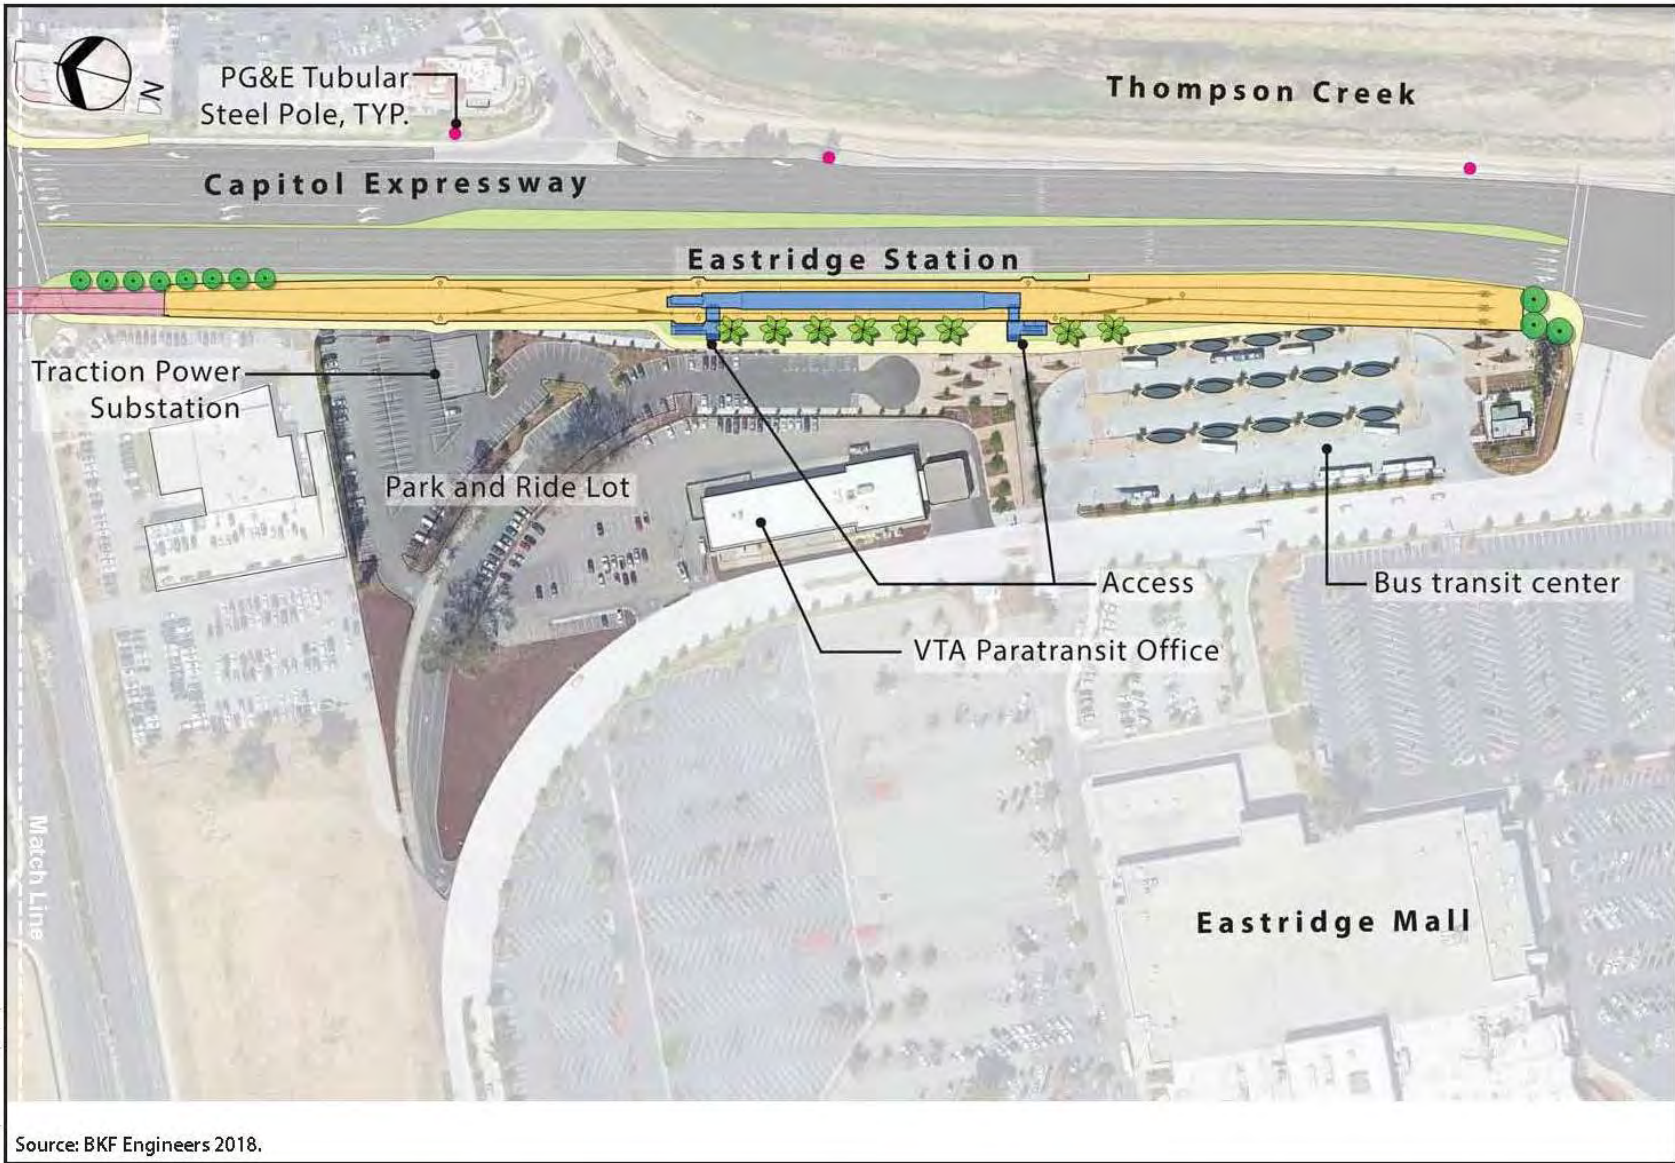


Figure 3 Eastridge Station

would provide the potential for three-car light rail trains operating at speeds up to 55 mph on approximately 5-minute headways, as provided by VTA Service Design Guidelines. During peak periods of use, such as during special events, the traction power system is anticipated to accommodate 3-minute headways.

The alignment would require a total of two substations, not including one existing substation south of the Alum Rock LRT Station near the Park-and-Ride lot shown in Figure 2.

Locations for new substations include the following:

- Southwest corner of Capitol Expressway and Ocala Avenue
- Eastridge Transit Center

Electrical power would be supplied to each traction power substation (TPSS) by an underground feeder from the electrical utility distribution system. Alternate substations would be equipped with two primary feeders from the utility company and an automatic transfer switch to supply reliable power to the substation. Each TPSS would be contained in a prefabricated substation housing that is factory wired to accommodate internal components and built on a concrete foundation. Foundations would be equipped with embedded conduit to accommodate incoming alternating current primary power cables, control and communication cables, and the DC feeder cables to the overhead contact system.

The estimated size for each TPSS building would be approximately 650–750 square feet in area and 12–15 feet in height. Parcels used as substation sites would need to be large enough to provide for side clearance from passing trains and automobiles and to allow a service vehicle to park, unless convenient parking is available on an adjacent roadway.

### ***Overhead Contact System***

The overhead contact system (OCS) would be an auto-tensioned simple catenary (ATSC) consisting of a contact wire, a messenger wire, and counterweight terminations (see Figure 4). This configuration represents the typical application for the VTA light rail system. The height of the contact wire would conform to the requirements of *VTA Light Rail Design Criteria Manual* and the California Public Utilities Commission's (CPUC's) General Order 95 (California Public Utilities Commission 1941). All OCS poles, except counterweight poles, would be constructed as tubular, hollow, tapered, round poles made of rigid galvanized steel.



**Figure 4 Overhead Contact System at Alum Rock Station**

Counterweight poles would be nontapered. The pole height would be adjusted to suit the contact wire height and match the existing system as closely as possible. The OCS poles would be located between the tracks or on the outside of the tracks, depending on space restrictions.

### *Communications Systems*

The communications equipment and design would be fully compatible with the communications system that serves VTA's existing light rail operations. A wayside cable system, fiber optic cable, and two-way radio system would link light rail

---

stations and TPSSs with the existing Operations Control Center. The communications system would consist of the following main components:

- Public address system with two-way voice announcement linking the Operations Control Center and the light rail stations.
- Two-way radio system with two-way voice announcement linking the Operations Control Center and light rail vehicles.
- Capability to monitor and control the TPSS switchgear functions from the Operations Control Center via the remote terminal units and wayside cable system.
- Cable transmission system designed to incorporate both the backbone communications distribution (fiber optics) and metallic distribution.

Wayside cabling would utilize a combined systems duct installed continuously along the corridor.

### *Signaling and Gates System*

The signal system for the EBRC Project would be an extension of the existing light rail signal system and functionally compatible with the existing lines. The signal system would include a wayside color light aspect with no cab signal and Automatic Block Signaling (ABS). (*Wayside color light aspect* refers to a signal at the side of the tracks indicating the next block is either clear or occupied.) The signal system would be designed to support the train headway goals of the EBRC Project. Generally, the alignment would not be gated except at the at-grade pedestrian crossings at Eastridge Station.

### *Intrusion Detection System*

Intrusion detection would be provided at the ends of the station platforms and at the aerial guideway approach embankments to provide warning of people either trespassing or walking in restricted areas. This information would be provided to VTA Operations Control Center to initiate a response from VTA security and to alert train operators to proceed with caution.

## **VEHICLE STORAGE FACILITIES**

The EBRC Project does not include any new vehicle maintenance and overnight storage facilities. Heavy maintenance activities for vehicles used on this line would continue to be performed at the existing Guadalupe Light Rail Division on Younger Street in San Jose.

## **PEDESTRIAN AND LANDSCAPING ENHANCEMENTS**

A separate project constructed pedestrian and landscaping improvements at various locations along Capitol Expressway between Capitol Avenue and Quimby Road. The

---

EBRC Project will remove approximately 210 – 220 trees where there are conflicts with the proposed alignment, especially where additional right-of-way is required for aerial guideways, stations, and utility relocations. The enhancements could include sidewalk, landscaping, or a multi-use path consisting of sidewalk, landscaping, and street lighting.

Between Foxdale Drive and Ocala Avenue, VTA will not replace the existing sidewalk along the west side of Capitol Expressway with a new multi-use path and landscaping for a distance of about 1,500 feet in order to minimize the acquisition of property from the backyards of adjacent residences.

To accommodate bicyclists to the greatest extent possible, curb lanes on both sides of Capitol Expressway will be 17–18 feet for the entire length to allow use of the shoulders by bicycles.

### **CAPITOL EXPRESSWAY ROADWAY LANE CONFIGURATIONS.**

In addition to restriping, a slight reduction in lane width, and minor modifications to traffic lanes, the Project would revise the roadway lane configurations along Capitol Expressway. The Project could include resurfacing Capitol Expressway with rubberized, open-graded asphalt concrete (OGAC).<sup>1</sup> Detailed track plans and profiles showing the proposed geometric design changes are included in Attachment C of the 2019 Final SEIR-2. The proposed roadway lane configuration includes the following.

- *Four traffic lanes in each direction north of Story Road.* Both of the existing high-occupancy vehicle lanes (one northbound and one southbound) would be converted to general purpose traffic lanes, resulting in a total of four general purpose lanes in each direction between Story Road and Capitol Avenue. One southbound inner general purpose lane would end at the introduction of the left turn pockets at Story Road. This would be accomplished by the widening of Capitol Expressway and a reduction of the median.
- *Right turn lanes.* Exclusive right turn lanes on Capitol Expressway would be added at Story Road, Cunningham Avenue, and Tully Road intersections.
- *Bicycle Slot.* At the locations where exclusive right turn lanes are added or maintained on Capitol Expressway, bicycle slots would be included to the left of the right turn lanes. Figure 5 includes pictures of a typical bicycle slot with bicycle detector.
- *Left turn lanes.* Longer left turn lanes on Capitol Expressway would be added at the following intersections: northbound and southbound at Story Road, northbound at Ocala Avenue, and southbound at Tully Road.

---

<sup>1</sup> Recent studies by Caltrans indicate that OGAC produces noticeably less vehicle noise than other pavement types (i.e., concrete and conventional asphalt).

- *Left turn pocket.* A second left turn pocket would be maintained on northbound Capitol Expressway at Story Road and Ocala Avenue.



a. View of an example bike slot facing west at Lawrence Expressway and Cabrillo Avenue in the City of Santa Clara.



b. View of a bike detector embedded in a bike slot. The purpose of a bike detector is to detect a bicyclist approaching an intersection and communicate with the traffic signal cabinet to provide enough time for cyclists to safely cross an intersection.

Source: VTA and ICF 2018.

**Figure 5 Representation Of Bicycle Slots**

## UTILITY RELOCATIONS

The Project will include minor utility relocations (e.g., water, gas, communications, electric lines, sanitary sewer, stormwater, etc.), as necessary.

---

In addition, 6 steel lattice towers and 2 Tubular Steel Poles [TSPs] carrying the Pacific Gas & Electric Company's (PG&E) McKee-Piercy and Milpitas-Swift sections of the 115 kilovolt transmission lines would need to be relocated between Ocala Avenue and north of Quimby Road. A total of 10 new TSPs would be installed. It is anticipated that the TSPs would need to be up to 121 feet in height in order to clear the aerial guideway. As a result of the increase in height of the TSPs and the proximity to Reid-Hillview Airport, PG&E may need to install red light-emitting diode (LED) obstruction lighting on some or all of the new or modified towers or poles in accordance with Federal Aviation Administration (FAA) requirements. These lights would be powered by either solar panels or local distribution electric lines. One of the TSPs (No. 54) may require right-of-way from the Santa Clara Valley Water District for placing the TSP and its foundation. The new TSPs would be mounted on a drilled foundation. Figures 6a and 6b show the proposed project work for the electrical transmission facilities.

The new TSPs would be mounted on a drilled foundation, and construction of the foundation for TSP No. 53A, 54, and 55 may require temporary closure of the Thompson Creek Trail for safety during drilling, and foundation operations. Approximately 60 – 70 trees that are within the aerial easement of the electrical transmission facilities will need to be removed per PG&E's latest Greenbook Manual. For TSPs located immediately adjacent to Capitol Expressway, a pull-out area will be provided for safe ingress and egress of PG&E maintenance vehicles.

## **PHOTOVOLTAIC SYSTEM**

The Project will include a parking canopy with a 92 kW photovoltaic system at Eastridge Transit Center that will offset the electricity requirements of the light rail station, the Eastridge Park-and-Ride Lot, and the Eastridge Transit Center.

## **RIGHT-OF-WAY REQUIREMENTS**

The majority of the improvements will be constructed within existing public right-of-way. There are a number of locations, however, where the EBRC Project will require minor amounts of additional right-of-way. Based on preliminary designs, the locations where additional right-of-way will be required are listed in Table 2.

Easements and other right-of-way requirements may change (i.e., increase or decrease in size, change type, and/or change from permanent to temporary, etc.) during final design while being within the scope of the project and minor in nature. It is the intent of this environmental document to environmentally clear easements and other right-of-way requirements that are generally indicative of the type of work required, recognizing some adjustments may be necessary based on final design and/or working with individual property owners during the real estate acquisition process. Should modifications beyond the scope of the project trigger the need for additional environmental review pursuant to CEQA and NEPA, subsequent environmental analysis would be required.



Figure 6a Electrical Transmission Facilities





Figure 6b Electrical Transmission Facilities

**Table 2 Preliminary Right-of-Way Requirements for the EBRC Project**

| No. | Assessor's Parcel Number | Address   | Existing Use  | Right-of-Way Needed                        | Right-of-Way Requirement (square feet) |           | Partial or Full Right-of-Way Requirement |
|-----|--------------------------|---|---------------|--|--|-----------|--|
|     |                          |   |               |  | Permanent                              | Temporary |  |
| 1   | 484-33-108               | 2701 Story Road                                     | Business      | TCE  | 0                                      | 237       | Partial                                  |
| 2   | 488-01-041               | 2710 Story Road                                     | Business      | Partial Fee Take, TCE, Permanent Easement  | 1,175                                  | 1,845     | Partial                                  |
| 3   | 488-01-002               | 1148 Kollmar Drive                                  | Business      | Partial or Full Fee Take, <sup>1</sup> TCE | 2,428                                  | 1,523     | Partial                                  |
| 4   | 488-01-004               | 2710 Kollmar Drive                                  | Multi-Family  | TCE  | 0                                      | 687       | Partial                                  |
| 5   | 488-01-037               | 2709 Sussex Drive                                   | Single-Family | TCE  | 0                                      | 74        | Partial                                  |
| 6   | 491-01-016               | SE Corner of Capitol Expressway & Cunningham Avenue | Public        | Partial Fee Take, TCE <sup>2</sup>         | 514                                    | 701       | Partial                                  |
| 7   | 491-02-073               | 3000 E. Capitol Expressway                          | Business      | Partial Fee Take, TCE, Permanent Easement  | 2,246                                  | 1,757     | Partial                                  |
| 8   | 491-02-074               | 3001 E. Capitol Expressway                          | Business      | Partial Fee Take, TCE, Permanent Easement  | 8,496                                  | 10,582    | Partial                                  |
| 9   | 491-02-069               | 2880 E. Capitol Expressway                          | Business      | Permanent Easement                         | 922                                    | 0         | Partial                                  |
| 10  | 491-02-070               | 2950 E. Capitol Expressway                          | Business      | Permanent Easement                         | 1,582                                  | 0         | Partial                                  |
| 11  | 491-02-071               | 2950 E. Capitol Expressway                          | Business      | Permanent Easement                         | 4,644                                  | 0         | Partial                                  |
| 12  | 491-02-072               | 2990 E. Capitol Expressway                          | Business      | TCE, Permanent Easement                    | 1,194                                  | 1,917     | Partial                                  |
| 13  | 491-02-066               | Thompson Creek                                      | Public        | Permanent Easement                         | 21,770                                 | 0         | Partial                                  |
| 14  | 491-48-006               | Thompson Creek                                      | Public        | Permanent Easement                         | 4,706                                  | 0         | Partial                                  |

**Table 2 Preliminary Right-of-Way Requirements for the EBRC Project**

| No. | Assessor's Parcel Number | Address                       | Existing Use  | Right-of-Way Needed                                   | Right-of-Way Requirement (square feet) |           | Partial or Full Right-of-Way Requirement |
|-----|--------------------------|-------------------------------|---------------|---|--|-----------|--|
|     |                          |                               |               |   | Permanent                              | Temporary |  |
| 15  | 484-45-060               | 2686 Lombard Avenue           | Single-Family | TCE   | 0                                      | 465       | Partial                                  |
| 16  | 484-45-061               | 353 S. Capitol Avenue         | Single-Family | TCE   | 0                                      | 337       | Partial                                  |
| 17  | 484-45-062               | 455 S. Capitol Avenue         | Single-Family | TCE   | 0                                      | 310       | Partial                                  |
| 18  | 484-45-116               | 461 S. Capitol Avenue         | Business      | Partial Fee Take, TCE                                 | 2,277                                  | 2,223     | Partial                                  |
| 19  | 484-34-015               | 1017 S. Capitol Avenue        | Single-Family | TCE   | 0                                      | 250       | Partial                                  |
| 20  | 484-34-016               | 1033 S. Capitol Avenue        | Single-Family | Partial Fee Take, TCE                                 | 22                                     | 250       | Partial                                  |
| 21  | 484-34-017               | 1049 S. Capitol Avenue        | Single-Family | Partial or Full Fee Take, <sup>1</sup> TCE            | 225                                    | 335       | Partial                                  |
| 22  | 484-34-131               | 1091 & 1093 S. Capitol Avenue | Business      | Partial or Full Fee Take <sup>1</sup> , TCE           | 1,829                                  | 277       | Partial                                  |
| 23  | 484-34-019               | 2695 Story Road               | Business      | Partial Fee Take, TCE                                 | 3,977                                  | 878       | Partial                                  |
| 24  | 486-39-025               | 1330 Foxdale Loop             | Multi-Family  | TCE   | 0                                      | 4,593     | Partial                                  |
| 25  | 486-43-106               | 2690 Story Road               | Business      | Partial Fee Take, TCE                                 | 1,479                                  | 3,343     | Partial                                  |
| 26  | 486-43-108               | 2680 Story Road               | Business      | TCE. Permanent Easement                               | 3                                      | 6         | Partial                                  |
| 27  | 491-15-003               | Reid-Hillview Airport         | Public        | Partial Fee Take, TCE, Permanent Easement             | 8,299                                  | 1,084     | Partial                                  |
| 28  | 491-15-041               | Swift Avenue                  | Utility       | Partial Fee Take, TCE Permanent Easement <sup>2</sup> | 1,817                                  | 816       | Partial                                  |
| 29  | 491-13-009               | Reid-Hillview Airport         | Public        | Permanent Easement                                    | 1,401                                  | 0         | Partial                                  |

**Table 2 Preliminary Right-of-Way Requirements for the EBRC Project**

| No.                               | Assessor's Parcel Number | Address                      | Existing Use        | Right-of-Way Needed                       | Right-of-Way Requirement (square feet) |                | Partial or Full Right-of-Way Requirement |
|-----------------------------------|--------------------------|------------------------------|---------------------|---|--|----------------|--|
|                                   |                          |                              |                     |   | Permanent                              | Temporary      |  |
| 30                                | 491-05-001               | North of Airport Access Road | Public              | TCE, Permanent Easement                   | 1,699                                  | 106,481        | Partial                                  |
| 31                                | 491-05-020               | Reid-Hillview Airport        | Public              | Partial Fee Take, Permanent Easement, TCE | 16,598                                 | 5,169          | Partial                                  |
| 32                                | 491-04-012               | 290 E. Capitol Expressway    | Business            | Full Fee Take                             | 3,030                                  | 0              | Full                                     |
| 33                                | 491-04-047               | 290 E. Capitol Expressway    | Business            | Full Fee Take                             | 5,864                                  | 0              | Full                                     |
| 34                                | 484-33-110               | 2785 Mervyns Way             | Public              | Partial Fee Take, TCE                     | 374                                    | 642            | Partial                                  |
| 35                                | NA                       | NA <sup>2</sup>              | Public Right-of-Way | Permanent Easement                        | 32,575                                 | 0              | Partial                                  |
| 36                                | NA                       | NA <sup>2</sup>              | Public Right-of-Way | Permanent Easement                        | 4,134                                  | 0              | Partial                                  |
| <b>Total Right-of-Way Needed:</b> |                          |                              |                     |   | <b>135,280</b>                         | <b>146,782</b> | <b>NA</b>                                |

Notes:

TCE = Temporary Construction Easement; NA = Not Applicable; IEE = Ingress Egress Easement

Partial Fee Take refers to the partial right-of-way need of a parcel; Full Fee Take refers to the full right-of-way need of a parcel.

<sup>1</sup> These areas are within public right-of-way, and do not have an Assessor's Parcel Number or address associated with them.

Source: BKF 2018.

---

## OPERATING ASSUMPTIONS

For the purposes of environmental analysis, the operating assumptions are based on past, current, and reasonably foreseeable future service plans. The purpose is to assess the project’s effect on the environment under the “worst-case” conditions. The key operating assumptions are as follows:

- The EBRC Project is assumed to operate on both the Santa Teresa to Alum Rock Line and the proposed new line from Mountain View to Alum Rock.
- The EBRC Project is assumed to operate one to three-car trains depending on ridership demands. Initially, VTA plans to operate two-car trains during peak hours in this corridor.
- The hours of operation are assumed to be between 4:30 a.m. and 1:30 a.m.
- Initially, VTA plans to operate on 15 minute headways on each line for 7.5 minute combined headways for both lines during peak hours. For the segment of the alignment between the Alum Rock LRT Station and Eastridge Transit Center, the estimated running time would be approximately 4.3 minutes, as shown in Table 3.
- Generally, the EBRC Project will be designed for 55 mph operations.

**Table 3 LRT Estimated Travel Time and Speed**

| LRT Segments                       | Distance/Average Speed/Time |     |      |
|------------------------------------|-----------------------------|-----|------|
|                                    | Miles                       | mph | min. |
| Alum Rock TC to Story Station      | 0.6                         | 25  | 1.4  |
| Story Station to Eastridge Station | 1.8                         | 45  | 2.9  |
| <b>Corridor Total</b>              | 2.4                         | 35  | 4.3  |

Notes:

<sup>1</sup> Travel speed and time are assumed to be approximately the same for AM and PM hours as well as northbound and southbound directions as the aerial guideway would not be affected by vehicular traffic.

<sup>2</sup> Approximately 30 seconds of dwell time would be experienced at Story Station.

Source: BKF, 2018.

## CONSTRUCTION SCENARIO

Project construction would take place over several years. Most of the construction work would occur in multiple locations along the project corridor between Alum Rock LRT Station and Eastridge Transit Center. Utility relocations would take place in 2019. Construction of the EBRC Project is anticipated to begin in 2020 and end in 2024. Construction would consist of clearing and grubbing, grading, structural work, trackwork, and paving. Major construction at Eastridge Mall during the holiday season will be minimized to the extent practicable.

---

At the height of construction, a number of construction employees and equipment would occupy portions of the street, including the median and potentially parking spaces, at active construction locations. In the most active areas, construction activities would periodically reduce the capacity of Capitol Expressway to two lanes in the northbound direction, and one lane in the southbound direction during non-peak hours of travel. Three travel lanes in each direction are expected to stay open during peak hours of travel. One left turn lane in each travel direction may be closed at intersections temporarily during various construction events. Lane closures would be contingent on the requirements and restrictions of the County of Santa Clara and the City of San Jose. If lane closures for construction activities are further restricted, an increase of approximately one year would be anticipated in the duration of project construction, moving the construction completion from 2024 to 2025.

In addition, construction activities may be necessary during night, early morning, and weekend periods to minimize traffic disruption. Construction activities at night may involve partial or complete intersection closures along Capitol Expressway at Capitol Avenue, Story Road, Ocala Avenue, Cunningham Avenue, Swift Lane and Tully Road. Complete expressway closures at night may occur in each travel direction (northbound and southbound) of Capitol Expressway for work on the proposed pedestrian overcrossing.

The aerial guideway sections would require extensive pile driving. It is anticipated that 6 to 12 piles would be driven per day for 3 to 6 days at each column site. The column sites are spaced approximately 120 to 130 feet apart. Pile driving could occur simultaneously at 2 locations along the alignment.

The main construction staging area would likely occur on vacant airport property between Cunningham Avenue and Tully Road subject to the concurrence of Santa Clara County Roads and Airports, and also at Eastridge Transit Center. The median of expressway would also be used as a staging area for daily activities.

**From:** VTA Board Secretary

**Sent:** Wednesday, February 17, 2021 9:08 AM

**To:** VTA Board of Directors

**Subject:** UPDATED VTA Information: February 19, 2021 Board of Directors Workshop Agenda Packet and February 18th Standing Committee Agenda Packets

### **VTA Board of Directors:**

The VTA Board of Directors Agenda packet for the **Friday, February 19, 2021, Workshop Meeting** has been updated to include the presentation for **Agenda Item #3.1.,** Next Generation High Capacity Transit Study. You may view the updated packet on our [agenda portal](#).

Also, the VTA **February 18<sup>th</sup>** Standing Committee agenda packets have been updated to include the following:

- a. Draft 2016 Measure B 10-year Program Principles & Project Selection Criteria - Presentation (AF #10, CMPP #11 and SSPTO #10)
- b. Committee Staff Report for CMPP Agenda Item #14
- c. Advisory Committee Comments for SSTPO (see attached)

Please click on the links below to view the updated outline and/or agenda packet for the Standing Committees .

- **Congestion Management Program and Planning (CMPP) Committee** – Thursday, February 18, 2021 at 10:00 a.m. – [CMPP Agenda Packet](#)
- **Administration and Finance (A&F) Committee** – Thursday, February 18, 2021 at 12:00 p.m. – [A&F Agenda Packet](#)
- **Safety, Security, and Transit Planning & Operations (SSTPO) Committee** – Thursday, February 18, 2021, at 2:00 p.m. – [SSTPO Agenda Packet](#)

Board Members will receive a unique “Panelist” link via email from VTA Board Secretary. The email will provide instructions on how to join the meeting.

Thank you,

Office of the Board Secretary  
Santa Clara Valley Transportation Authority  
3331 North First Street, Building B  
San Jose, CA 95134-1927  
Phone [408-321-5680](tel:408-321-5680)



**From:** VTA Board Secretary

**Sent:** Wednesday, February 17, 2021 2:36 PM

**To:** VTA Board of Directors; VTA Advisory Committee Members

**Subject:** From VTA: Letter of support from Campbell Mayor - 2016 Measure B

**VTA Board of Directors and Policy Advisory Committee Members:**

Please see attached letter from City of Campbell Mayor Liz Gibbons regarding 2016 Measure B.

Thank you.

Office of the Board Secretary  
Santa Clara Valley Transportation Authority  
3331 North First Street, Building B  
San Jose, CA 95134-1927  
Phone [408-321-5680](tel:408-321-5680)



Conserve paper. Think before you print.





---

**CITY OF CAMPBELL**  
Mayor's Office

February 2, 2021

Office of the Board Secretary  
Santa Clara Valley Transportation Authority  
3331 North First Street  
San Jose, California 95134-1906

Dear Santa Clara Valley Transportation Authority Board of Directors:

On behalf of City of Campbell, I write to express the City's support for a 2016 Measure B 10-Year Outlook that meets transportation needs countywide and provides fairness in funding countywide.

In fall 2020, the City was concerned with VTA's initial 2016 Measure B 10-Year Outlook Base Scenario. The City was therefore pleased to see a second 10-Year Outlook, as presented to the Board of Directors most recently at its workshop on January 22.

It is crucial that VTA stay on track with a proposal that is consistent with the most recent 10-Year Outlook to ensure the transportation needs of the entire County are served fairly and that the will of voters is respected. In 2016, voters countywide approved Measure B, a one-half cent sales tax measure to improve road conditions and provide congestion relief countywide. It is therefore key that the 10-Year Outlook balance investments over the ten-year period among all nine program areas consistent with the measure as approved by the voters.

This balanced approach would avoid and/or minimize reductions in the annual formula programs, which include important investments in Local Streets and Roads, and maintain progress for the capital projects in the other programs that are already underway. This approach ensures countywide benefits as promised in the 2016 ballot measure and respects the will of the voters in approving the measure.

Thank you for your consideration.

Elizabeth "Liz" Gibbons, Mayor

**From:** VTA Board Secretary  
**Sent:** Wednesday, February 17, 2021 3:15 PM  
**To:** VTA Board of Directors; VTA Advisory Committee Members  
**Subject:** From VTA: Gilroy Transit Center TOD Community Meetings 2/18 and 2/24

**VTA Board of Directors and Advisory Committee Members:**

Santa Clara Valley Transportation Authority is holding two community meetings regarding a proposed Transit-Oriented Development (TOD) at VTA’s Gilroy Transit Center. The property is located next to the Gilroy Caltrain Station, on Monterey Highway and 7<sup>th</sup> Street in Gilroy. VTA is considering a project that could provide additional affordable housing in the area. The first community meeting will be held on **February 18, 2021 at 6:00 pm** and will be repeated in **Spanish on February 24, 2021 at 6:00 pm**.

VTA staff are engaging the Gilroy community, city council, and city staff in this effort. For more information about the community meeting please see the attached community meeting notice. The specific Zoom/YouTube links to these meetings are noted below. Visit [www.vta.org/gilroydevelopment](http://www.vta.org/gilroydevelopment) for additional project information and to sign up for project update.

| <b>Community Meeting – English • February 18, 2021 – 6:00 pm</b>  | <b>Community Meeting – Spanish • February 24, 2021 – 6:00 pm</b>   |
|---|--|
| <p>You can join us directly on Zoom at:<br/> <a href="https://us02web.zoom.us/j/84560558410?pwd=WVZOM1J1bERzTjZXUzNTaHJc citoQT09">https://us02web.zoom.us/j/84560558410?pwd=WVZOM1J1bERzTjZXUzNTaHJc citoQT09</a><br/>           Passcode: 581225</p> <p>Or One tap mobile:<br/>           +16692192599,,84560558410#,,,,*581225#<br/>           Or Dial by your location: 1-669-219-2599<br/>           Meeting ID: 845 6055 8410</p> <p>To view the livestream, without participating, you can watch this meeting on YouTube:<br/> <a href="https://youtu.be/xjQVP-cq-WA">https://youtu.be/xjQVP-cq-WA</a></p> | <p>You can join up directly on Zoom at:<br/> <a href="https://us02web.zoom.us/j/88447019656pwd=YkY2RHRiL0Ure llyNnhWak1K SnpPUT09">https://us02web.zoom.us/j/88447019656pwd=YkY2RHRiL0Ure llyNnhWak1K SnpPUT09</a><br/>           Passcode: 478481</p> <p>Or One tap mobile:<br/>           +16692192599,,88447019656#,,,,*478481#<br/>           Or Dial by your location: 1-669-219-2599<br/>           Meeting ID: 884 4701 9656</p> <p>To view the livestream, without participating, you can watch this meeting on YouTube: <a href="https://youtu.be/aTUygv34al4">https://youtu.be/aTUygv34al4</a></p> |

Should you have any questions, please reply to this email.

Thank you.

Office of the Board Secretary  
 Santa Clara Valley Transportation Authority  
 3331 North First Street, Building B  
 San Jose, CA 95134-1927  
 Phone **408-321-5680**



Conserve paper. Think before you print.

# Online Community Meeting Gilroy Transit Center Transit Oriented Development


**February 18 and 24, 2021**

**Zoom video and teleconference links for both meetings  
are provided at the end of this notice.**

The Santa Clara Valley Transportation Authority (VTA) would like to invite you to a community meeting about a proposed Transit-Oriented Development (TOD) located at VTA's Gilroy Transit Center. The property is located next to the Gilroy Caltrain Station, on Monterey Highway and 7th Street in Gilroy. VTA is considering a TOD project that could provide additional affordable housing in the area.

This meeting will provide you with an opportunity to learn about VTA's TOD program. VTA wants to hear from you and is very interested in your ideas and feedback for this site and encourages your participation at this meeting.

This meeting will be held in English on February 18, and then will be repeated in Spanish on February 24, 2021. Individuals who require other language translation are requested to contact VTA Community Outreach at (408) 321-7575/TTY (408) 321-2330, or email [community.outreach@vta.org](mailto:community.outreach@vta.org), by February 11, 2021. Visit [www.vta.org/gilroydevelopment](http://www.vta.org/gilroydevelopment) for additional project information and to sign up for project updates.

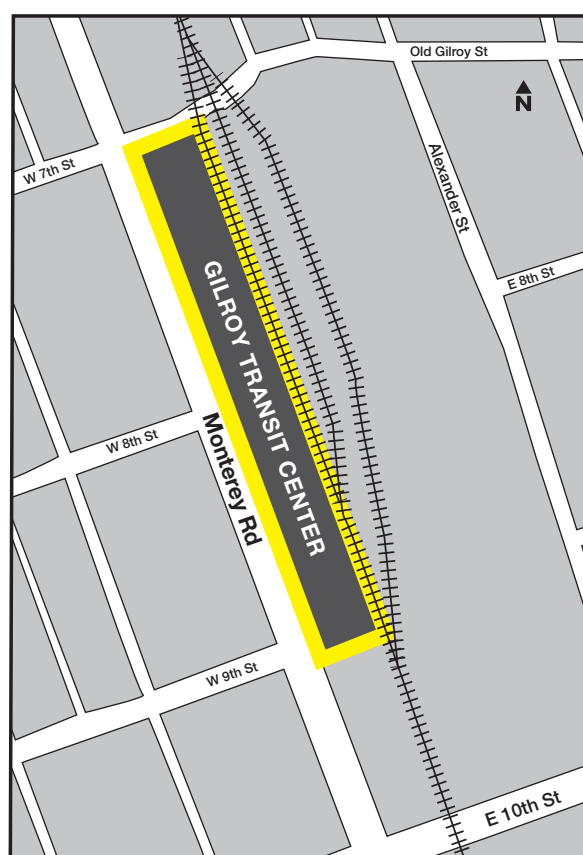

See below how to participate, RSVP (encouraged, but not mandatory) and more information.

**Community Meeting – English • 2/18/21, 6:00 p.m.**

[gilroy-tod-community-meeting.eventbrite.com](https://gilroy-tod-community-meeting.eventbrite.com)

**Community Meeting – Spanish • 2/24/21, 6:00 p.m.**

[reunion-comunitaria-gilroy-tod.eventbrite.com](https://reunion-comunitaria-gilroy-tod.eventbrite.com)

## Community Meeting

**Community Meeting – English**

**2/18/21 6:00 p.m.**

**Community Meeting – Spanish**

**2/24/21 6:00 p.m.**

# Reunión Comunitaria en línea Centro de transbordos Gilroy Transit Center Construcción Orientada al Transporte Público

**24 de febrero de 2021: español**

**Los enlaces de video y teleconferencia de Zoom para ambas reuniones se proporcionan al final de este aviso.**

Santa Clara Valley Transportation Authority (VTA) desea invitarlo a una reunión comunitaria sobre un Proyecto de Construcción Orientada al Transporte Público (TOD) ubicado en el centro de trasbordos Gilroy Transit Center perteneciente a VTA. La propiedad se localiza junto a la estación Gilroy de Caltrain, entre Monterey Highway y 7th Street en Gilroy. VTA está considerando un proyecto TOD que podría proporcionar viviendas asequibles adicionales en el área.

Esta reunión le brindará la oportunidad de informarse sobre el programa TOD de VTA. VTA quiere escucharlo y estamos muy interesados en sus ideas y comentarios para este lugar y lo invitamos a participar en esta reunión.

La reunión se llevará a cabo en inglés el 18 de febrero y luego se repetirá en español el 24 de febrero de 2021. Se solicita a las personas que necesiten traducción en otro idioma que se comuniquen con la oficina de Alcance a la Comunidad de VTA, llamando al (408) 321-7575 / TTY (408) 321 -2330, o enviando un correo electrónico a [community.outreach@vta.org](mailto:community.outreach@vta.org), antes del 11 de febrero de 2021. Visite: [www.vta.org/gilroydevelopment](http://www.vta.org/gilroydevelopment) para obtener información adicional sobre el proyecto y registrarse para recibir actualizaciones del proyecto.

A continuación puede ver la manera sobre cómo participar, confirmar su asistencia (se recomienda, pero no es obligatorio) y más información.

**Reunión Comunitaria – Inglés • 2/18/21, 6:00 p.m.**

*[gilroy-tod-community-meeting.eventbrite.com](http://gilroy-tod-community-meeting.eventbrite.com)*

**Reunión Comunitaria – Español • 2/24/21, 6:00 p.m.**

*[reunion-comunitaria-gilroy-tod.eventbrite.com](http://reunion-comunitaria-gilroy-tod.eventbrite.com)*

**From:** VTA Board Secretary

**Sent:** Thursday, February 18, 2021 5:35 PM

**To:** VTA Board of Directors

**Subject:** Updated Feb. 19, 2021 Board of Directors Workshop Meeting and Orientation agenda packet

**Board of Directors:**

The February 19, 2021 Board of Directors Workshop Meeting and Orientation agenda packet has been updated on our agenda [portal](#) to include the following:

Agenda Item #2 Public Comment - Matt Kennedy

Agenda Item 3.1 Public Comment - Zachary Zelif

Thank you,

***Office of the Board Secretary***

Santa Clara Valley Transportation Authority

3331 North First Street, Building B

San Jose, CA 95134-1927

Phone [408-321-5680](tel:408-321-5680)



**From:** VTA Board Secretary  
**Sent:** Friday, February 19, 2021 1:44 PM  
**To:** VTA Board of Directors; VTA Advisory Committee Members  
**Subject:** UPDATE: From VTA: Gilroy Transit Center TOD Community Meetings 2/18 and 2/24

**VTA Board of Directors and Advisory Committee Members:**

Please note the updated link for the February 24 community meeting (in Spanish) below. Kindly disregard the erroneous link sent previously.

Thank you.



**From:** VTA Board Secretary  
**Sent:** Wednesday, February 17, 2021 3:15 PM  
**To:** VTA Board of Directors; VTA Advisory Committee Members  
**Subject:** From VTA: Gilroy Transit Center TOD Community Meetings 2/18 and 2/24

**VTA Board of Directors and Advisory Committee Members:**

Santa Clara Valley Transportation Authority is holding two community meetings regarding a proposed Transit-Oriented Development (TOD) at VTA's Gilroy Transit Center. The property is located next to the Gilroy Caltrain Station, on Monterey Highway and 7<sup>th</sup> Street in Gilroy. VTA is considering a project that could provide additional affordable housing in the area. The first community meeting will be held on **February 18, 2021 at 6:00 pm** and will be repeated in **Spanish on February 24, 2021 at 6:00 pm**.

VTA staff are engaging the Gilroy community, city council, and city staff in this effort. For more information about the community meeting please see the attached community meeting notice. The specific Zoom/YouTube links to these meetings are noted below. Visit [www.vta.org/gilroydevelopment](http://www.vta.org/gilroydevelopment) for additional project information and to sign up for project update.

| <b>Community Meeting – English • February 18, 2021 – 6:00 pm</b>  | <b>Community Meeting – Spanish • February 24, 2021 – 6:00 pm</b>  |
|---|---|
| You can join us directly on Zoom at:<br><a href="https://us02web.zoom.us/j/84560558410?pwd=VWZOM1J1bERzTjZXUzNTaHJJcitoQT09">https://us02web.zoom.us/j/84560558410?pwd=VWZOM1J1bERzTjZXUzNTaHJJcitoQT09</a><br>Passcode: 581225 | You can join up directly on Zoom at:<br><a href="https://us02web.zoom.us/j/88447019656?pwd=YkY2RHRIL0UrelyNnhWak1K5npPUT09">https://us02web.zoom.us/j/88447019656?pwd=YkY2RHRIL0UrelyNnhWak1K5npPUT09</a><br>Passcode: 478481 |

Or One tap mobile:  
+16692192599,,84560558410#,,,,\*581225#  
Or Dial by your location: 1-669-219-2599  
Meeting ID: 845 6055 8410

To view the livestream, without participating,  
you can watch this meeting on YouTube:  
<https://youtu.be/xjQVP-cq-WA>

Or One tap mobile:  
+16692192599,,88447019656#,,,,\*478481#  
Or Dial by your location: 1-669-219-2599  
Meeting ID: 884 4701 9656

To view the livestream, without  
participating, you can watch this meeting  
on YouTube:  
<https://youtu.be/aTUygv34aI4>

Should you have any questions, please reply to this email.

Thank you.

Office of the Board Secretary  
Santa Clara Valley Transportation Authority  
3331 North First Street, Building B  
San Jose, CA 95134-1927  
Phone **408-321-5680**



Conserve paper. Think before you print.



**From:** VTA Board Secretary

**Sent:** Friday, February 19, 2021 2:47 PM

**To:** VTA Board of Directors

**Subject:** Additional updates on 20/19/2021 Board of Directors Workshop agenda packet

**Board of Directors:**

Additional updates to the 2/19/2021 Board of Directors Workshop Meeting agenda packet are posted on the agenda [portal](#):

- Item #2          Blair Beekman Public Comment
- Item #3.1       Blair Beekman Public Comment
- Item #3.1       Roland Lebrun Public Comment

Thank you,

***Office of the Board Secretary***

Santa Clara Valley Transportation Authority

3331 North First Street, Building B

San Jose, CA 95134-1927

Phone **408-321-5680**

